

U. S. DEPARTMENT OF TRANSPORTATION  
FEDERAL HIGHWAY ADMINISTRATION



PLANS FOR PROPOSED PROJECT

AK DEN 2009(8)

MANOKOTAK HEIGHTS  
ROAD RECONSTRUCTION

MANOKOTAK, ALASKA  
DILLINGHAM CENSUS AREA

SCHEDULE A: 4.347 MILES  
SCHEDULE B: 3.655 MILES  
SCHEDULE C: 2.140 MILES

As-Built

As-Built



ALASKA KEY MAP

**TYPE OF CONSTRUCTION:**  
Grading, drainage, aggregate surfacing,  
aggregate stabilization, fencing, and lighting.

**DESIGN DESIGNATION:**  
ADT (2010) 225  
V 25 MPH  
e (max) N/A

**SPECIFICATION:**  
Standard Specifications for Construction  
of Roads and Bridges on Federal Highway  
Projects, FP-03 US Customary Units




U.S. DEPARTMENT OF TRANSPORTATION  
FEDERAL HIGHWAY ADMINISTRATION  
WESTERN FEDERAL LANDS HIGHWAY DIVISION  
VANCOUVER, WASHINGTON



ROBERT PECCIA AND ASSOCIATES  
HELENA, MONTANA

PROJECT MANAGER  
T. LONERGAN

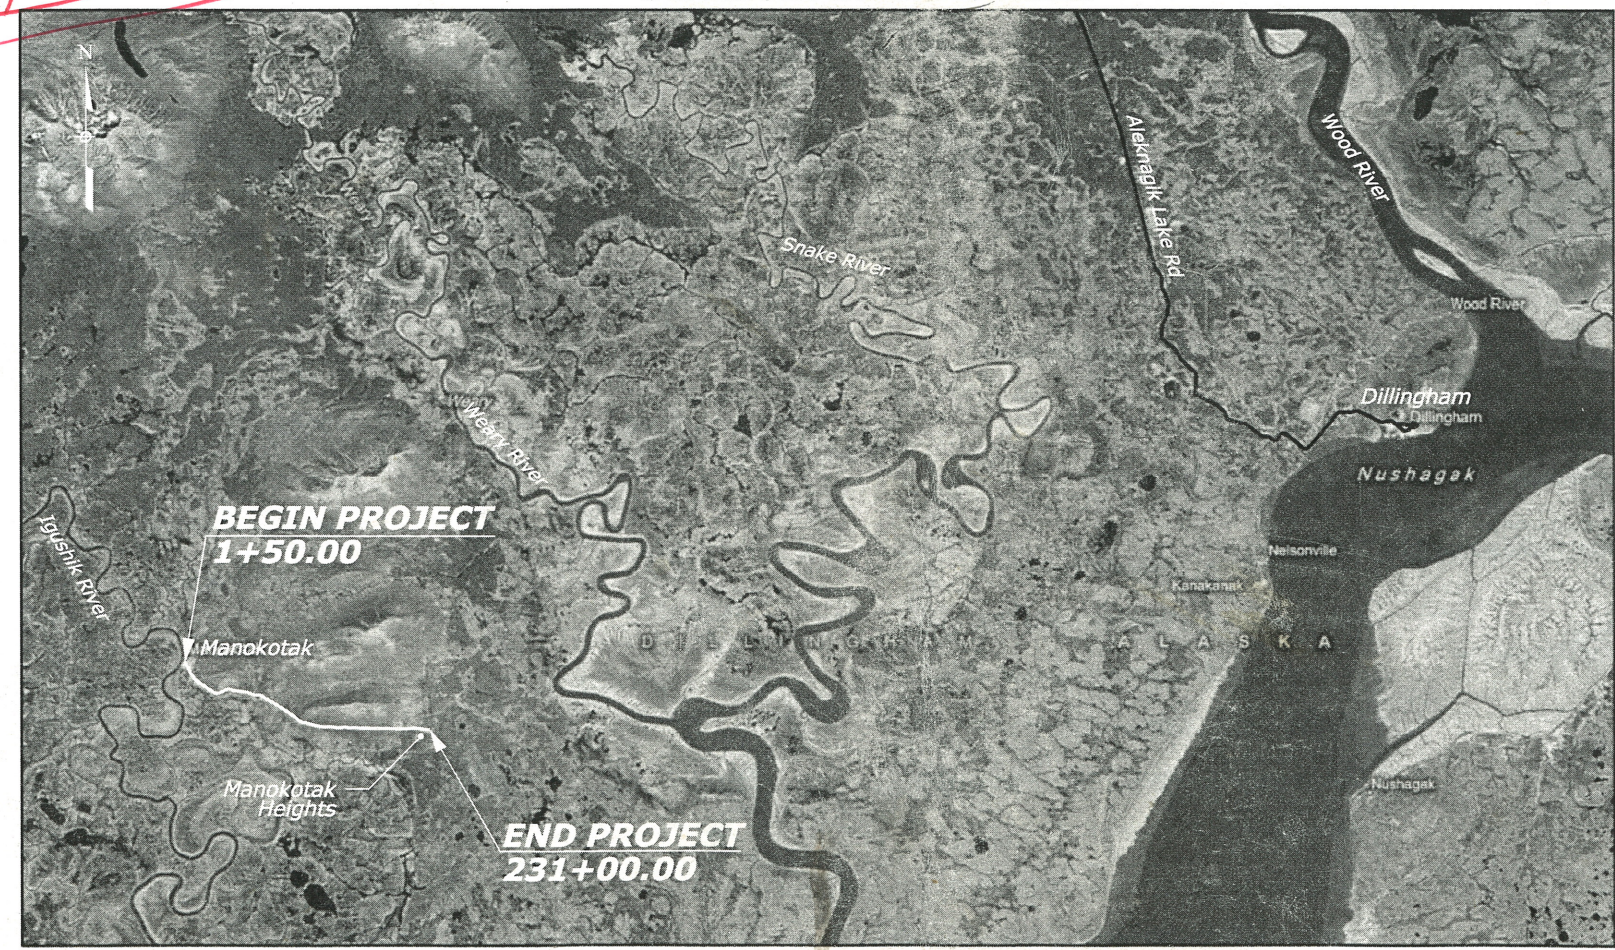

INDEX TO SHEETS

<b>A. GENERAL INFORMATION</b>	
A.1	TITLE SHEET
A.2	PLAN SYMBOLS AND ABBREVIATIONS
A.3	VICINITY MAP
<b>B. SUMMARY OF QUANTITIES</b>	
B.1-6	SUMMARY OF QUANTITIES
<b>C. TYPICAL SECTION</b>	
C.1	TABULATION OF TYPICAL SECTION QUANTITIES
C.2	TYPICAL SECTION
C.3	SUBEXCAVATION AND EMBANKMENT CONSTRUCTION DETAILS
<b>D. PLAN AND PROFILES</b>	
D.1	TABULATION OF PLAN AND PROFILE QUANTITIES
D.2-9	PLAN AND PROFILES
<b>E. APPROACH ROADS</b>	
E.1	TABULATION OF APPROACH QUANTITIES
E.2-3	APPROACH PLAN AND PROFILES
E.4-5	APPROACH ROAD DETAILS
<b>F. EROSION CONTROL</b>	
F.1	TABULATION OF EROSION CONTROL QUANTITIES
F.2-5	EROSION CONTROL PLANS
F.6	SEDIMENT WATTLES AT CULVERTS
F.7	TEMPORARY DIVERSION CHANNELS
F.8	SEDIMENT TRAPS
F.9	SEDIMENT WATTLE
<b>G. DRAINAGE</b>	
G.1-2	TABULATION OF DRAINAGE QUANTITIES
G.3	76+08 BEAVER CREEK CULVERT DETAIL
G.4	ENERGY DISSIPATOR AND RIPRAP DITCH DETAILS
G.5	RIPPRAP HEADWALL AND PIPE END TREATMENT DETAILS
G.6	SIMULATED STREAM CULVERT INTERIOR TREATMENT
G.7	STANDARD UNDERDRAIN SYSTEM DETAIL
G.8-12	STANDARD DRAWINGS
<b>H. MISCELLANEOUS</b>	
H.1	ROADWAY OBLITERATION DETAILS
H.2-3	LIGHTING SYSTEM INSTALLATION DETAILS
H.4-5	CHAIN LINK FENCE DETAILS
<b>I. TEMPORARY TRAFFIC CONTROL PLAN</b>	
I.1	TABULATION OF TEMPORARY TRAFFIC CONTROL QUANTITIES
I.2-5	STANDARD DRAWINGS
<b>J. PERMANENT TRAFFIC CONTROL PLAN</b>	
J.1	TABULATION OF PERMANENT TRAFFIC CONTROL QUANTITIES
J.2-5	SIGNING PLANS
J.6	PERMANENT SIGN DETAILS
J.7	PERMANENT SIGN INSTALLATION WOOD POSTS

**APPROVED:**  
/s/Brent L. Coe  
Acting Director, Project Delivery,  
Western Federal Lands Highway Division  
DATE 8/30/2012

7/2012  
B. Wacker  
Checked by:  
7/2012  
K. Belf  
Designed by:  
06-Sep-2012 02:34 PM  
... \dc0908ae.dgn



$\Delta$	total central angle
$\Delta c$	curve central angle
$\emptyset$	diameter
$\emptyset s$	spiral central angle
abut.	abutment
ADT	average daily traffic
AH	ahead
appr.	approach
BK	back
BM	bench mark
BP	balance point
br.	bridge
brg.	bearing
cc or c. to c.	center to center
$\epsilon$	centerline
clr.	clear
CMP	corrugated metal pipe
col.	column
conc.	concrete
conn.	connection
constr. jt.	construction joint
cont.	continuous
CS	point of curve to spiral
ctrs.	centers
CUFT	cubic foot (feet)
culv.	culvert
CUYD	cubic yard(s)
D	diameter
DHV	design hourly volume
dia.	diameter
diag.	diagonal
diaph.	diaphragm
dist.	distance
drwg(s).	drawing(s)
E	east
e	superelevation rate
El. 94.16 ft	elevation with number
elev.	elevation
emb.	embankment
EP	edge of pavement
EQ or eq.	equation
ER	edge of road
EW	edge of water
exc.	excavation
exp. jt.	expansion joint
fin.	finish
flg.	flange
ft2	square foot
ft3	cubic foot (feet)
ftg.	footing
ga.	gage (gauge)
galv.	galvanized
hdwl.	headwall
hex.	hexagon
HW	high water
ID	inside diameter
jt.	joint
L	length of curve
lam.	lamination
lat.	latitude
LNFT	linear foot (feet)
long.	longitudinal
LPSM	lump sum
Ls	length of spiral
lt. or LT	left
LW	low water

M.L.	main line
M.P.	mile post
matl.	material
max.	maximum
MGAL	thousand gallon
min.	minimum
mon.	monument
N	north
NC	normal crown
o. c.	on center
o. to o.	out to out
OD	outside diameter
OG	original ground
PC	point of curve
PCC	point of compound curve
PCS	point of curve to spiral
PI	point of intersection
pl.	plate
POC	point on curve
POS	point on spiral
POT	point on tangent
PS	point of tangent to spiral
PSC	point of spiral to curve
PST	point of spiral to tangent
PT	point of tangent
pvm.	pavement
R	radius
R.	range
R/W	right-of-way
rdwy.	roadway
reinf.	reinforcement
reqd.	required
rt. or RT	right
rte.	route
S	south
SADT	seasonal average daily traffic
SC	point of spiral to curve
sec.	section
shldr.	shoulder
SLRY	slurry unit
spa.	spacing, spaces or spaced
SQFT	square foot
SQYD	square yard
SRS	point of spiral to reverse spiral
SS	point of spiral to spiral (no curve)
ST	point of spiral to tangent
STA, Sta.	station
std.	standard
stgr.	stringer
stiff.	stiffener
struc.	structural
STS	point of spiral to tangent spiral
sym.	symmetrical
T	tangent distance
T.	township
TBM	temporary bench mark
thd.	thread
TS	point of tangent to spiral
Ts	tangent distance (spiraed curve)
typ.	typical
V	design speed
vph	vehicles per hour
VPI	vertical point of intersection
W	west
yd2	square yard
yd3	cubic yard(s)

National Boundary

State Boundary

County Boundary

City Boundary

Township or Range Line

Section Line

Section Corner (Found, Projected)

$\frac{1}{4}$  Section Line

$\frac{1}{4}$  Section Corner (Found, Projected)

$\frac{1}{16}$  Section Line

$\frac{1}{16}$  Section Corner (Found, Projected)

Property Line w/Found Property Corner

Parcel Number

National Park Boundary

National Forest Boundary

National Wildlife Refuge Boundary

BLM Lands Boundary

Indian Reservation Boundary

Existing Roadway (Road, Paved, Gravel)

Railroad

Trail

Wattle

Silt Fence

Intermittent Drainage or Small Creek

Large Creek or River

Lake, Pond or Reservoir; Marshland

Spring or Seep

Treeline; Individual Trees

Material Source; Bore Hole; Test Pit

Spot Elevation; Coordinate Grid Tick

Above Ground Tank; Underground Tank


Boulder; Well; Satellite Dish; Grave

Cooking Grate; Garbage Can; Picnic Table

Flagpole; Fire Hydrant

Gas & Water Meter; Gas & Water Valve

Control Point (Terrestrial and GPS); Jump Hub

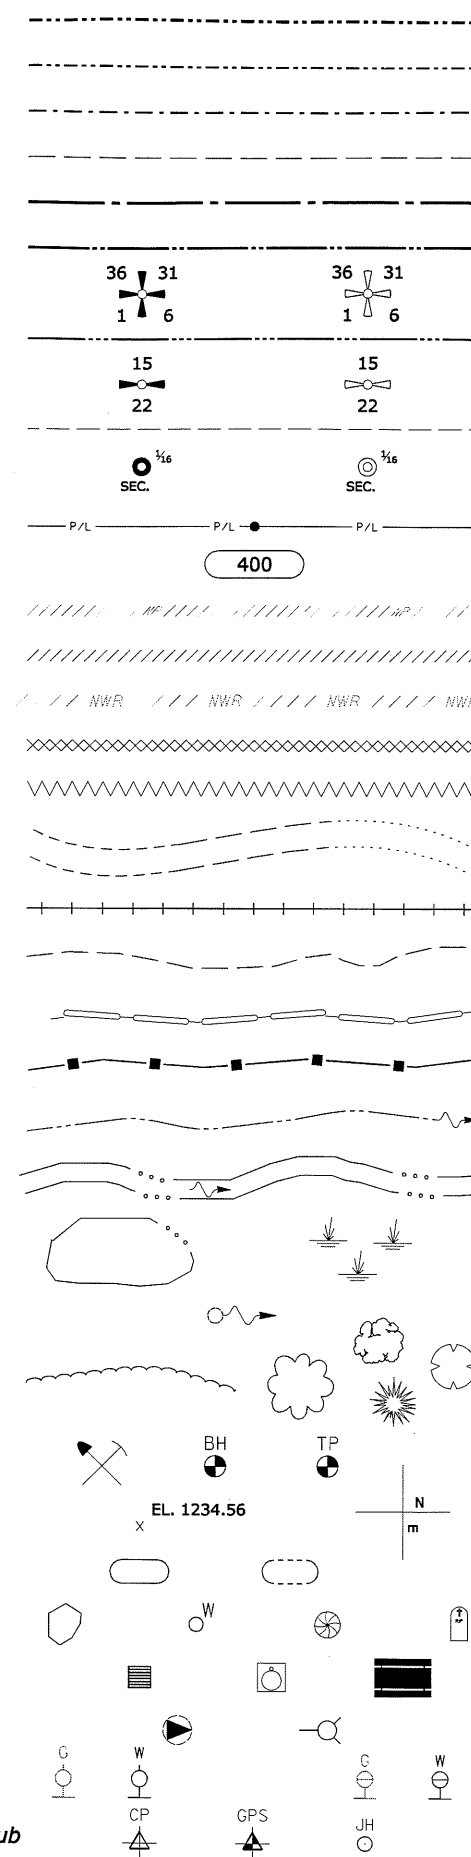

North Arrow



STATE	PROJECT	SHEET NUMBER
AK	DEN 2009(8)	A.2

	EXISTING	PROPOSED
Slope Stake Limits	Top of Cut Toe of Fill Transition	
Fence	X-X-X-X	XX XX XX XX
Gate with Fence	X-X-X-X-X	XX XX XX XX XX
Cattleguard		
Guardrail		
Concrete Barrier		
Retaining Wall		
Signs (single, double post; portable)		
Delineators		
Pipe Culvert (arrow shows flow)		
Pipe Culvert with End Section		
Pipe Culvert with Headwall		
Pipe Culvert with Drop Inlet		
Box Culvert		
Underdrain		
Overhead/Above Ground Utilities		
Underground Utilities		
Poles (Power, Telephone, Joint Use, Light, Support w/Anchor)		
Miscellaneous Utility Features		
Building		
Right-of-Way Line with Monument		
Permanent Easement		
Construction Easement	- no symbol -	
Riprap		

FM = force main, FO = fiber optic, G = gas, IRR = irrigation, O = oil, P = power, SA = sanitary sewer, SD = storm drain, SS = storm sewer, STEAM = steam, T = telephone, TV = CATV, W = water

EM = electric meter, T = telephone pedestal, TV = CATV pedestal, UP = transformer or junction box, WF = water fountain

NO SCALE

U.S. DEPARTMENT OF TRANSPORTATION  
FEDERAL HIGHWAY ADMINISTRATION  
WESTERN FEDERAL LANDS HIGHWAY DIVISION

U.S. CUSTOMARY DETAIL

**PLAN SYMBOLS  
AND ABBREVIATIONS**

DETAIL APPROVED FOR USE 11/2001  
REVISED: 9/2005 1/2007 10/2009

DETAIL  
W101-1

# NOTE:

- Other symbols used in the plans will be shown in a legend on the appropriate plan sheet.



7/2012 7/2012 7/2012 15-Jul-2012 12:56 PM ...\\dc0008ac.dgn


B. Wacker

Checked by:

N. Bell

Designed by:

STATE	PROJECT	SHEET NUMBER
AK	DEN 2009(8)	A.3

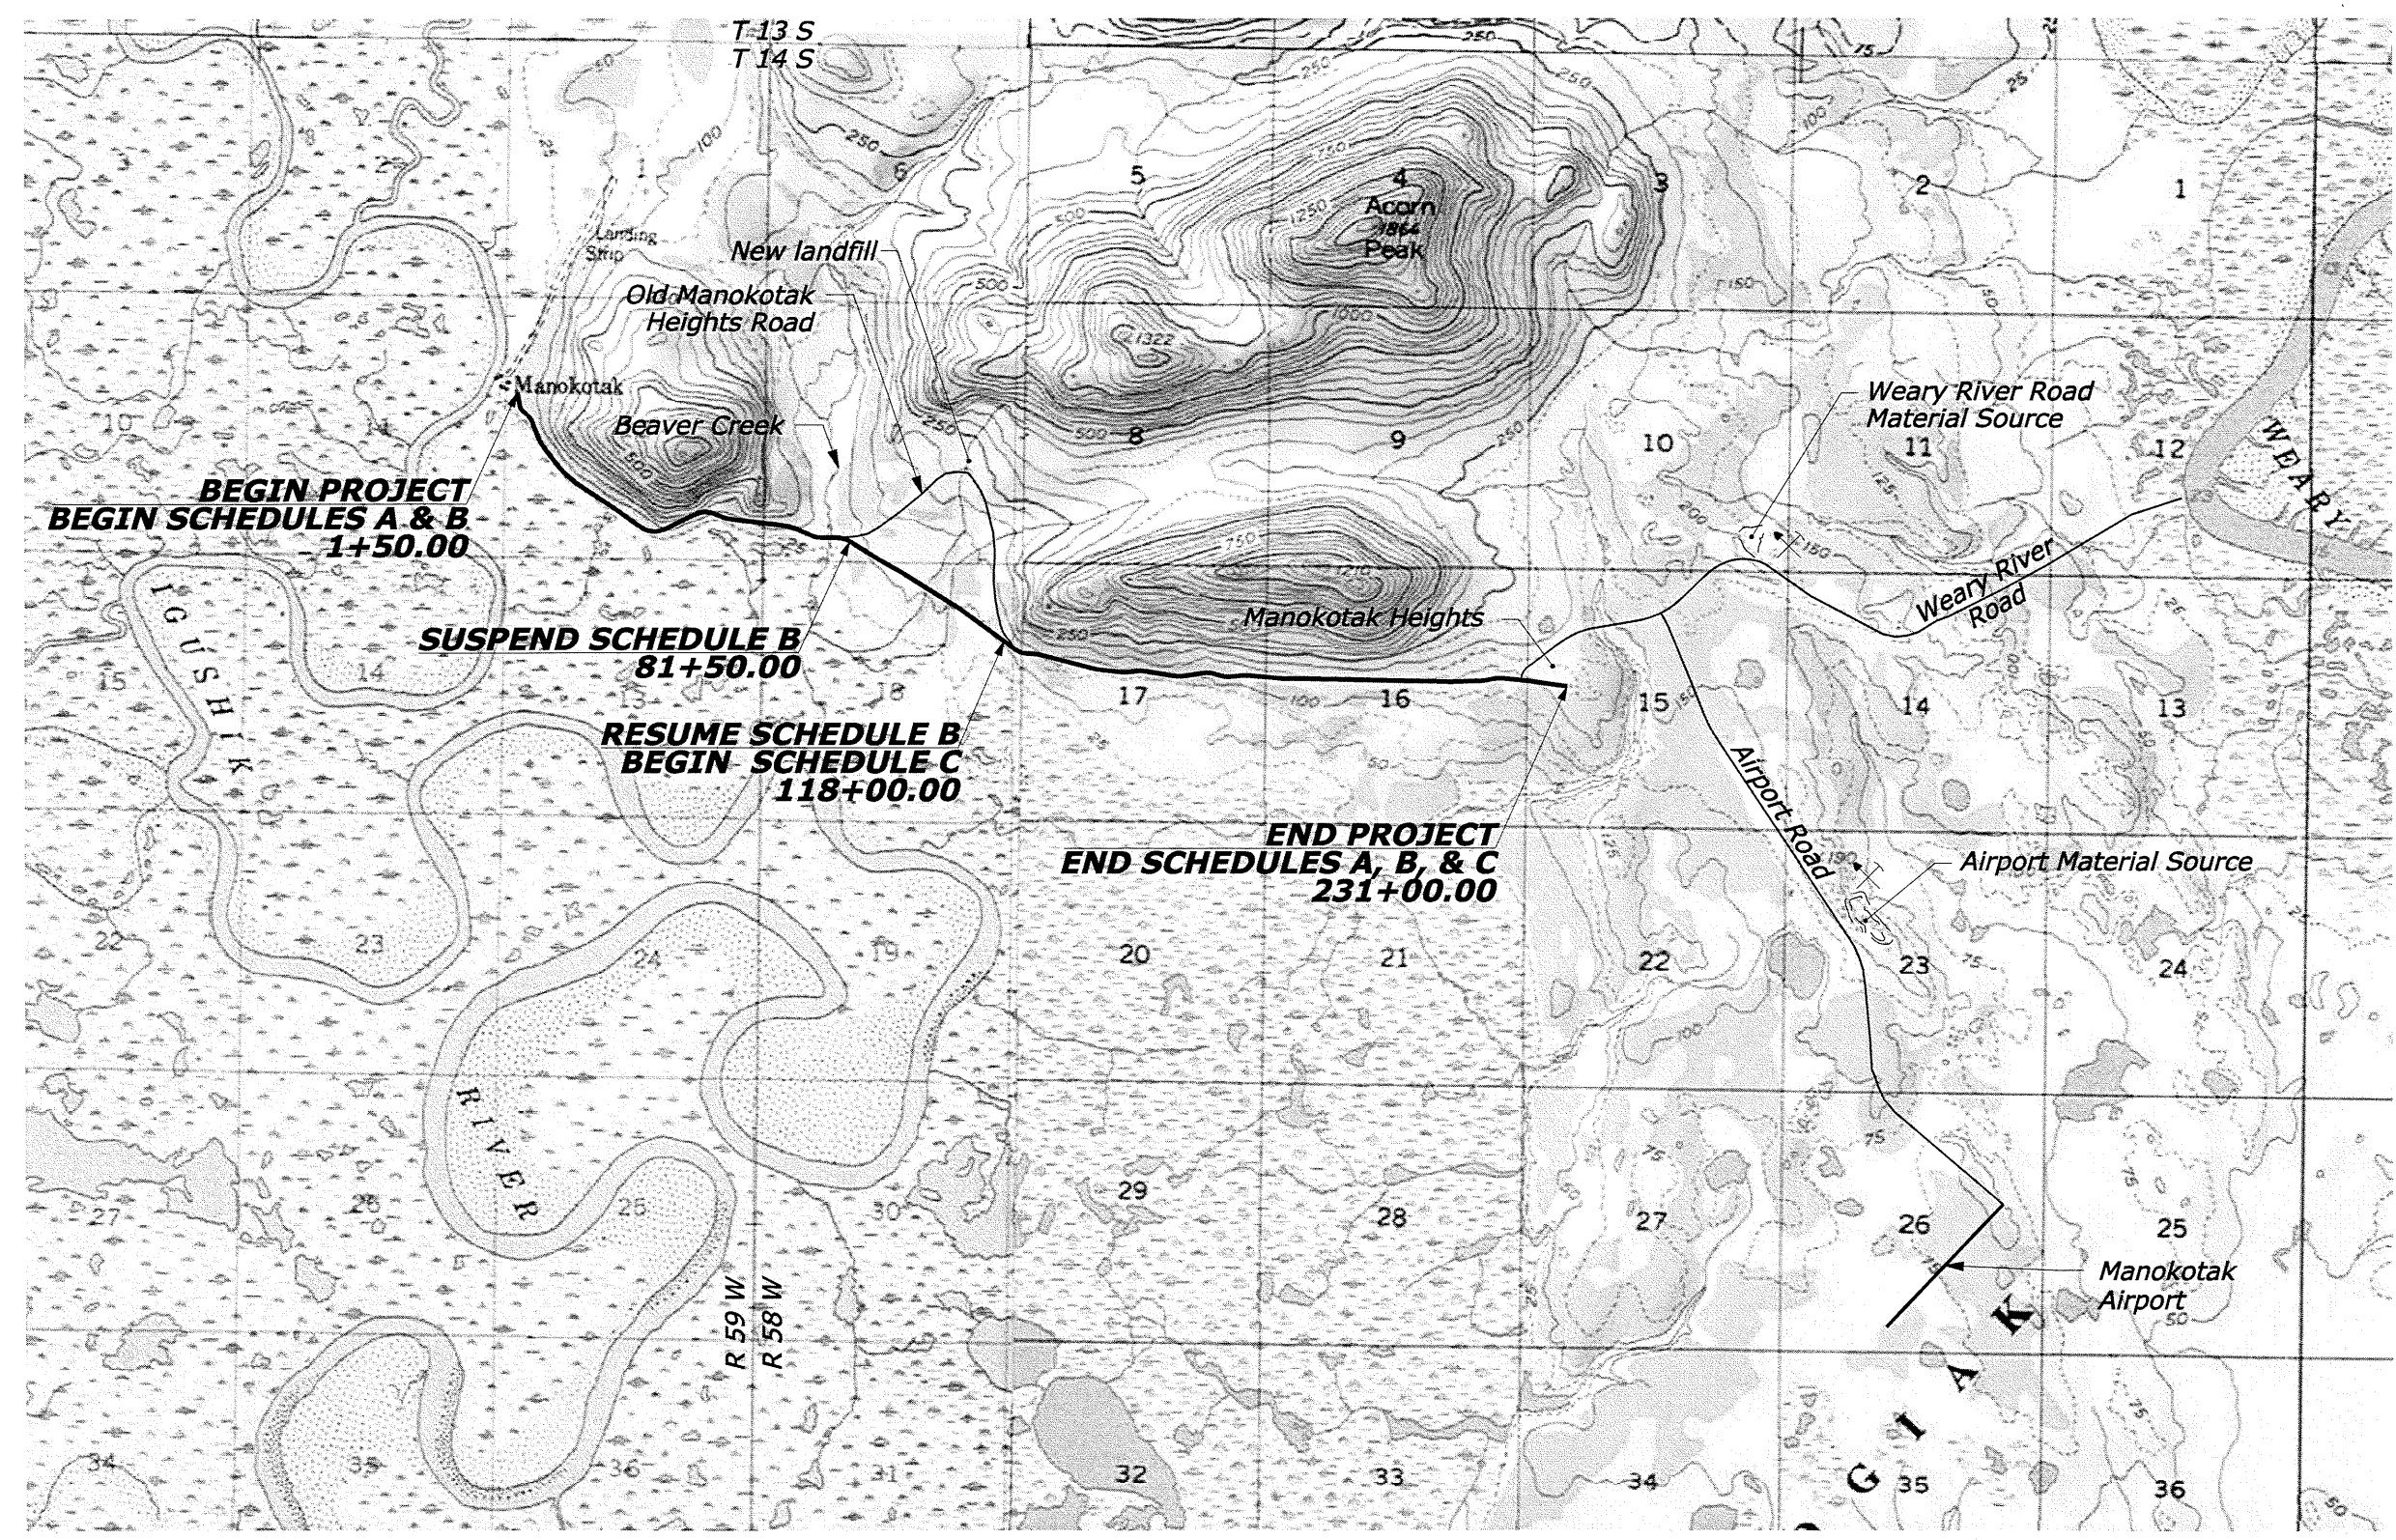

VICINITY MAP



C:\MyFiles\Projects\AK\DEN 2009(8) Manokotak Heights Road Repairs\Sheets\_B\dc0908-B- 7-Sep-2012 3:36 PM Designed by: N. Bell 7/2012 Checked by: B. Wacker 7/2012

STATE	PROJECT	SHEET NUMBER
AK	DEN 2009(8)	B.1

SUMMARY OF QUANTITIES - SCHEDULE A

PLAN SHEET SECTION ----->>			SECTION C TYPICAL SECTION	SECTION D PLAN AND PROFILE	SECTION E APPROACH ROADS	SECTION F EROSION CONTROL	SECTION G DRAINAGE	SECTION H MISC- ELLANEOUS	SECTION I TEMPORARY TRAFFIC CONTROL	SECTION J PERMANENT TRAFFIC CONTROL							ESTIMATED QUANTITIES	
ITEM	DESCRIPTION	UNIT															PLAN	BID SCHEDULE
15101-0000	MOBILIZATION	LPSM															ALL	ALL
15201-0000	CONSTRUCTION SURVEY AND STAKING	LPSM															ALL	ALL
15301-0010	CONTRACTOR QUALITY CONTROL AND ASSURANCE	LPSM															ALL	ALL
15401-0000	CONTRACTOR TESTING	LPSM															ALL	ALL
15501-0000	CONSTRUCTION SCHEDULE	LPSM															ALL	ALL
15703-1000	SOIL EROSION CONTROL, SOIL STABILIZATION , MULCHING	ACRE				22.51											22.51	23.00
15705-1300	SOIL EROSION CONTROL, TEMPORARY DIVERSION CHANNEL	LNFT				900											900	1,000
15705-1500	SOIL EROSION CONTROL, SEDIMENT WATTLE , GOVERNMENT-FURNISHED	LNFT				25,167											25,167	25,167
15706-0400	SOIL EROSION CONTROL, SEDIMENT TRAP	EACH				6											6	7
15801-0000	WATERING FOR DUST CONTROL	MGAL																1,700
20101-0000	CLEARING AND GRUBBING	ACRE		24.37	0.77												25.14	25.14
20301-2400	REMOVAL OF SIGN	EACH								7							7	7
20401-0000	ROADWAY EXCAVATION	CUYD		35,132	1,372												36,504	36,504
20402-0000	SUBEXCAVATION	CUYD	2,573														2,573	3,000
20410-0000	SELECT BORROW	CUYD	3,421	55,949	473												59,843	62,000
20701-0700	EARTHWORK GEOTEXTILE, TYPE II-A	SQYD	25,853														25,853	27,500
21101-2000	ROADWAY OBLITERATION, METHOD 2	SQYD		440													440	440
25101-3000	PLACED RIPRAP, CLASS 3 , RIPRAP HEADWALL	CUYD					64										64	75
25101-3000	PLACED RIPRAP, CLASS 3 , ENERGY DISSIPATOR	CUYD					14										14	20
25120-1000	RIPRAP DITCH, CLASS 1	LNFT		2,108	300												2,408	2,500
30410-3000	CALCIUM CHLORIDE AGGREGATE STABILIZATION, IMPORTED SURFACE COURSE AGGREGATE	TON	19,866														19,866	20,500
30802-2000	ROADWAY AGGREGATE, METHOD 2	TON	22,527		1,262												23,789	24,600
60201-0600	18-INCH PIPE CULVERT , GOVERNMENT-FURNISHED	LNFT					312										312	350
60201-0800	24-INCH PIPE CULVERT , GOVERNMENT-FURNISHED	LNFT					1,872										1,872	1,972
60201-1000	36-INCH PIPE CULVERT , GOVERNMENT-FURNISHED	LNFT					158										158	172
60201-2500	144-INCH PIPE CULVERT , GOVERNMENT-FURNISHED	LNFT					56										56	60

(CQ) means Contract Quantity



**B. Wacker**

7/2012	Checked by:
--------	-------------

N. Bell

Designed by:

7-Sep-2012 3:36 PM

-B-806

C:\MyFiles\Projects\AK\DEN 2009(8) Manokotak Heights Road Repairs\Sheets\_B\dc0908-B-

[illegible]



## SUMMARY OF QUANTITIES - SCHEDULE B

[illegible]

(CQ) means Contract Quantity







7/2012

B. Wacker

7/2012 Checked by:

N. Bell

Designed by:

7-Sep-2012 3:36 PM

C:\MyFiles\Projects\AK\DEN 2009\8) Manokotak Heights Road Repairs\Sheets\_B\dc0908-B-

STATE	PROJECT	SHEET NUMBER
AK	DEN 2009(8)	B.5

SUMMARY OF QUANTITIES - SCHEDULE C

PLAN SHEET SECTION ----->			SECTION C TYPICAL SECTION	SECTION D PLAN AND PROFILE	SECTION E APPROACH ROADS	SECTION F EROSION CONTROL	SECTION G DRAINAGE	SECTION H MISC- ELLANEOUS	SECTION I TEMPORARY TRAFFIC CONTROL	SECTION J PERMANENT TRAFFIC CONTROL						ESTIMATED QUANTITIES	
ITEM	DESCRIPTION	UNIT														PLAN	BID SCHEDULE
15101-0000	MOBILIZATION	LPSM														ALL	ALL
15201-0000	CONSTRUCTION SURVEY AND STAKING	LPSM														ALL	ALL
15301-0010	CONTRACTOR QUALITY CONTROL AND ASSURANCE	LPSM														ALL	ALL
15401-0000	CONTRACTOR TESTING	LPSM														ALL	ALL
15501-0000	CONSTRUCTION SCHEDULE	LPSM														ALL	ALL
15703-1000	SOIL EROSION CONTROL, SOIL STABILIZATION , MULCHING	ACRE				11.94										11.94	12.00
15705-1300	SOIL EROSION CONTROL, TEMPORARY DIVERSION CHANNEL	LNFT				642										642	700
15705-1500	SOIL EROSION CONTROL, SEDIMENT WATTLE , GOVERNMENT-FURNISHED	LNFT				11,500										11,500	12,000
15706-0400	SOIL EROSION CONTROL, SEDIMENT TRAP	EACH				4										4	5
15801-0000	WATERING FOR DUST CONTROL	MGAL															940
20101-0000	CLEARING AND GRUBBING	ACRE		12.65	0.64											13.29	13.29 (CQ)
20301-2400	REMOVAL OF SIGN	EACH								3						3	3
20401-0000	ROADWAY EXCAVATION	CUYD		20,064	1,178											21,242	21,242 (CQ)
20402-0000	SUBEXCAVATION	CUYD	2,154													2,154	2,500
20410-0000	SELECT BORROW	CUYD	2,864	29,261	420											32,545	34,000
20701-0700	EARTHWORK GEOTEXTILE, TYPE II-A	SQYD	12,449													12,449	13,500
21101-2000	ROADWAY OBLITERATION, METHOD 2	SQYD		89												89	89 (CQ)
25101-3000	PLACED RIPRAP, CLASS 3 , RIPRAP HEADWALL	CUYD					32									32	40
25101-3000	PLACED RIPRAP, CLASS 3 , ENERGY DISSIPATOR	CUYD					10									10	15
25120-1000	RIPRAP DITCH, CLASS 1	LNFT		1,051	200											1,251	1,300
30410-3000	CALCIUM CHLORIDE AGGREGATE STABILIZATION, IMPORTED SURFACE COURSE AGGREGATE	TON	9,773													9,773	10,500
30802-2000	ROADWAY AGGREGATE, METHOD 2	TON	11,056		1,087											12,143	13,000
60201-0600	18-INCH PIPE CULVERT , GOVERNMENT-FURNISHED	LNFT					246									246	270
60201-0800	24-INCH PIPE CULVERT , GOVERNMENT-FURNISHED	LNFT					1024									1024	1,100
60201-1000	36-INCH PIPE CULVERT , GOVERNMENT-FURNISHED	LNFT					98									98	110
60210-0600	END SECTION FOR 18-INCH PIPE CULVERT , GOVERNMENT-FURNISHED	EACH					12									12	12

(CQ) means Contract Quantity







TYPICAL SECTION QUANTITIES

Item Number	Description	Schedule A	Schedule B	Schedule C	Unit	Remarks
30410-3000	Calcium chloride aggregate stabilization, imported surface course aggregate	19,866.0	16,702.0	9,773.0	TON	Based on 1.97 TON/CUYD, Calcium chloride is government-furnished
30802-2000	Roadway aggregate, method 2	22,527.0	18,928.0	11,056.0	TON	Based on 1.97 TON/CUYD

EARTHWORK GEOTEXTILE QUANTITIES <sup>1/</sup>

Station to Station	Side	Width Range (LNFT)	Item 20701-0700 Earthwork geotextile, type II-A (SQYD) <sup>4/</sup>
13+00 to 14+50	RT	14 - 16	172
21+00 to 31+50	RT	14 - 25	1,947
32+50 to 34+00	RT	14 - 19	200
35+50 to 39+50	RT	14 - 24	758
42+00 to 54+00	RT	14 - 40	2,467
65+00 to 67+00	RT	14 - 15	239
74+00 to 79+50	RT	14 - 21	959
74+00 to 79+50	LT	14 - 24	1,041
81+50 to 84+50	RT	14 - 19	464
83+50 to 85+50	LT	14	233
88+50 to 93+50	LT	14 - 16	578
91+50 to 108+50	RT	14 - 19	2,268
99+50 to 101+00	LT	14	153
109+50 to 112+50	RT	14 - 16	417
113+50 to 118+00	RT	14 - 18	715
118+00 to 120+50	RT	14 - 21	416
121+00 to 123+50	LT	14 - 26	473
123+00 to 128+00	RT	14 - 29	1,051
134+00 to 137+00	RT	14 - 18	440
141+00 to 143+00	RT	14 - 18	276
144+00 to 149+00	RT	14 - 21	876
147+00 to 150+00	LT	14 - 21	460
150+50 to 154+00	RT	14 - 32	815
156+50 to 158+00	RT	14 - 21	207
161+00 to 162+00	RT	14 - 15	83
163+00 to 164+50	LT	14 - 19	156
167+00 to 168+50	RT	14 - 19	188
170+50 to 171+50	RT	14 - 17	93
180+50 to 185+00	RT	14 - 22	856
188+00 to 189+00	RT	14	78
192+50 to 193+50	RT	14	78
194+50 to 195+50	RT	14	78
199+50 to 200+50	LT	14 - 16	89
210+50 to 214+00	RT	14 - 22	596
214+00 to 216+50	LT	14 - 19	374
215+00 to 221+50	RT	14 - 27	1,010
Schedule A Total			21,304
Schedule B Total			16,476
Schedule C Total			8,693

SUBGRADE GEOTEXTILE QUANTITIES <sup>2/ 5/</sup>

Station to Station	Side	Width (LNFT)	Item 20701-0700 Earthwork geotextile, type II-A (SQYD)
4+40 to 4+50	LT	14	16
7+30 to 7+40	LT	14	16
35+00 to 35+20	LT	14	31
121+00 to 121+20	LT	14	31
128+00 to 128+20	LT	14	31
201+00 to 201+10	RT	14	16
206+75 to 206+85	RT	14	16
212+00 to 212+10	RT	14	16
213+30 to 213+40	RT	14	16
Schedule A Total			189
Schedule B Total			189
Schedule C Total			126

SUBEXCAVATION QUANTITIES <sup>1/</sup>

Station to Station	Type	Item 20402-0000 Subexcavation (CUYD)	Item 20410-0000 Select borrow <sup>3/</sup> (CUYD)	Item 20701-0700 Earthwork geotextile, type II-A (SQYD)
68+00 to 69+00	1	25	33	80
80+00 to 81+50	2	394	524	650
118+50 to 121+00	2	465	618	775
154+50 to 157+50	2	765	1,017	1,245
158+50 to 161+00	2	528	702	891
165+00 to 166+50	2	248	330	438
191+00 to 192+00	1	57	76	106
202+00 to 203+50	1	91	121	175
Schedule A Total		2,573	3,421	4,360
Schedule B Total		2,573	3,421	4,360
Schedule C Total		2,154	2,864	3,630

FOOTNOTE:

- <sup>1/</sup> See Sheet C.3 for details.  
<sup>2/</sup> See Sheet C.2 for details.  
<sup>3/</sup> Based on 1.33 compaction factor.  
<sup>4/</sup> Quantity does not account for overlap.  
<sup>5/</sup> Adjust locations for field conditions as approved by CO.

TABULATION OF TYPICAL SECTION QUANTITIES



7/2012  
7/2012  
7/2012  
13-Sep-2012 08:14 AM  
...\\Typical Sections\\tdc0908ca.dgn


B. Wacker

Checked by:

N. Bell


Designed by:

STATE	PROJECT	SHEET NUMBER
AK	DEN 2009(8)	C.2

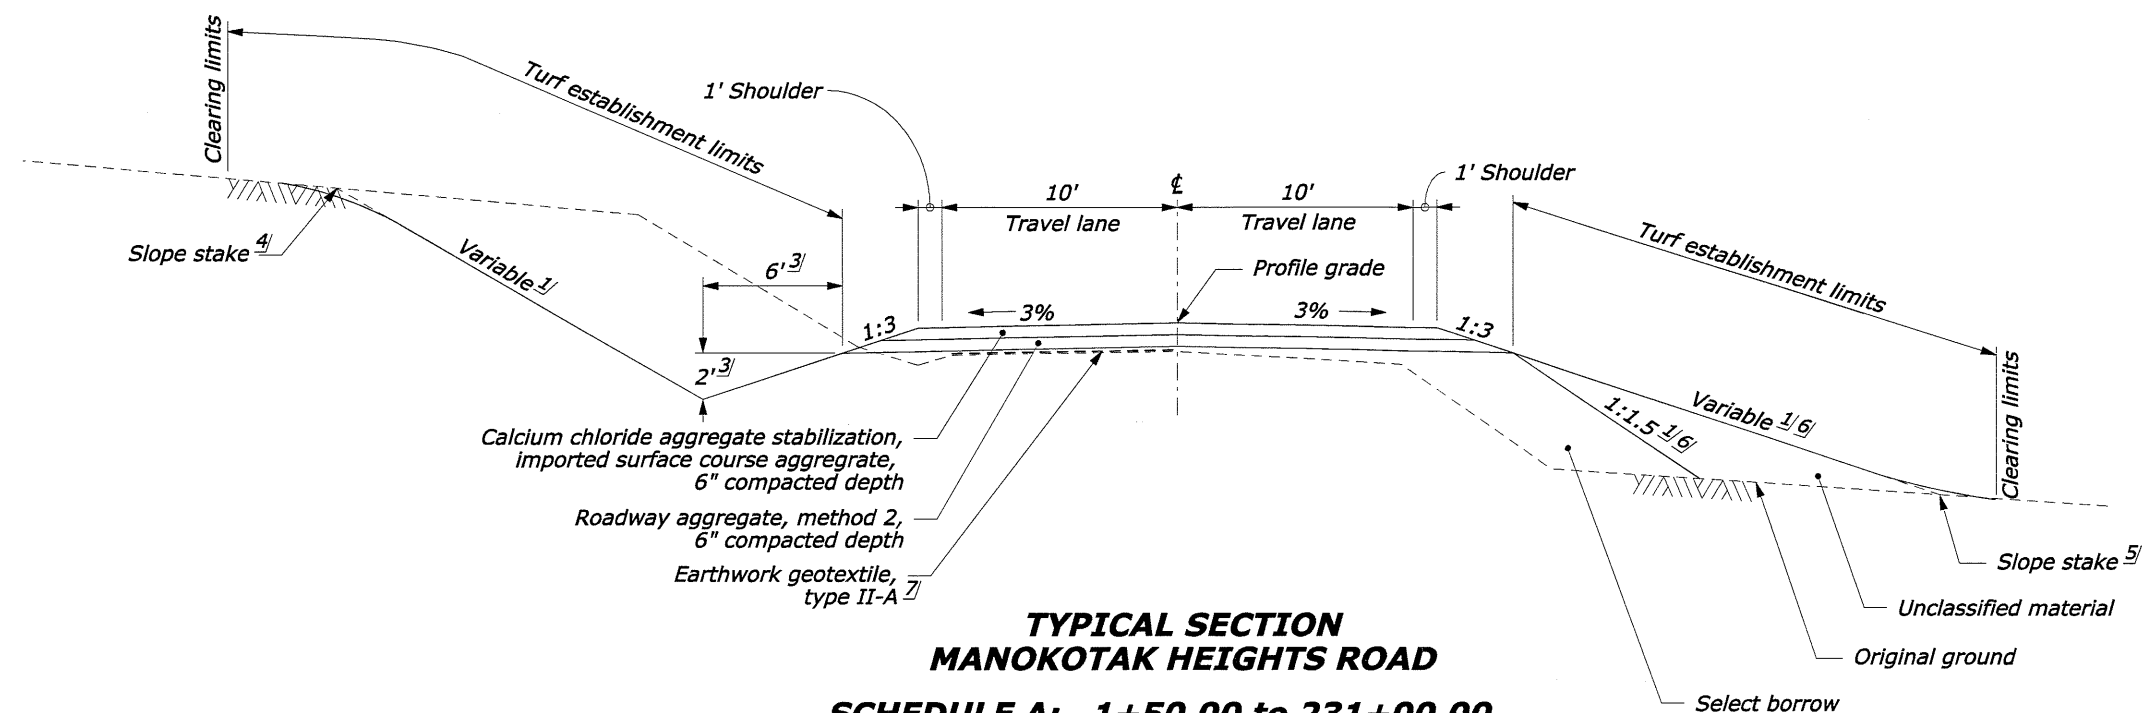


**TYPICAL SECTION  
MANOKOTAK HEIGHTS ROAD**

**SCHEDULE A: 1+50.00 to 231+00.00**  
**SCHEDULE B: 1+50.00 to 81+50.00**  
**118+00.00 to 231+00.00**  
**SCHEDULE C: 118+00.00 to 231+00.00**

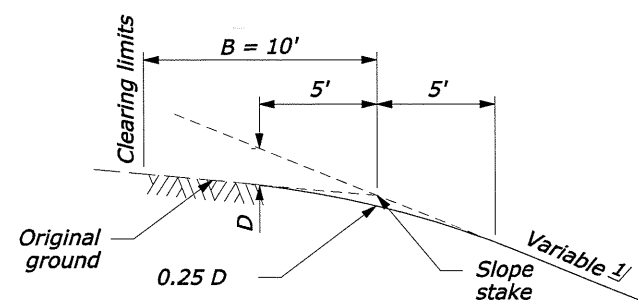

**CUT SLOPE<sup>2/</sup>  
ROUNDING DETAIL**

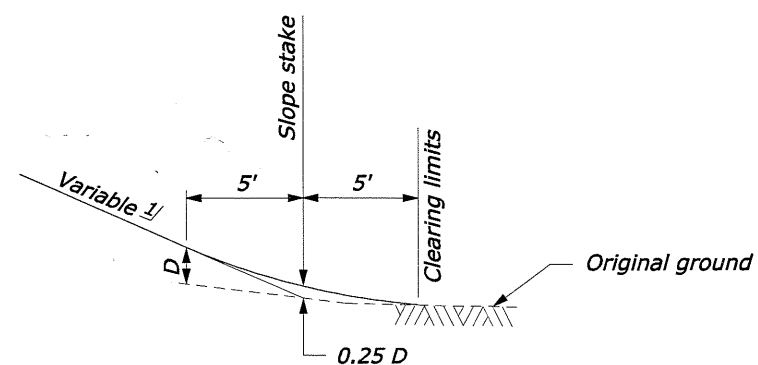

**FILL SLOPE  
ROUNDING DETAIL**



**FOOTNOTE:**

- <sup>1/</sup> Construct slopes as shown in the Staking Report.
- <sup>2/</sup> For cut heights less than "B" reduce "B" to the cut height dimension and reduce the front slope rounding distance proportionally.
- <sup>3/</sup> See Standard 602-6, "Pipe Culvert Inlet Treatment in Cut Slopes" and cross sections for variances.
- <sup>4/</sup> See cut slope rounding detail.
- <sup>5/</sup> See fill slope rounding detail.
- <sup>6/</sup> See Sheet C.3 for embankment construction details.
- <sup>7/</sup> Place geotextile over existing road surface at localized soft spots as approved by CO. See Sheet C.1 for locations and quantities.

**TYPICAL SECTION**


NO SCALE



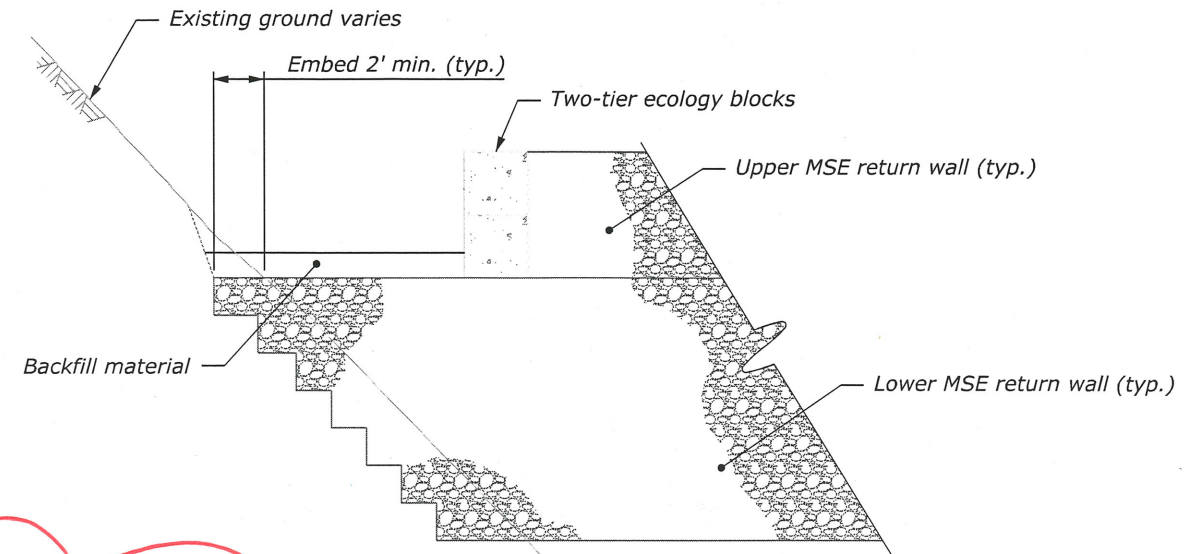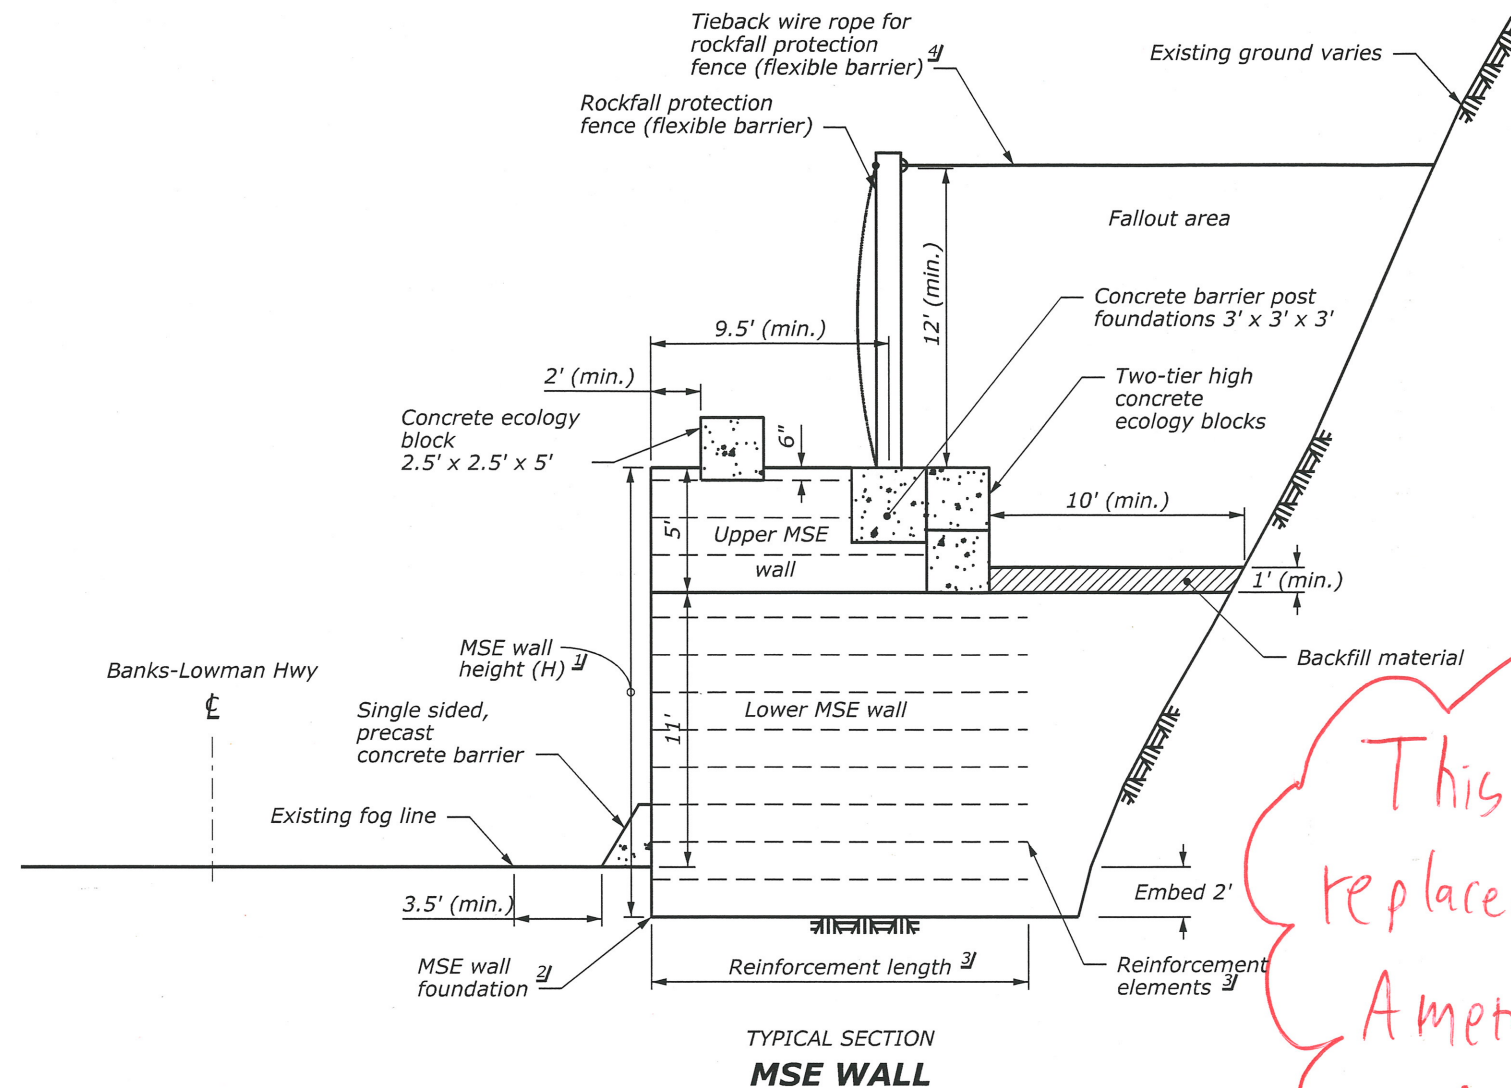

This sheet replaced per Amendment A001

NOTE: SEE SHEET AT BACK OF PLANS

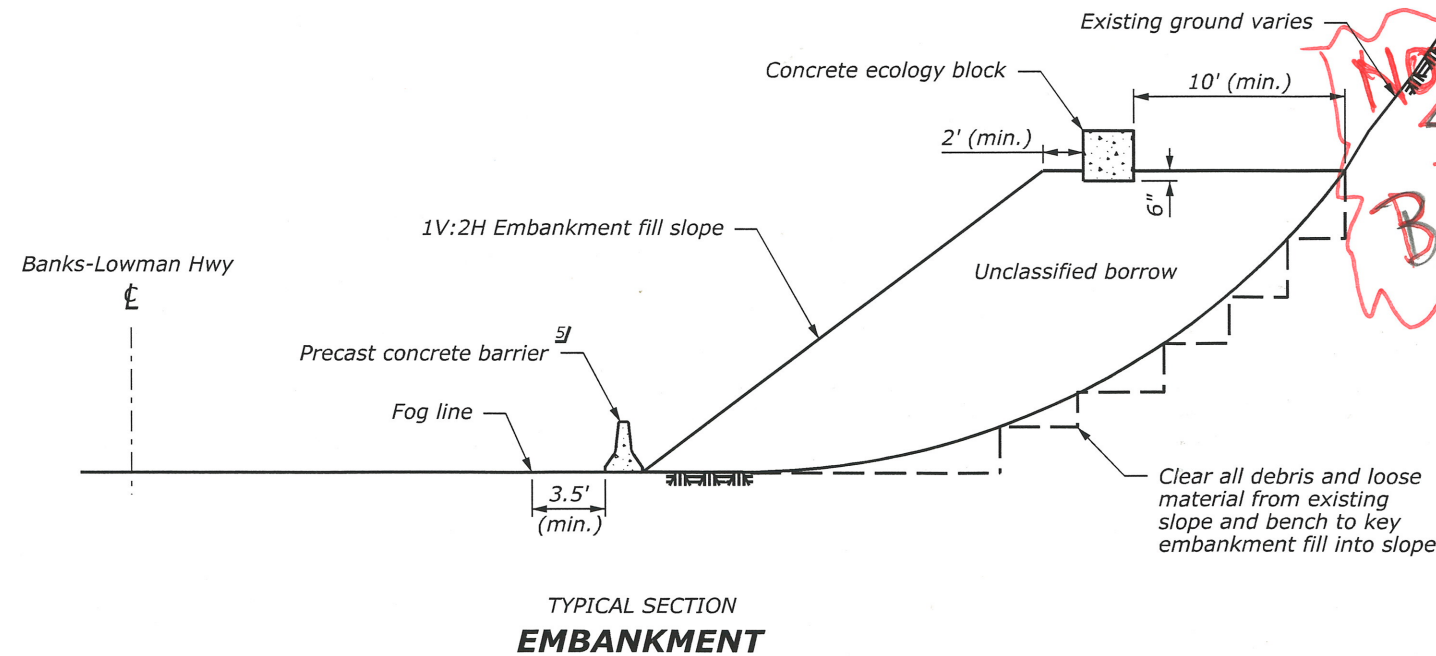

#### NOTE:

1. MSE wall and embankment locations shown on Sheet D.6. MSE wall to be constructed according to special contract requirements Section 255. See MSE wall details on Sheet D.23 for General Notes and design requirements.
2. See Concrete Ecology Block details on Sheet D.24, for block dimensions and stacking requirements.

#### FOOTNOTE:

- <sup>1</sup> MSE wall face to be vertical. MSE profile provided in MSE wall details on Sheet D.23.
- <sup>2</sup> Clear MSE wall foundation of all debris and prepare according to Section 209.
- <sup>3</sup> Use reinforcement elements for the lower MSE wall that are a length (L)  $\geq 0.8 H$ . Use elements that are (L)  $\geq 8$ -feet for the upper MSE wall. Extend reinforcement elements in the upper MSE wall either to the barrier fence post foundation or the two-tier concrete ecology blocks.
- <sup>4</sup> Install tieback wire ropes for the rockfall protection fence (flexible barrier) within manufacturer's tolerances to provide a minimum of 12-feet of vertical clearance between the ditch and tieback wire rope.
- <sup>5</sup> Place precast concrete barrier at the toe of the embankment fill slope to fit field conditions as approved by the CO.

### TYPICAL SECTIONS FOR SLOPE 112 MSE WALL & EMBANKMENT

NO SCALE

Checked by:

Designed by:

c:\myfiles\pw\_production\00115120\002413cc.dgn [US\_Sur\_ft20]

29 August 2012 9:58 AM



ROADWAY QUANTITIES							
Station to Station	Item 20101-0000 Clearing and grubbing (ACRE)	Item 20401-0000 Roadway excavation (CUYD) <sup>1/</sup>	Item 20410-0000 Select borrow (CUYD) <sup>2/</sup>	Unclassified material (CUYD) <sup>3/</sup> FOR INFORMATION ONLY	Conserved topsoil (CUYD) <sup>4/</sup> FOR INFORMATION ONLY	Item 62406-0400 Placing conserved topsoil, 6-inch depth (ACRE)	Item 62503-0000 Turf establishment, hydraulic method (SLRY)
1+50 to 25+00	2.57	3,891	4,628	927	2,225	2.27	9.3
25+00 to 55+00	3.65	5,418	9,383	2,809	3,563	3.34	13.4
55+00 to 81+50	2.48	3,060	5,398	390	1,923	2.01	8.8
81+50 to 85+00	0.30	310	782	248	306	0.26	1.0
85+00 to 115+00	2.46	2,139	5,792	2,041	2,104	2.07	8.3
115+00 to 118+00	0.26	250	705	248	248	0.22	0.9
118+00 to 145+00	2.68	2,996	7,127	1,236	2,052	2.37	9.5
145+00 to 175+00	4.16	8,616	7,032	2,336	4,017	3.88	15.5
175+00 to 205+00	3.63	6,289	8,835	1,296	3,315	3.32	13.3
205+00 to 231+00	2.18	2,163	6,267	1,084	1,690	1.88	7.5
Schedule A Total	24.37	35,132	55,949	12,615	21,443	21.62	87.5
Schedule B Total	21.35	32,433	48,670	10,078	18,785	19.07	77.3
Schedule C Total	12.65	20,064	29,261	5,952	11,074	11.45	45.8

ROADWAY OBLITERATION QUANTITIES				
Station to Station	Side	Item 21101-2000 Roadway obliteration, method 2 <sup>5/</sup> (SQYD)	Item 62406-0400 Placing conserved topsoil, 6-inch depth (ACRE)	Item 62503-0000 Turf establishment, hydraulic method (SLRY)
79+43 to 80+51	LT	203	0.04	0.2
80+92 to 81+38	LT	148	0.03	0.1
119+36 to 120+16	LT	89	0.02	0.1
Schedule A Total		440	0.09	0.4
Schedule B Total		440	0.09	0.4
Schedule C Total		89	0.02	0.1

ITEM 60405-0000 MANHOLE ADJUSTMENT			
Station	Side	Adjustment (LNFT)	Quantity (EACH)
3+88	LT	0.5	1
216+88	LT	10	1
217+92	RT	10	1
225+56	RT	10	1
229+55	RT	10	1
230+81	RT	10	1
Schedule A Total			6
Schedule B Total			6
Schedule C Total			5

ITEM 61901-2000 FENCE, CHAIN LINK, 72" HEIGHT SCHEDULES A & B <sup>9/</sup>			
Station to Station	Side	Offset (LNFT)	Quantity (LNFT)
5+40 to 9+20	RT	18	380.0

SUMMARY OF LIGHTING SYSTEM INSTALLATION QUANTITIES SCHEDULES A, B, & C <sup>8/</sup>			
Item Number	Description	Unit	Quantity
63611-0500	Wire, electrical conductors, 6 AWG	LNFT	1,725.0
63612-0000	Luminaire	EACH	10
63612-1200	Luminaire, photocontrols	EACH	1
63620-0000	Pole, light	EACH	10

ITEM 25120-1000 RIPRAP DITCH, CLASS 1 <sup>6/</sup>		
Station to Station <sup>7/</sup>	Side	Quantity (LNFT)
7+00 to 9+50	LT	254
19+00 to 21+00	LT	198
72+00 to 73+50	LT	150
72+00 to 74+00	RT	201
80+00 to 80+35	LT	36
80+85 to 81+50	LT	67
81+50 to 83+00	LT	151
120+50 to 126+50	LT	592
165+62 to 166+50	LT	88
170+50 to 171+00	LT	50
176+29 to 179+50	LT	321
Schedule A Total		2,108
Schedule B Total		1,957
Schedule C Total		1,051

NOTE:

1. See Sheet E.1 for approach road quantities.

FOOTNOTE:

- <sup>1/</sup> Includes conserved topsoil.  
<sup>2/</sup> Quantities shown represent volume required to construct 1:1.5 embankments. Based on 1.33 compaction factor.  
<sup>3/</sup> Represents quantity placed on 1:1.5 embankments to construct flattened slopes.  
<sup>4/</sup> Based on a conserved topsoil depth of 9 inches.  
<sup>5/</sup> See Sheet H.1 for roadway obliteration details.  
<sup>6/</sup> See Sheet G.4 for riprap ditch details.  
<sup>7/</sup> See Sheets D.2-D.9 for locations of riprap ditches relative to the construction centerline.  
<sup>8/</sup> See Sheets H.2-H.3 for lighting system details.  
<sup>9/</sup> See Sheets H.4-H.5 for fence details.  
<sup>10/</sup> Manholes built after field survey. Adjust to grade as needed.

TABULATION OF PLAN AND  
PROFILE QUANTITIES



7/2012 B. Wacker  
7/2012 Checked by: N. Bell  
06-Sep-2012 02:45 PM Designed by: ...\\plan and profile\dc0908fa.dgn

PLAN AND PROFILE LEGEND:

- Line to be constructed
- Culvert with inlet/outlet ditch
- Typical inlet/outlet ditch
- Energy dissipator
- Riprap ditch, class 1
- Roadway obliteration, method 2
- Right of entry

UTILITY CONTACTS:


- POWER  
Manokotak Power Company  
ATTN: Moses Toyukak, Sr.  
(907) 289-2041
- TELEPHONE  
Nushagak Telephone Co-op  
ATTN: Michael Favors  
(907) 842-6367
- TELEPHONE  
AT&T  
ATTN: Tim Sorenson  
(907) 264-7870
- WATER/SEWER  
City of Manokotak  
ATTN: Irene Gamechuck-Oles  
(907) 289-1305

STATE	PROJECT	SHEET NUMBER
AK	DEN 2009(8)	D.2

BEGIN PROJECT AK DEN 2009(8)  
MANOKOTAK HEIGHTS  
ROAD RECONSTRUCTION  
BEGIN SCHEDULES A & B  
1+50.00


NOTE:  
Refer to right of entry documents for right of entry boundary descriptions.

N= 1820450.355  
E= 1441280.797  
EL= 47.34

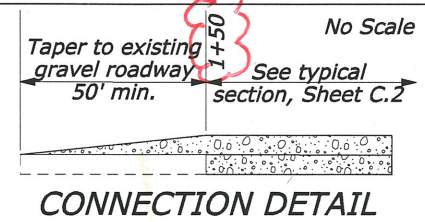

CONTROL POINTS

NAME	NORTHING	EASTING	ELEVATION
11	1820423.16	1441267.39	45.75
1035	1819474.13	1441721.22	45.39

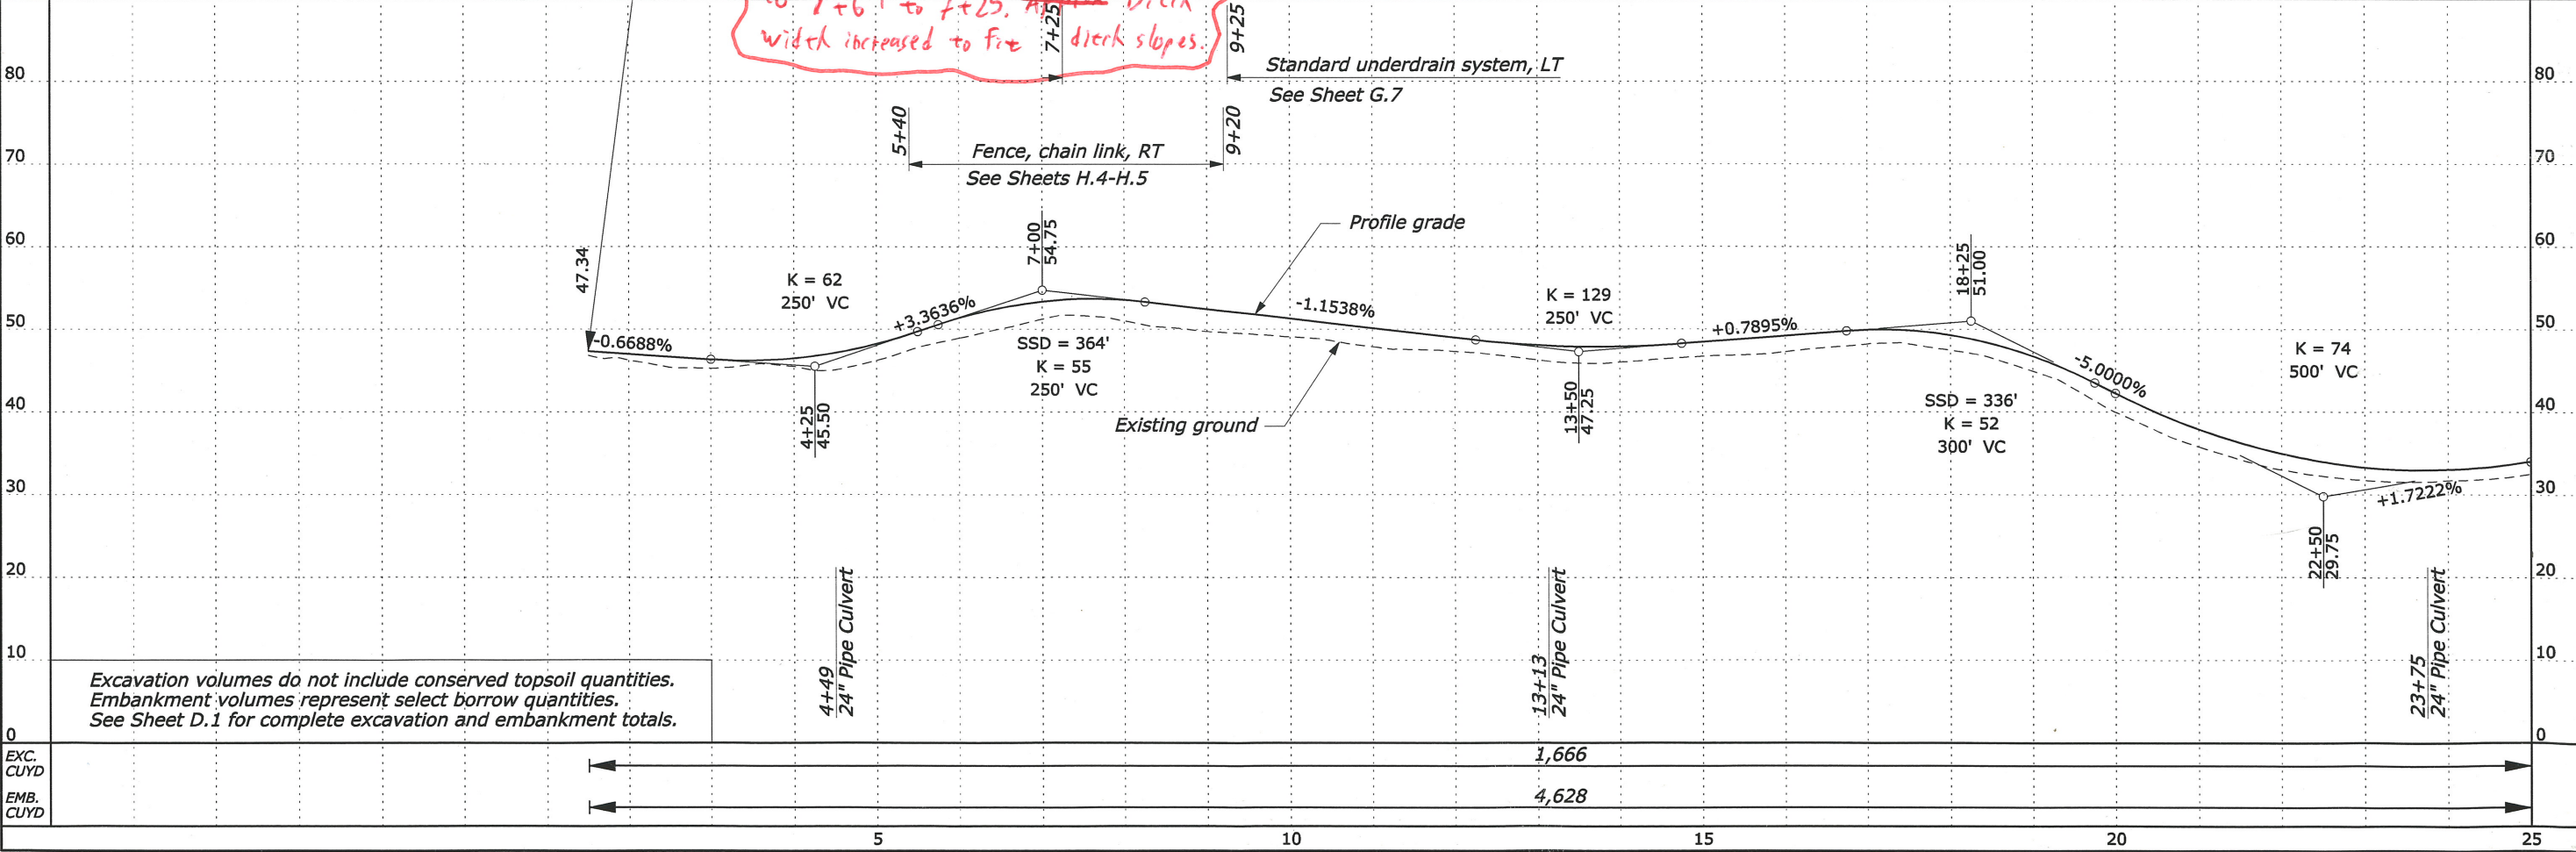








7/2012  
B. Wacker  
Checked by:  
7/2012  
N. Bell  
Designed by:  
06-Sep-2012 02:43 PM  
...Plan and Profile\cd908c.dgn

STATE	PROJECT	SHEET NUMBER
AK	DEN 2009(8)	D.4

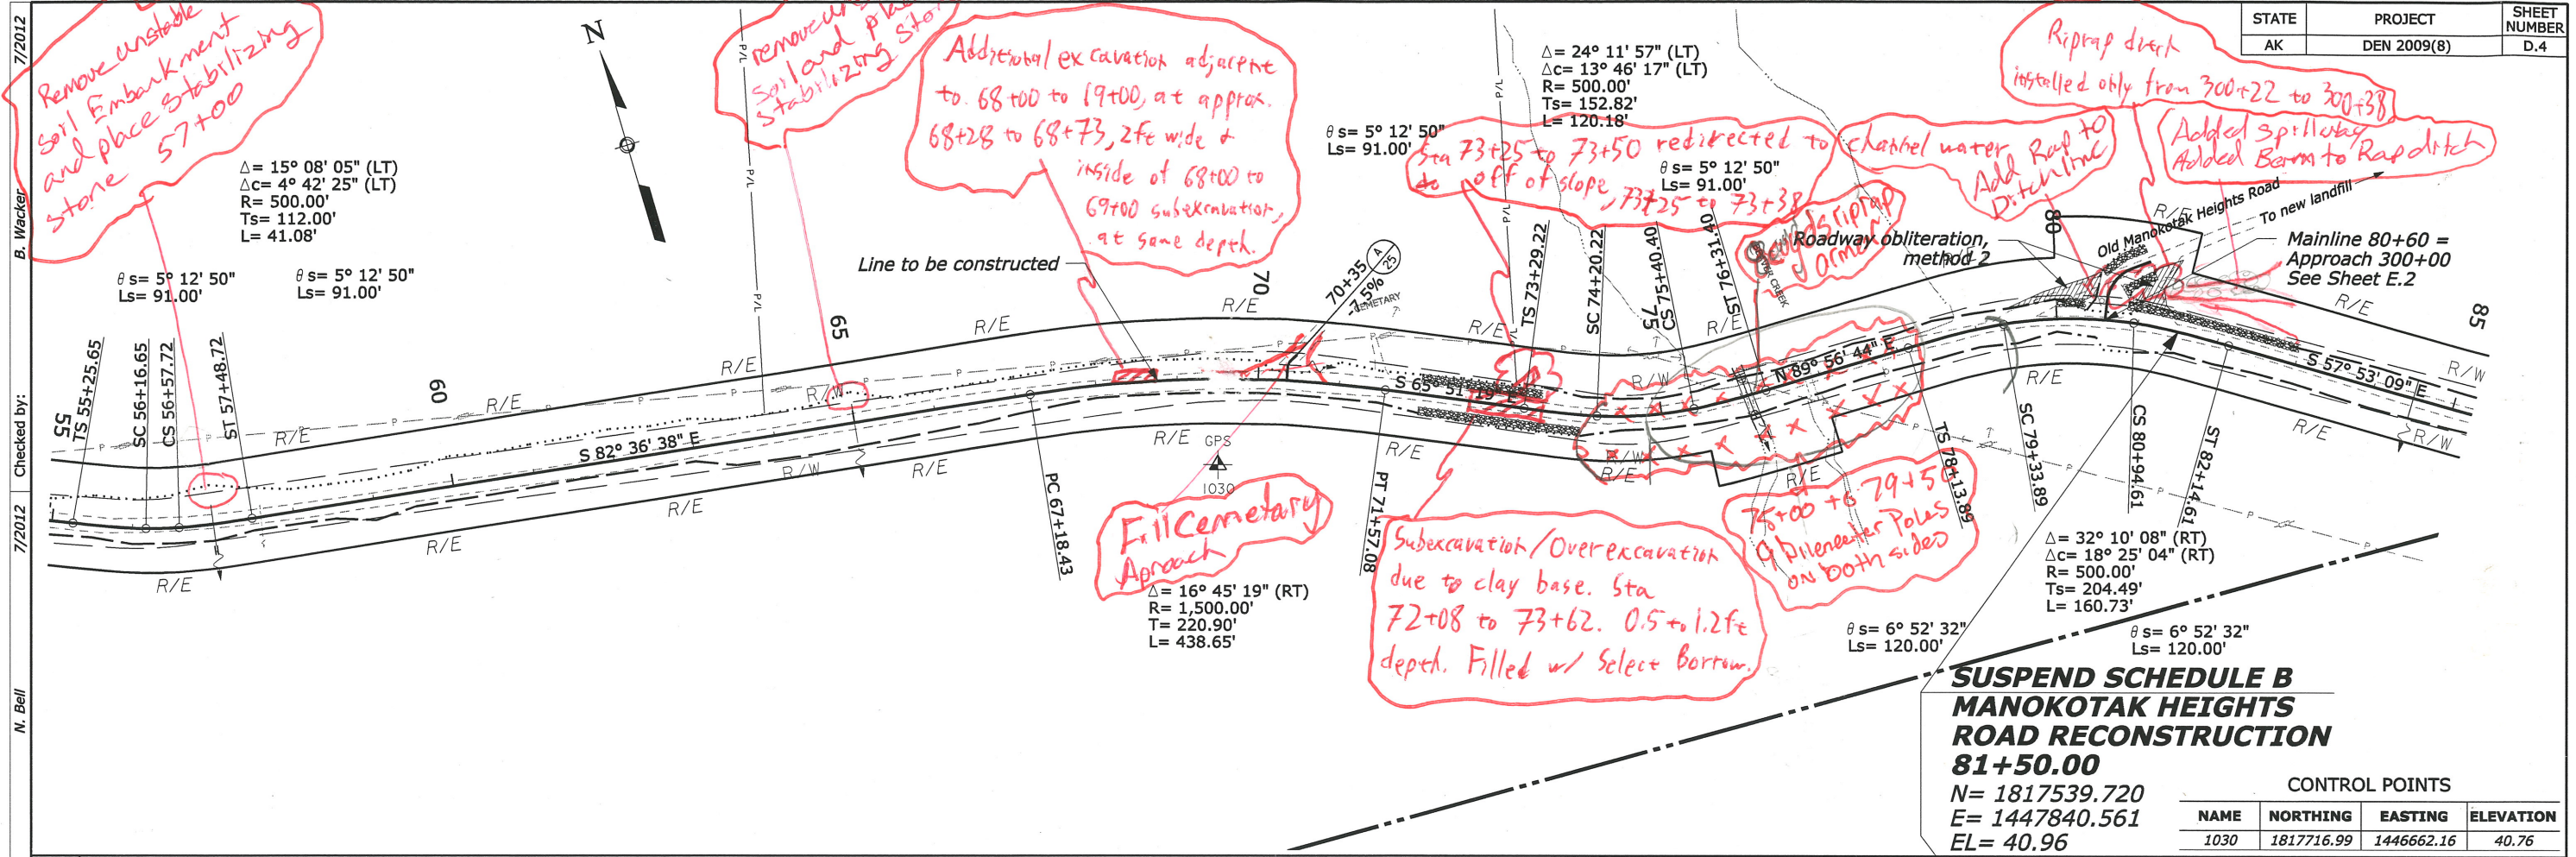


**SUSPEND SCHEDULE B  
MANOKOTAK HEIGHTS  
ROAD RECONSTRUCTION  
81+50.00**



N= 1817539.720  
E= 1447840.561  
EL= 40.96

CONTROL POINTS

NAME	NORTHING	EASTING	ELEVATION
1030	1817716.99	1446662.16	40.76

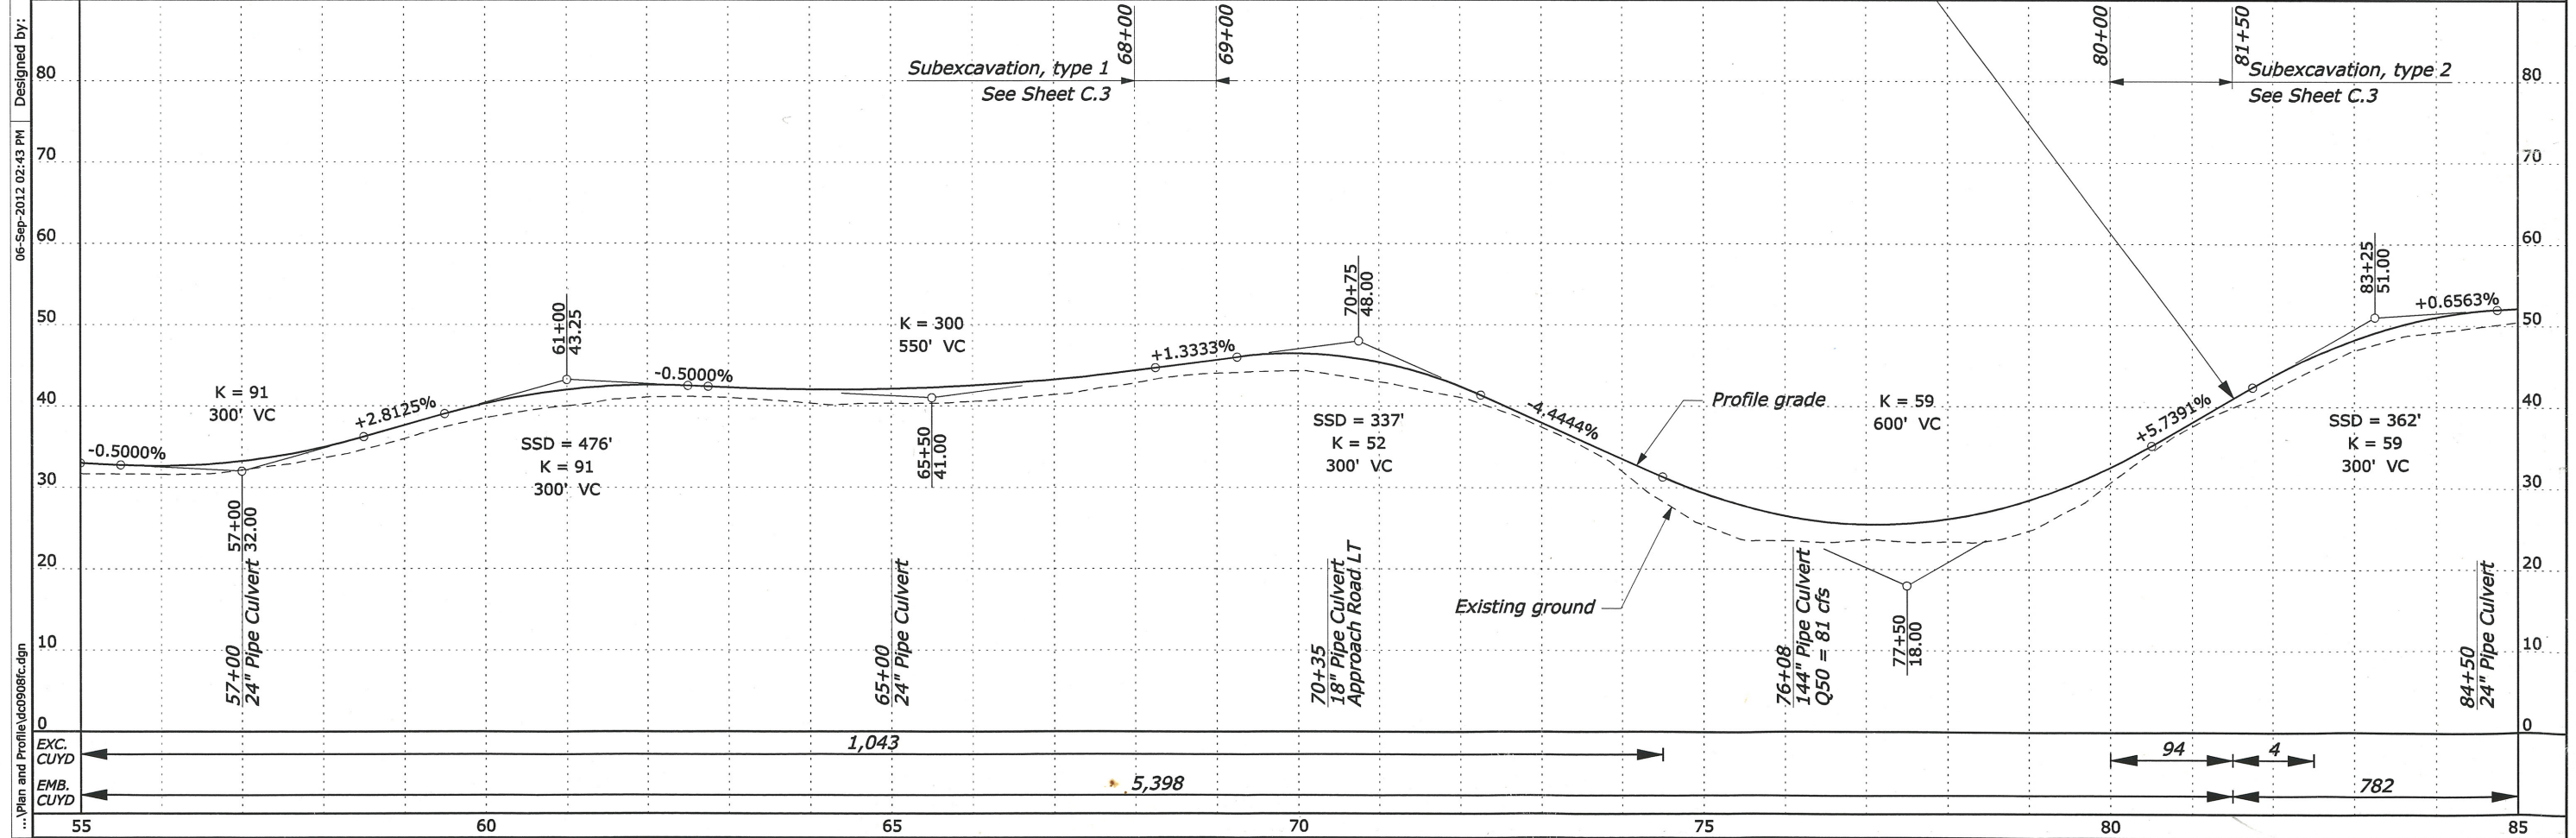





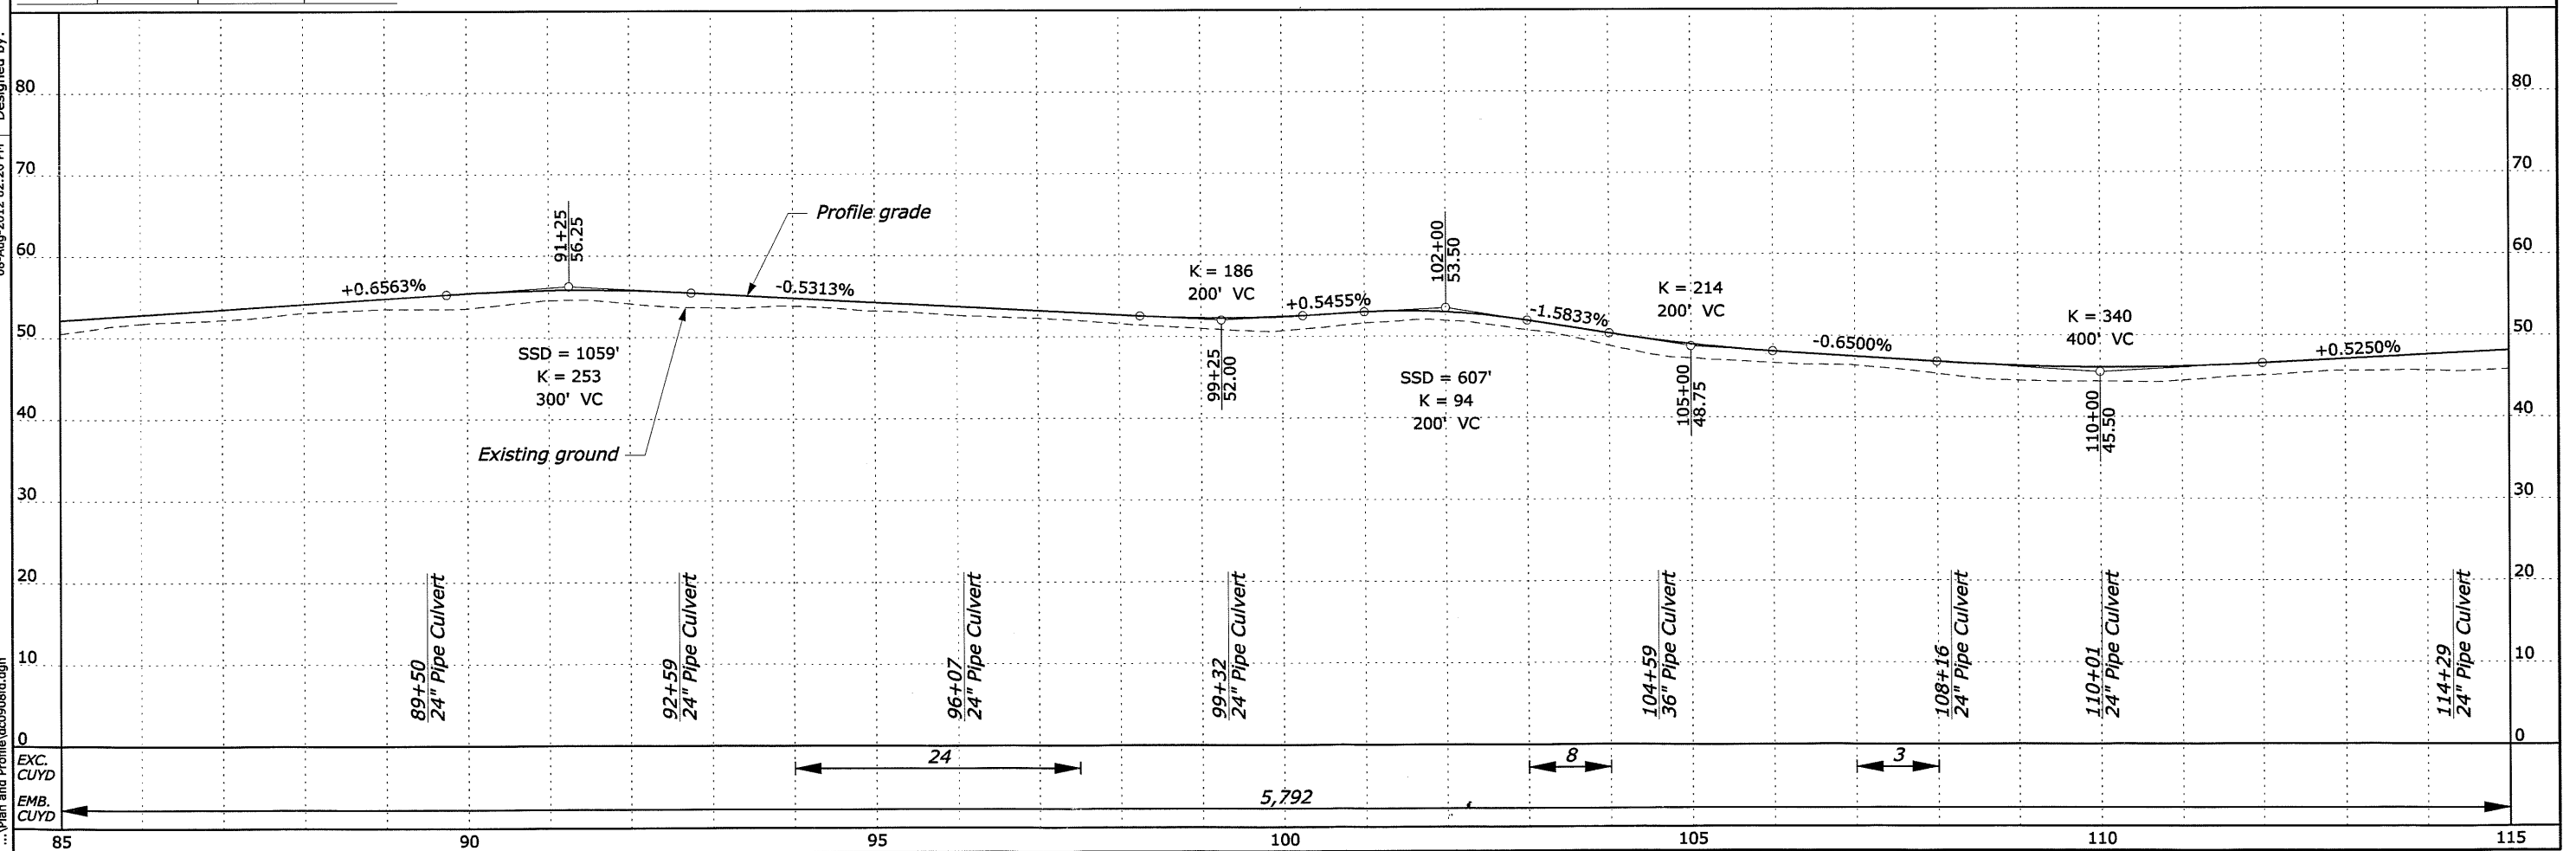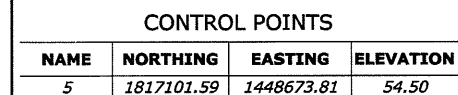



7/2012 B. Wacker 7/2012 Checked by: 7/2012 N. Bell 06-Sep-2012 02:48 PM Designed by: ...Plan and Profile\dc09086.dgn

STATE	PROJECT	SHEET NUMBER
AK	DEN 2009(8)	D.6

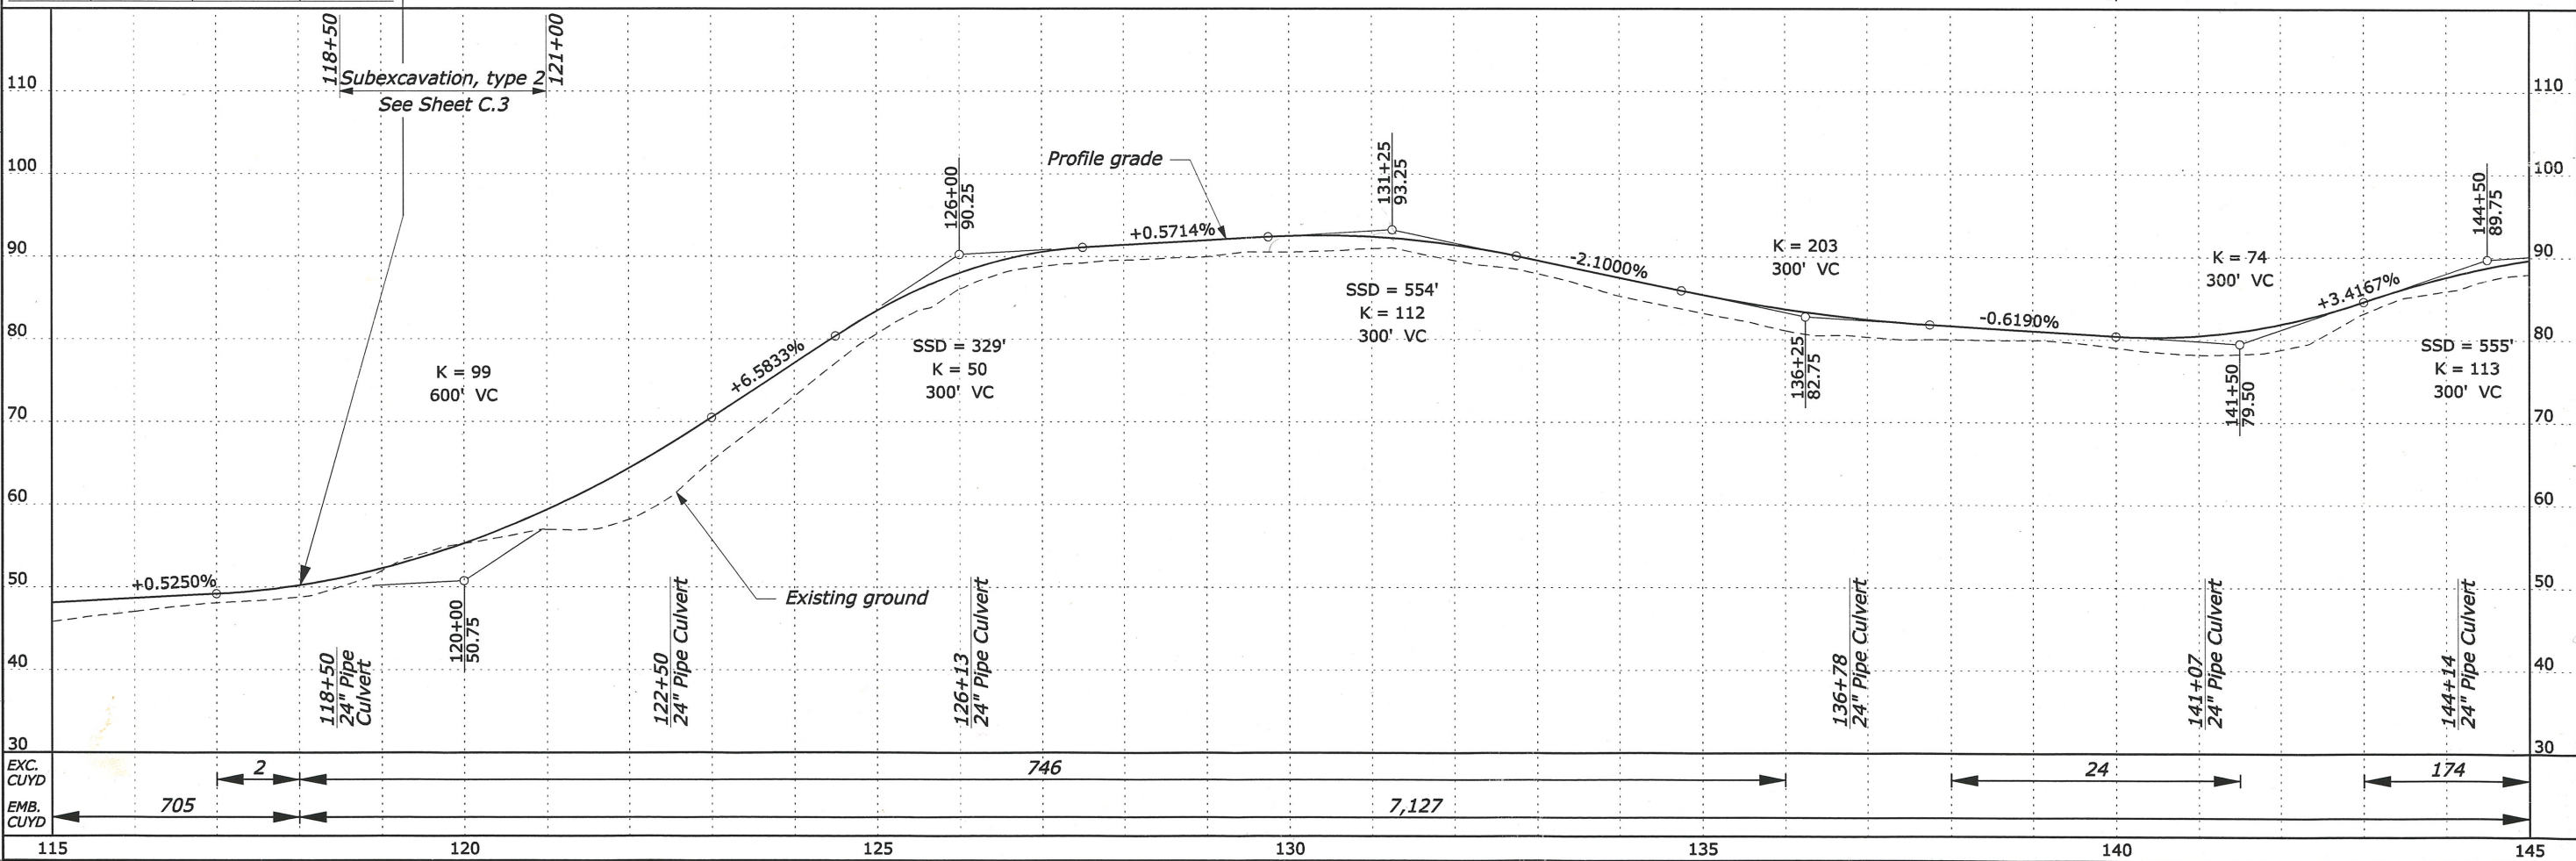
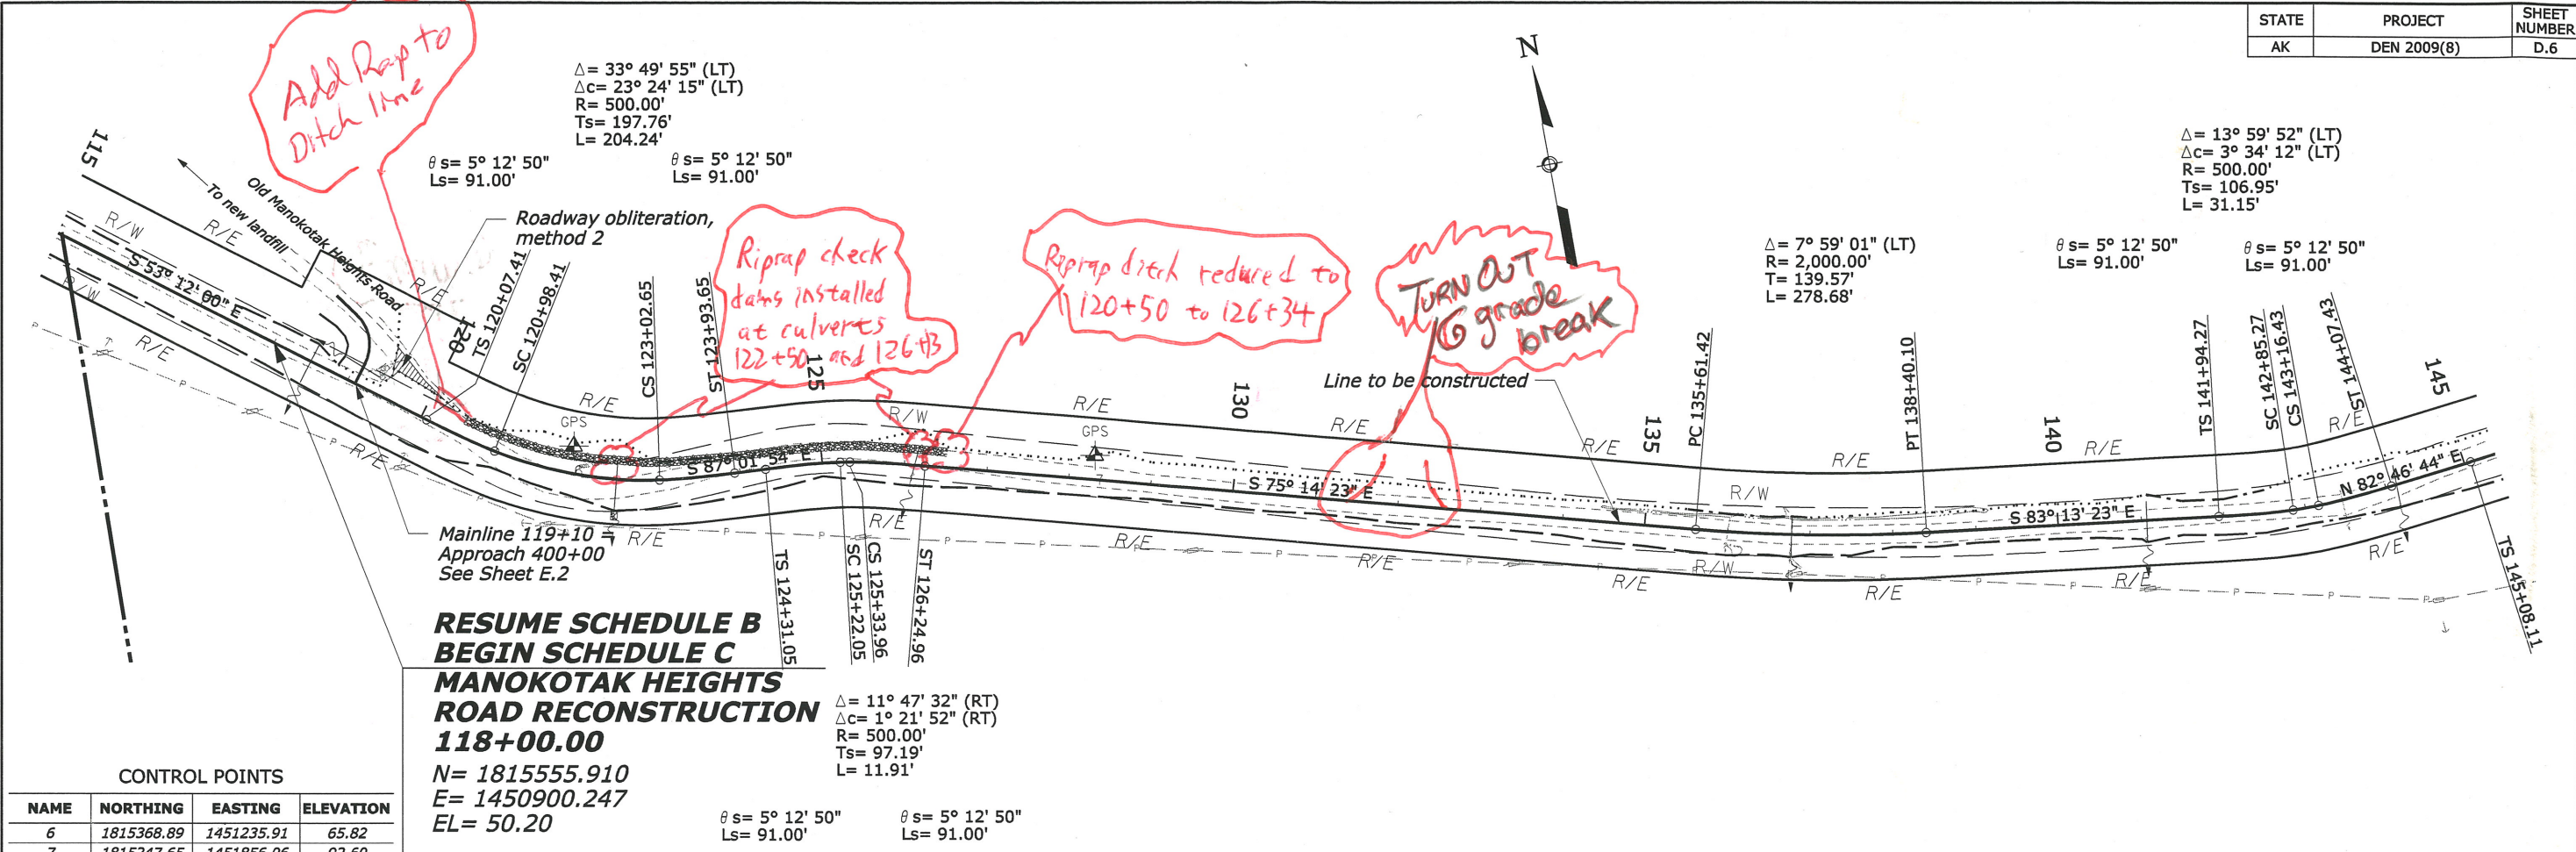




7/2012  
B. Wacker  
Checked by:  
7/2012  
N. Bell  
Designed by:  
08-Aug-2012 02:28 PM  
\\plan and profile\cd908fr.dgn

CONTROL POINTS			
NAME	NORTHING	EASTING	ELEVATION
1033	1814895.61	1455427.34	121.04

STATE	PROJECT	SHEET NUMBER
AK	DEN 2009(8)	D.7

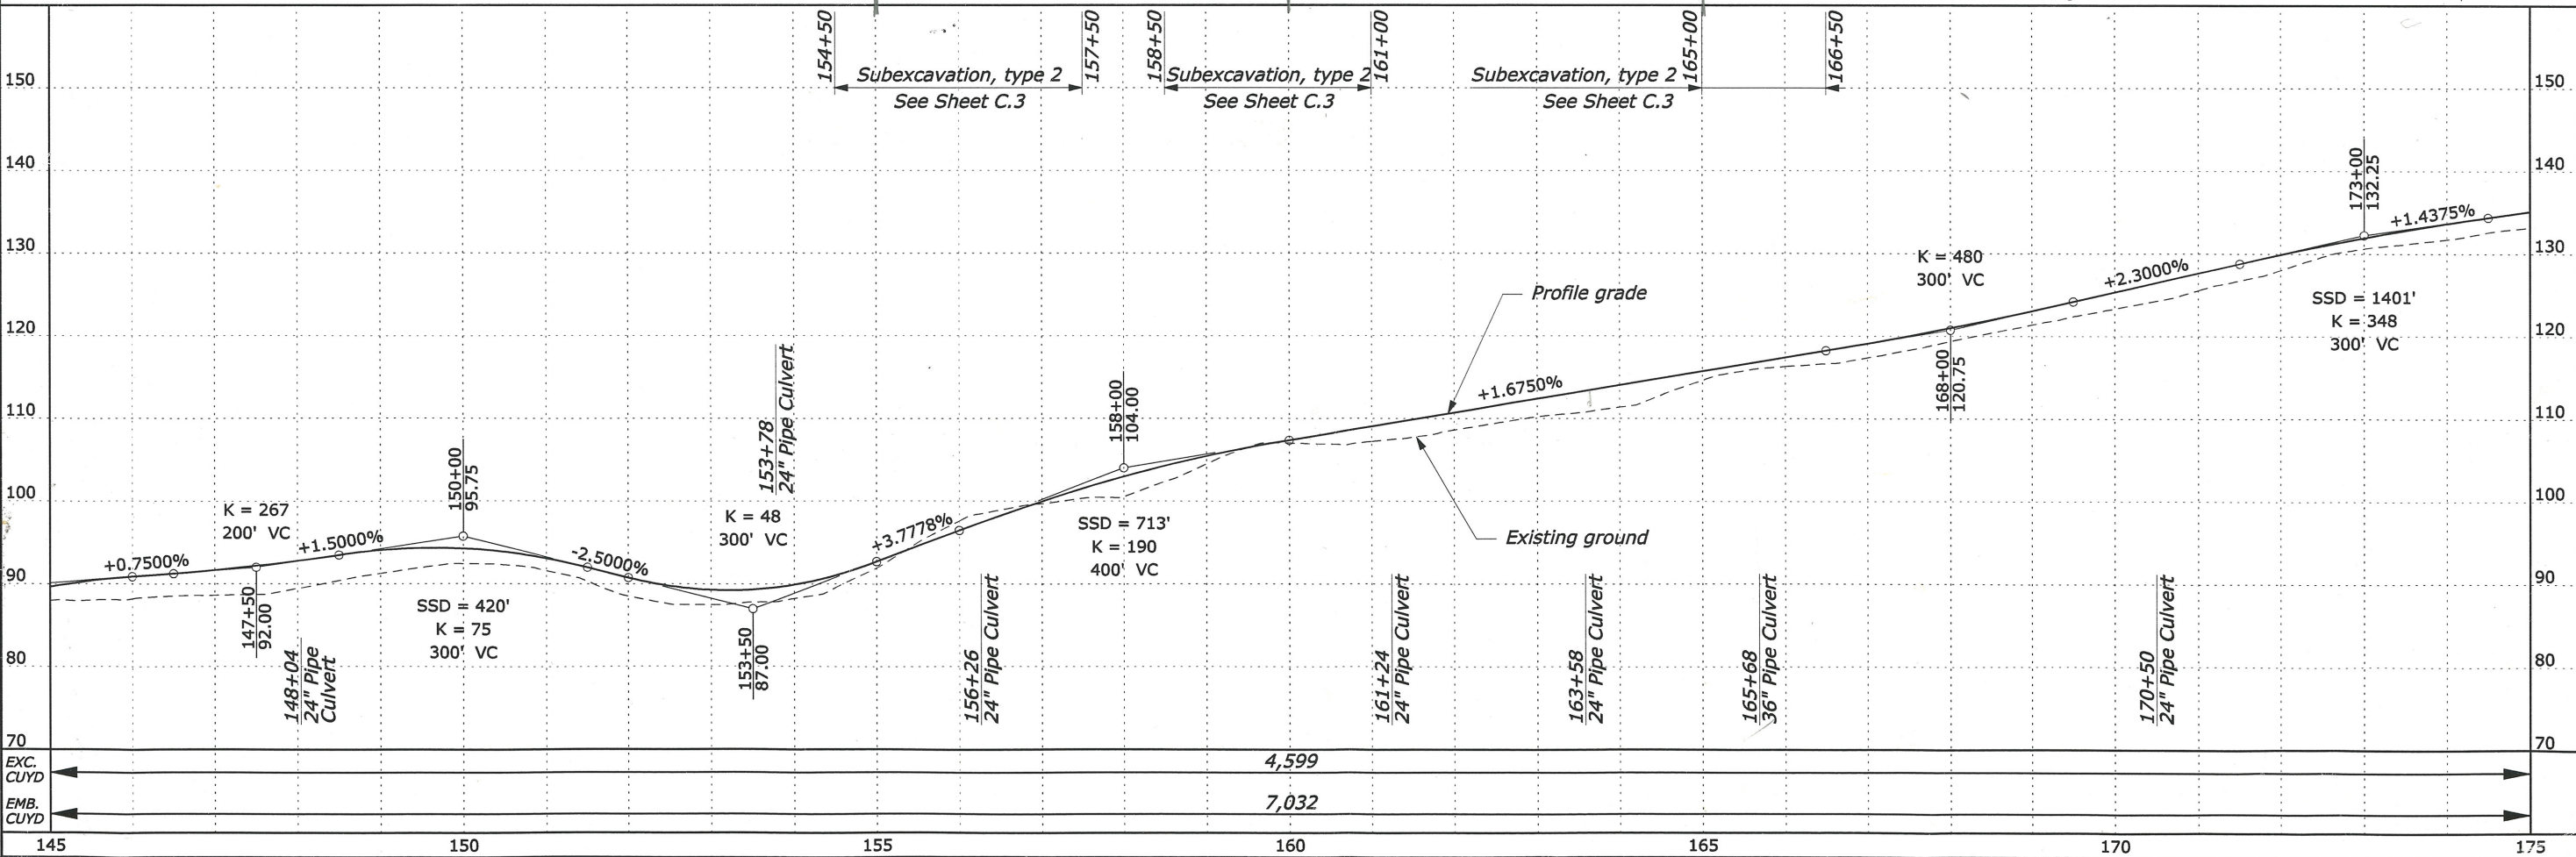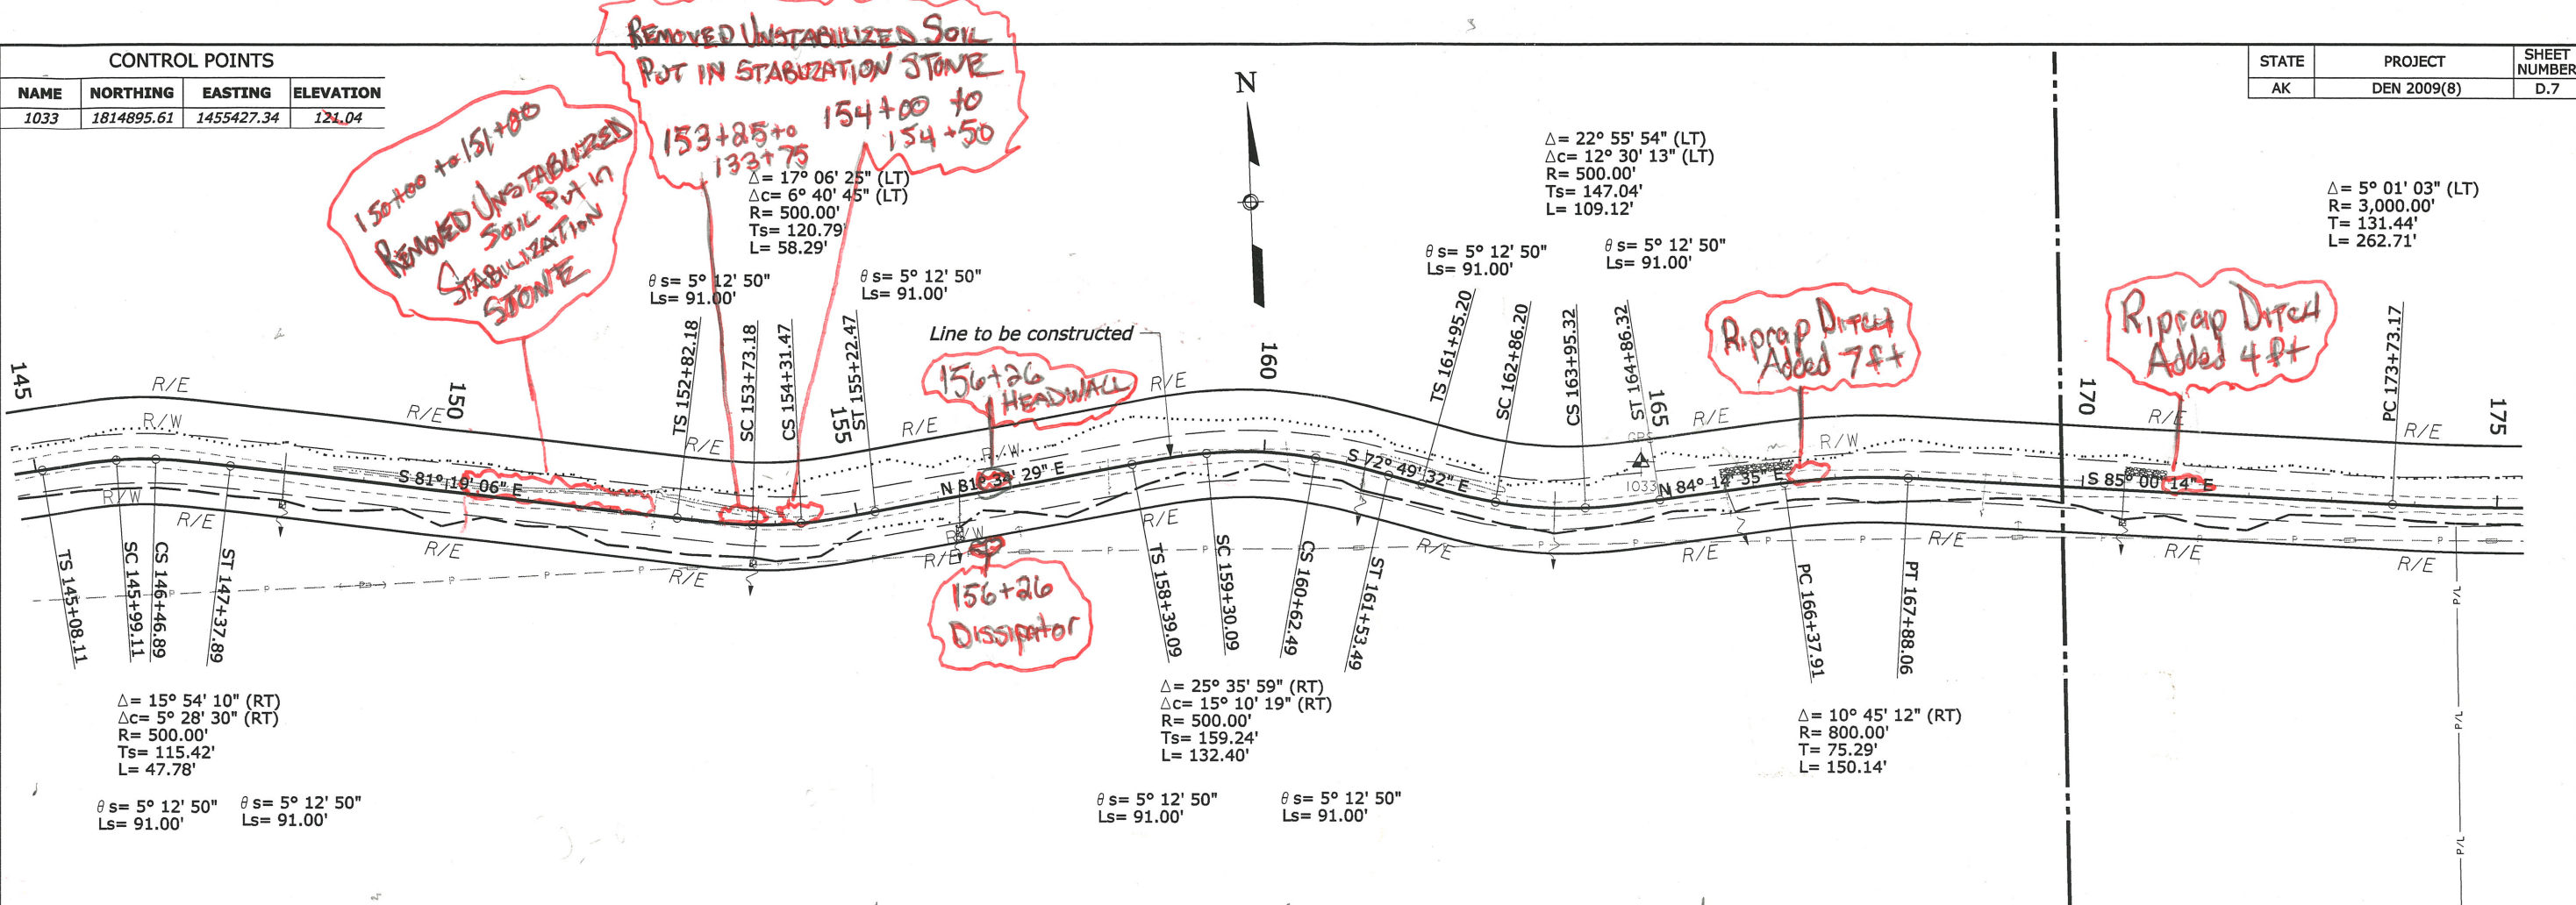



7/2012  
B. Wacker  
Checked by:  
7/2012  
N. Bell  
Designed by:  
08-Aug-2012 02:29 PM  
...Plan and Profile.dwg

CONTROL POINTS



NAME	NORTHING	EASTING	ELEVATION
1031	1814843.16	1457229.76	166.08

$\Delta = 1^\circ 09' 58''$  (RT)  
 $R = 10,000.00'$   
 $T = 101.76'$   
 $L = 203.52'$

Riprap ditch added 3A

Subex Deleted

Line to be constructed

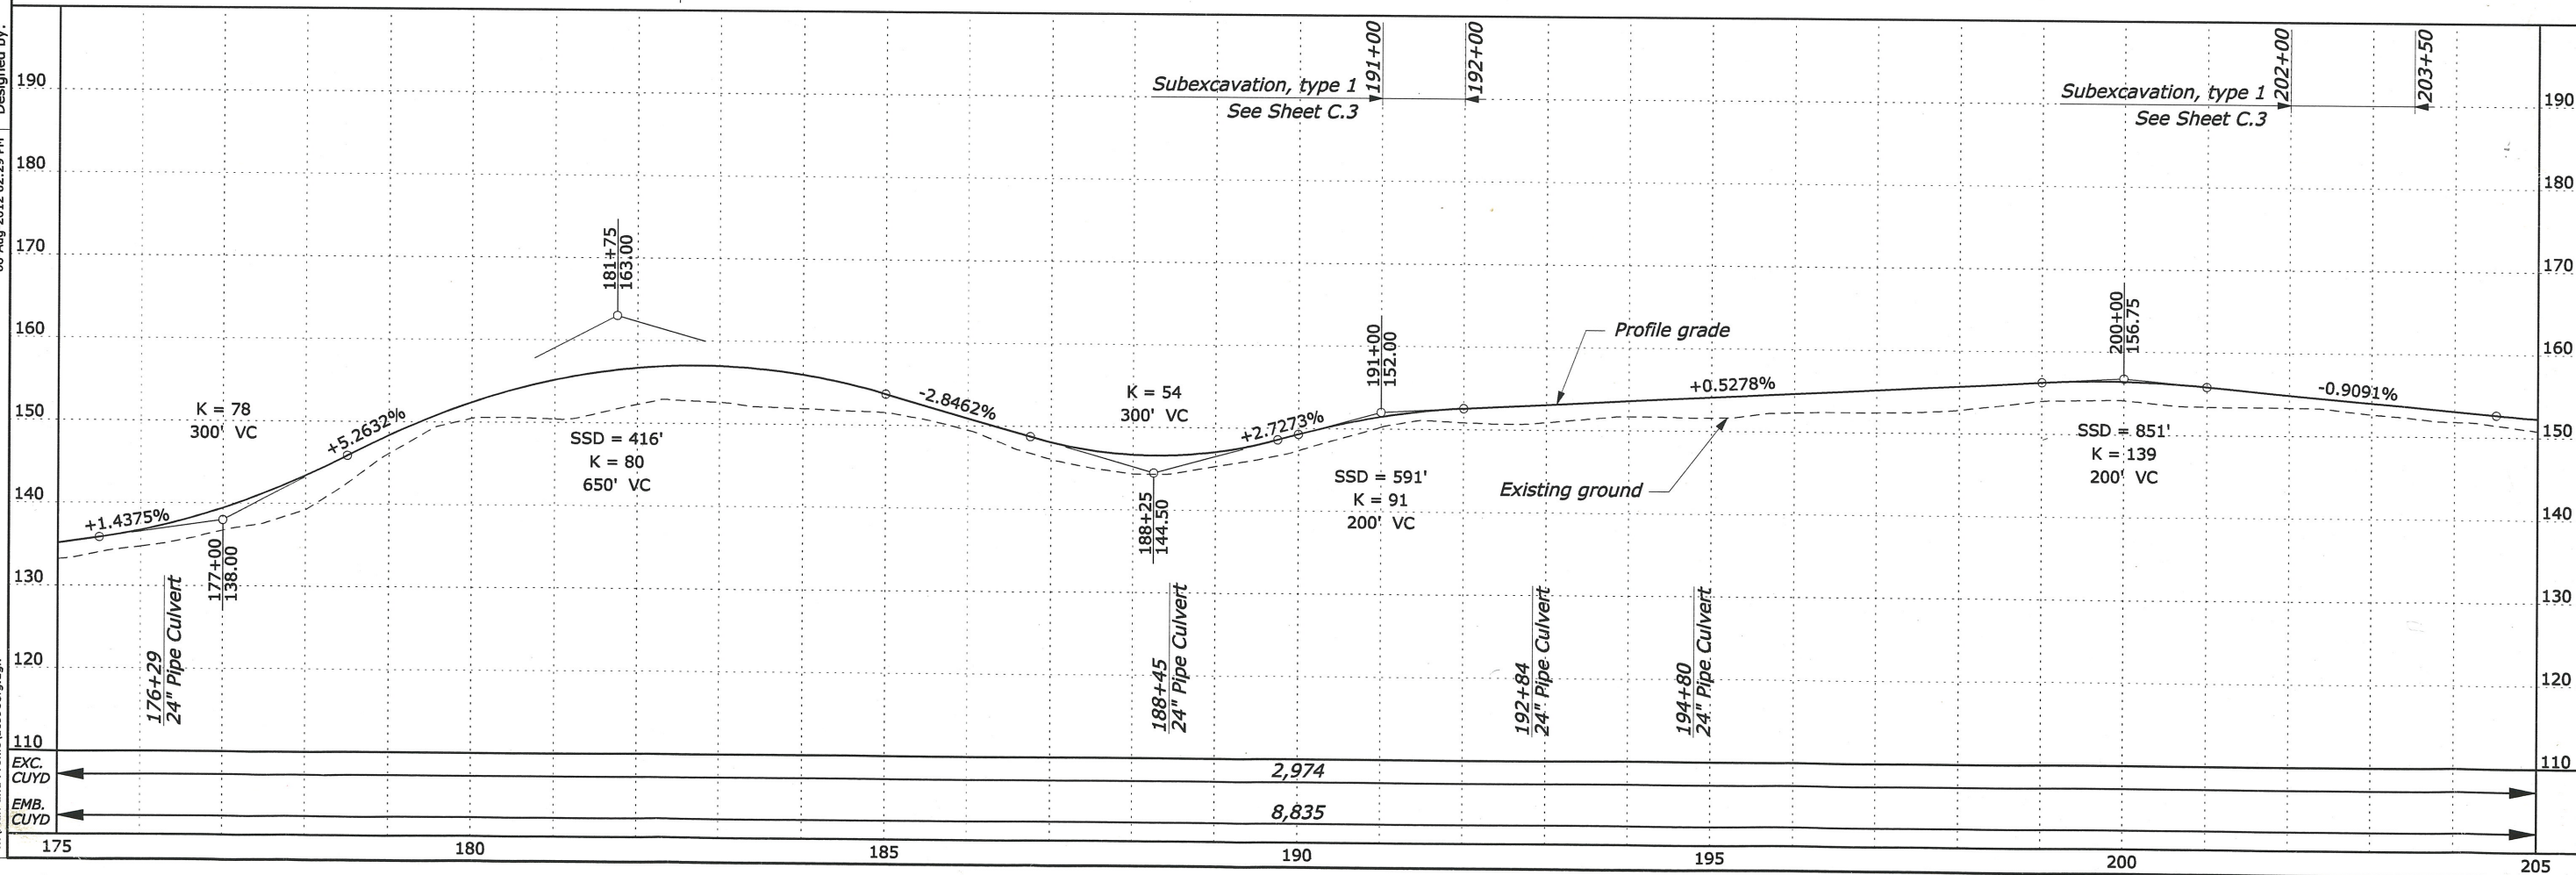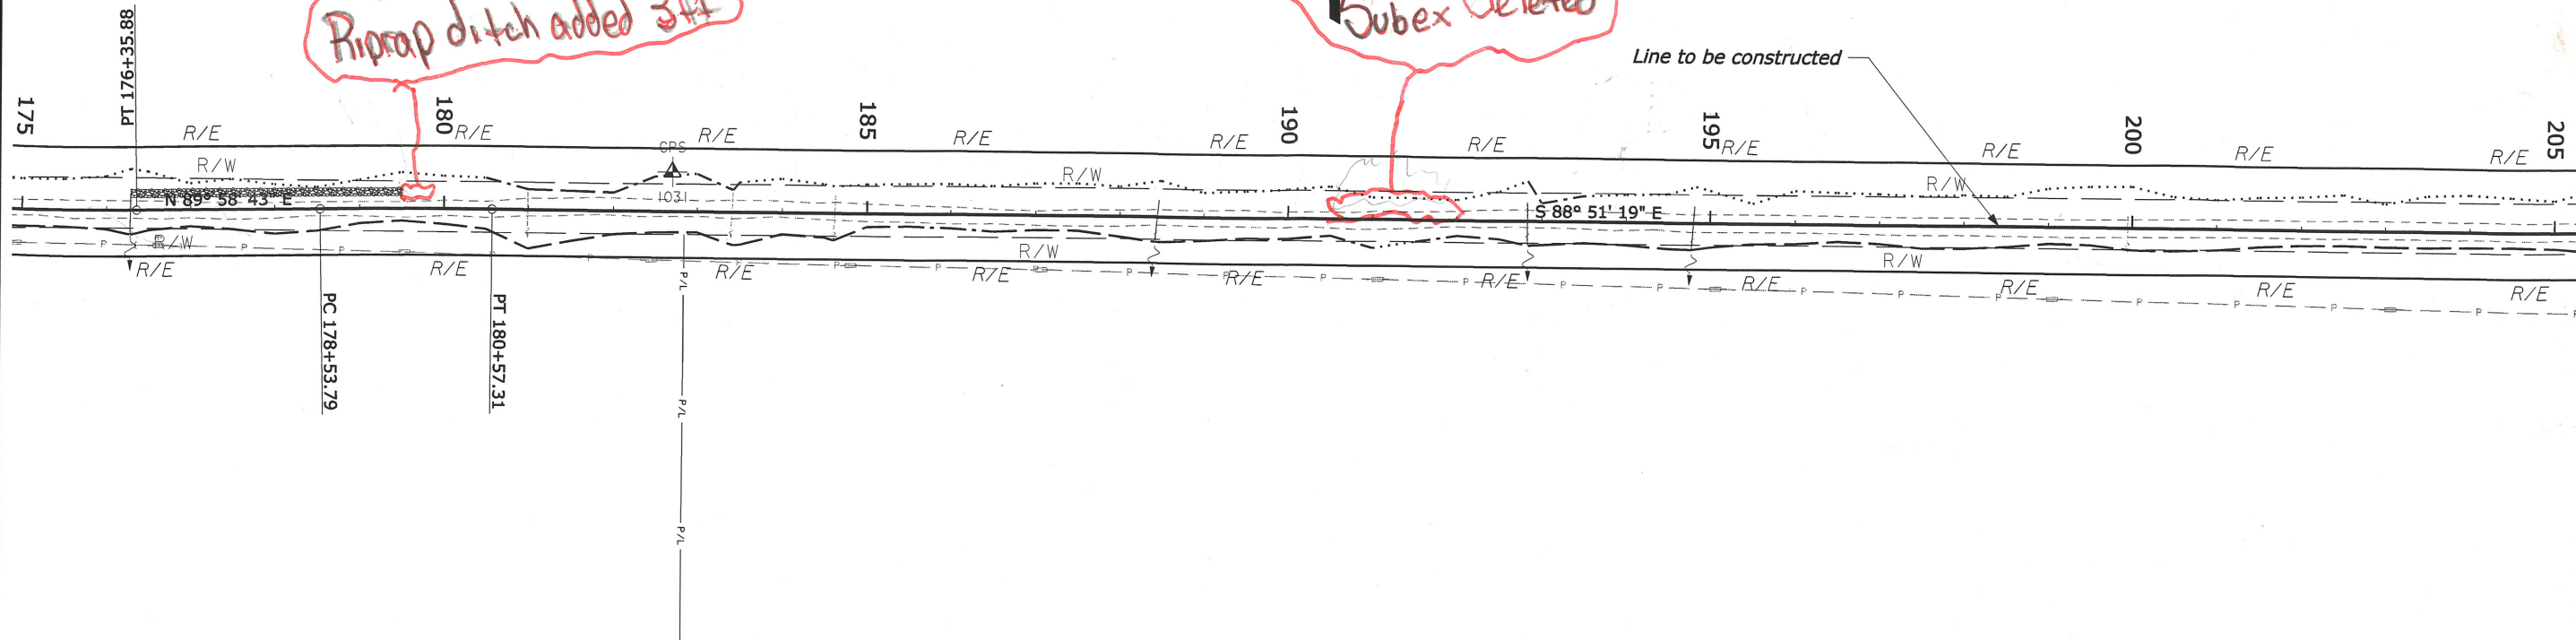







APPROACH ROAD QUANTITIES						
Mainline Station	Item 20101-0000 Clearing and grubbing (ACRE)	Item 20401-0000 Roadway excavation (CUYD) <sup>1/</sup>	Item 20410-0000 Select borrow (CUYD) <sup>2/</sup>	Item 30802-2000 Roadway aggregate, method 2 (TON) <sup>5/</sup>	Item 62406-0400 Placing conserved topsoil, 6-inch depth (ACRE)	Item 62503-0000 Turf establishment, hydraulic method (SLRY)
70+35 LT	0.02	6	5	33.0	0.01	0.1
80+60 LT	0.11	188	48	142.0	0.09	0.4
119+10 LT	0.17	476	293	179.0	0.15	0.7
209+65 LT	0.10	86	113	236.0	0.06	0.3
216+64 RT	0.02	9	3	57.0	0.01	0.1
221+90 LT	0.24	545	11	362.0	0.19	0.8
223+68 LT	0.02	13		63.0	0.01	0.1
225+06 LT	0.02	13		71.0	0.01	0.1
226+66 LT	0.02	9		28.0	0.01	0.1
227+66 LT	0.02	8		28.0	0.01	0.1
228+43 LT	0.01	11		28.0	0.01	0.1
230+45 LT	0.02	8		35.0	0.01	0.1
Schedule A Total	0.77	1,372	473	1,262.0	0.57	3.0
Schedule B Total	0.77	1,372	473	1,262.0	0.57	3.0
Schedule C Total	0.64	1,178	420	1,087.0	0.47	2.5

Subexcavation  
300+50 to 300+94

ITEM 25120-1000 RIPRAP DITCH, CLASS 1 <sup>3/</sup>		
Station to Station <sup>4/</sup>	Side	Quantity (LNFT)
300+50 to 301+00	LT	59
300+50 to 301+00	RT	41
600+50 to 601+50	LT	107
600+50 to 601+50	RT	93
Schedule A Total		300
Schedule B Total		300
Schedule C Total		200

160 R+ = 600+19 to 601+72  
109 R+ = 600+34 to 601+50

FOOTNOTE:





- <sup>1/</sup> Includes conserved topsoil.  
<sup>2/</sup> Quantities shown represent volume required to construct 1:3 embankments. Based on 1.33 compaction factor.  
<sup>3/</sup> See Sheet G.4 for riprap ditch details.  
<sup>4/</sup> See Sheets E.2-E.3 for locations of riprap ditches relative to the construction centerline.  
<sup>5/</sup> Based on 1.97 TON/CUYD.

TABULATION OF APPROACH QUANTITIES



7/2012  
B. Wacker  
7/2012  
Checked by:  
N. Bell  
16-Jul-2012 11:50 AM  
Designed by:  
...Approach Roads\dc0908eb.dgn





STATE	PROJECT	SHEET NUMBER
AK	DEN 2009(8)	E.2

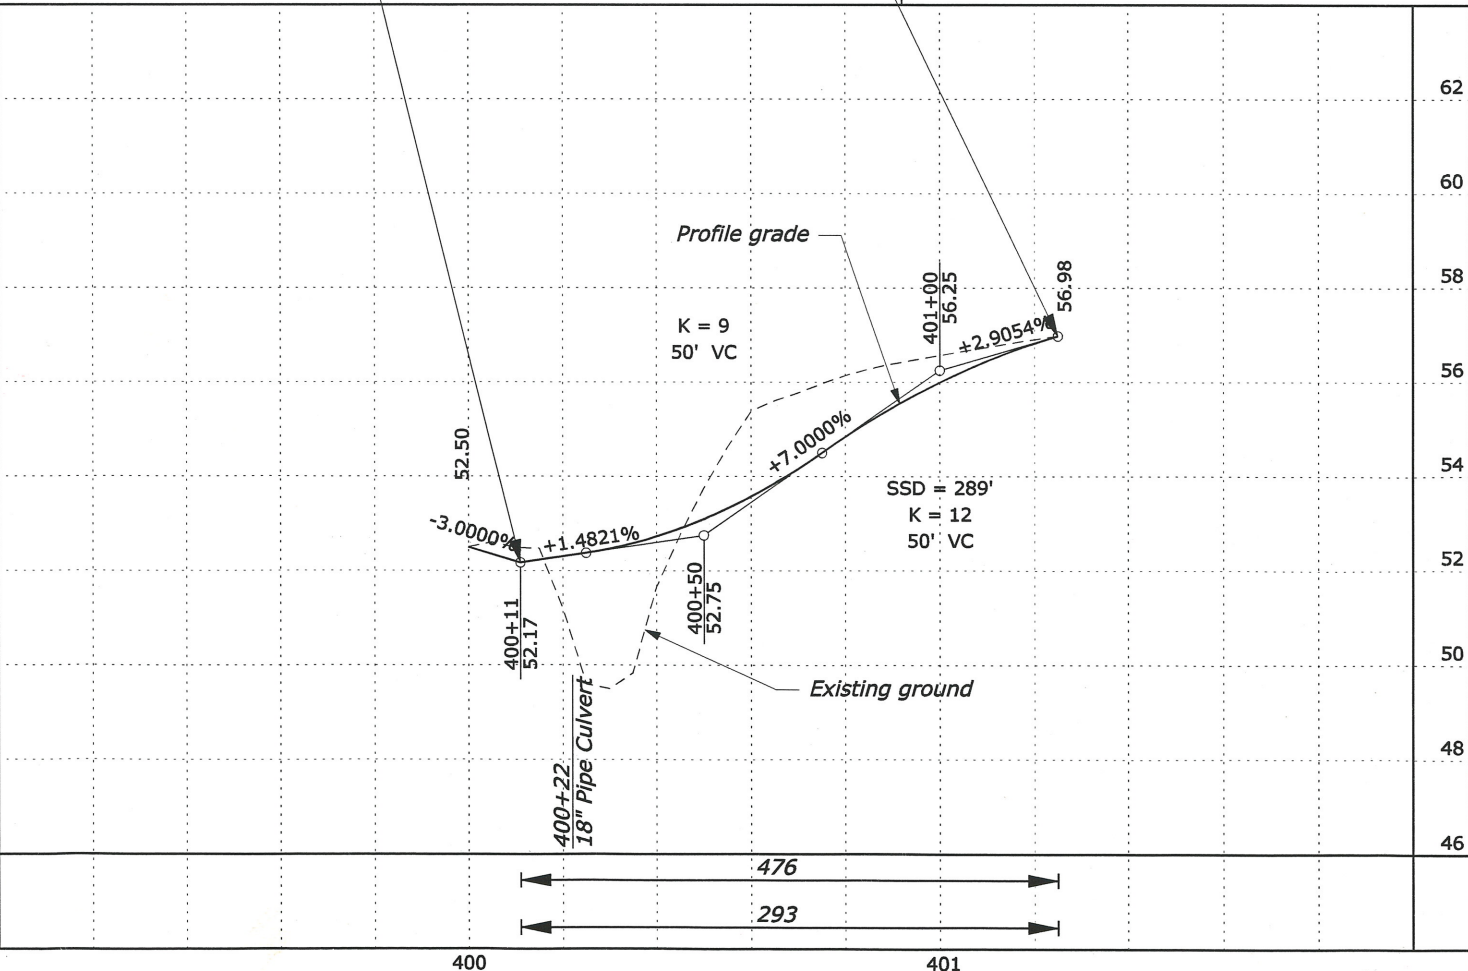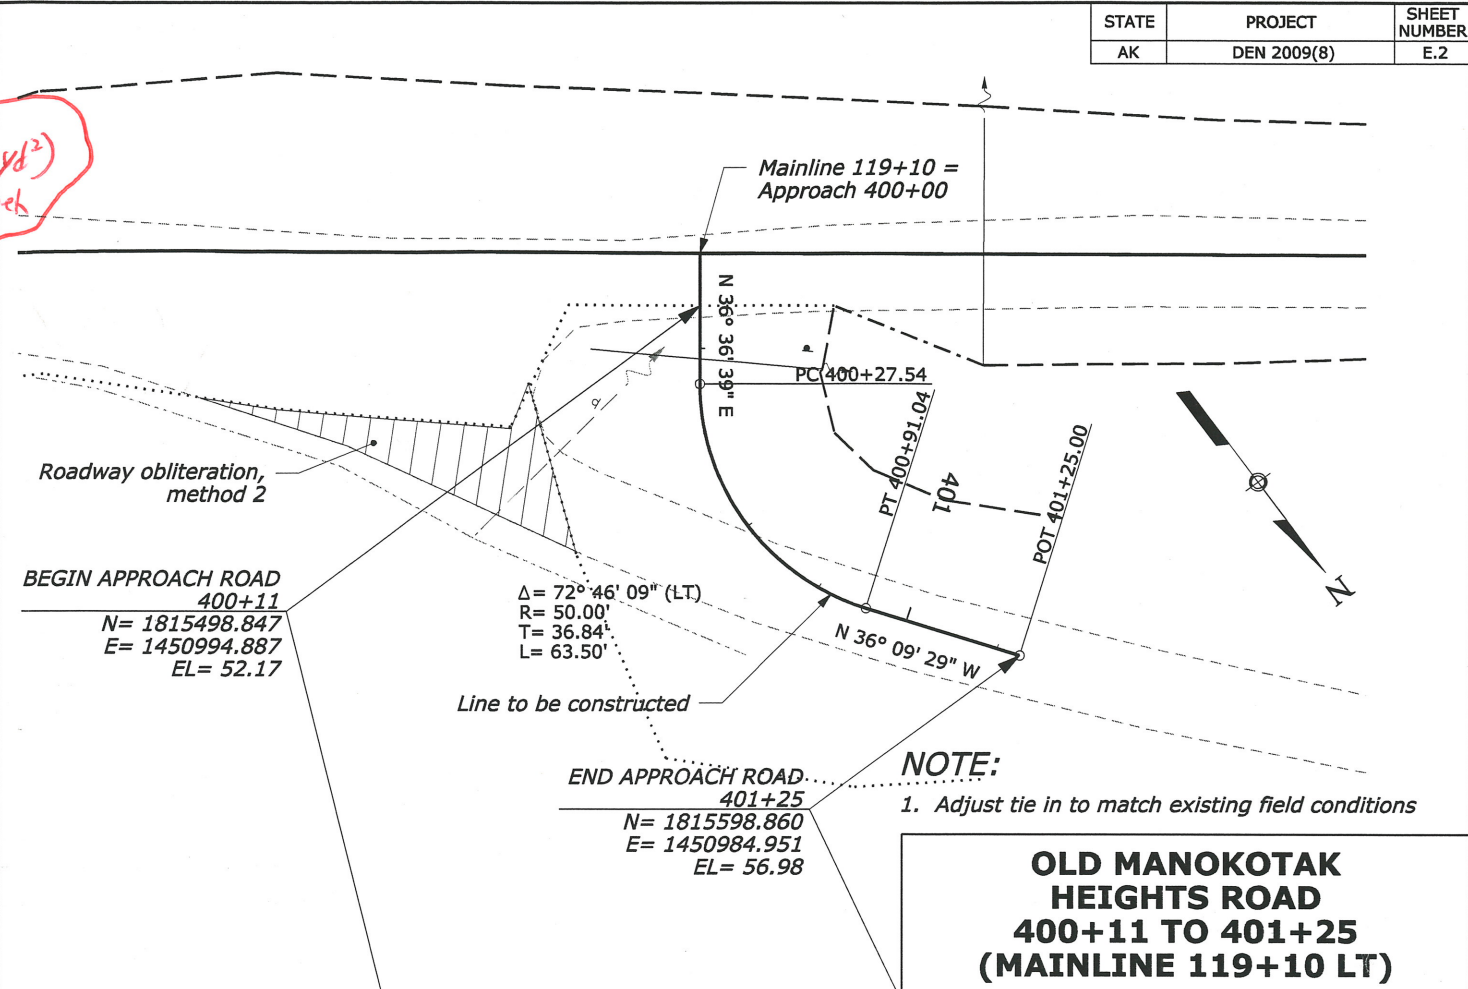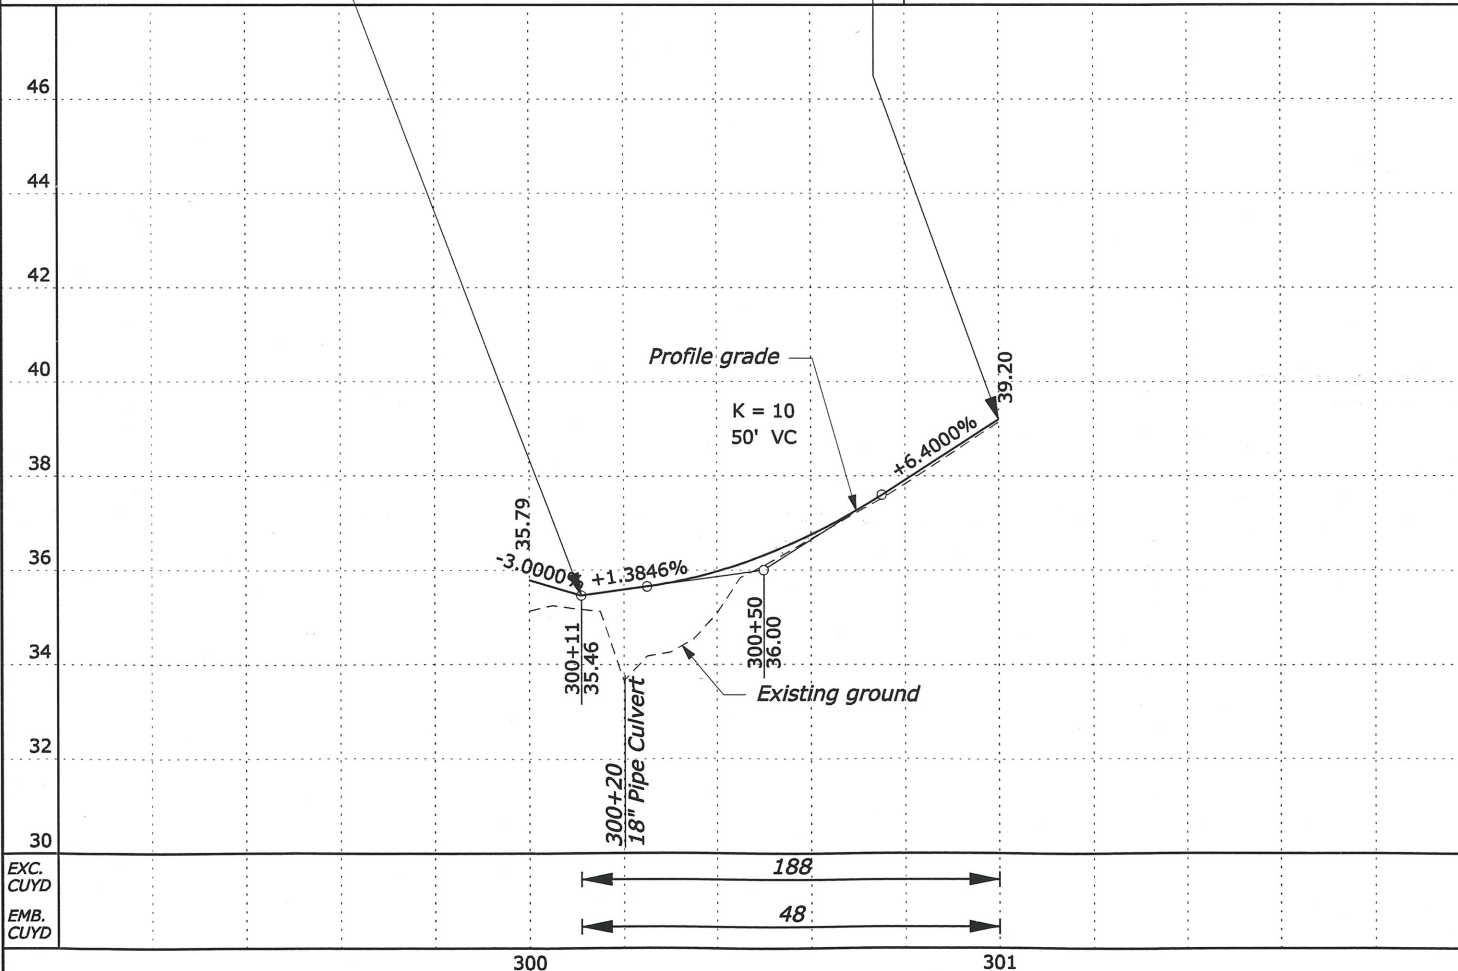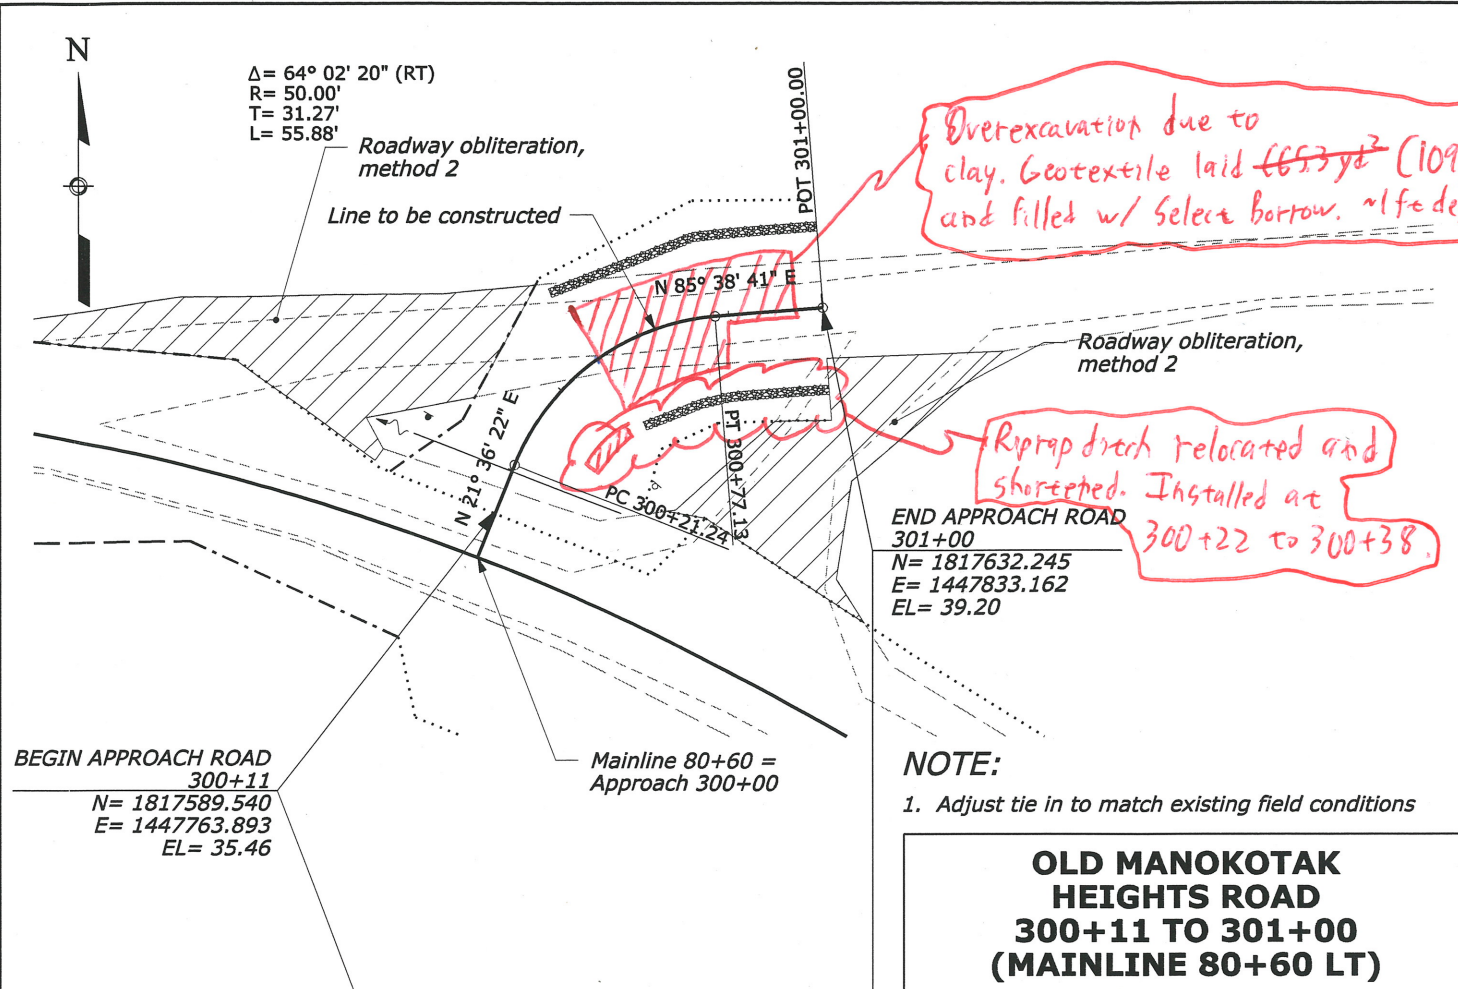



7/2012 B. Wacker 7/2012 Checked by: 7/2012 N. Bell 20-Jul-2012 01:56 PM Designed by: ...Approach Roads\dd0908ec.dgn

STATE	PROJECT	SHEET NUMBER
AK	DEN 2009(8)	E.3

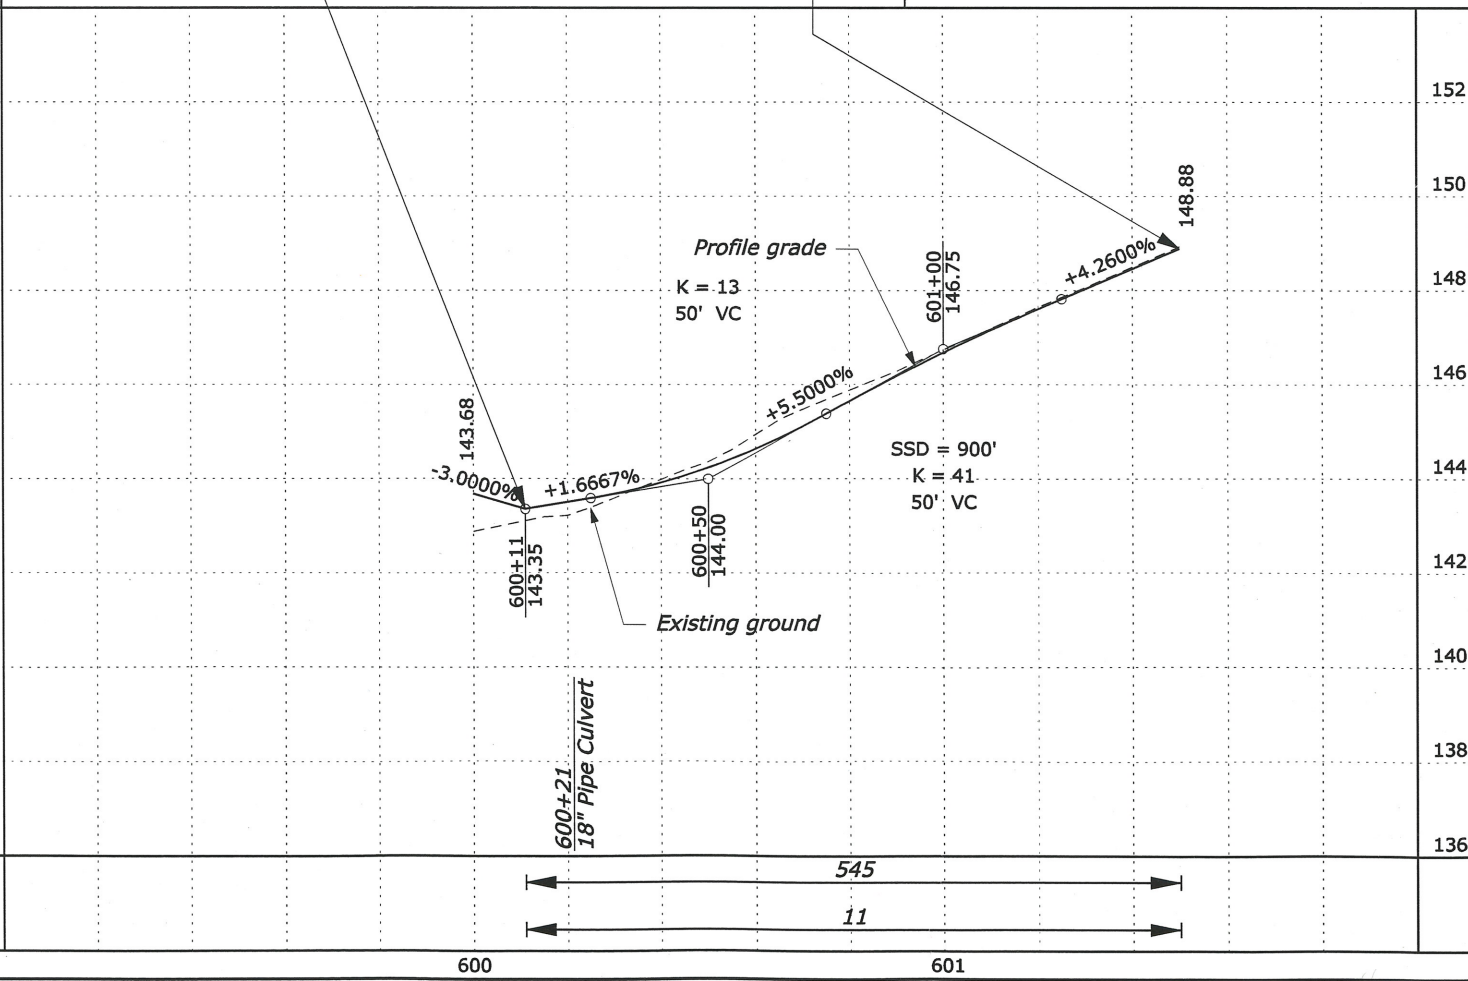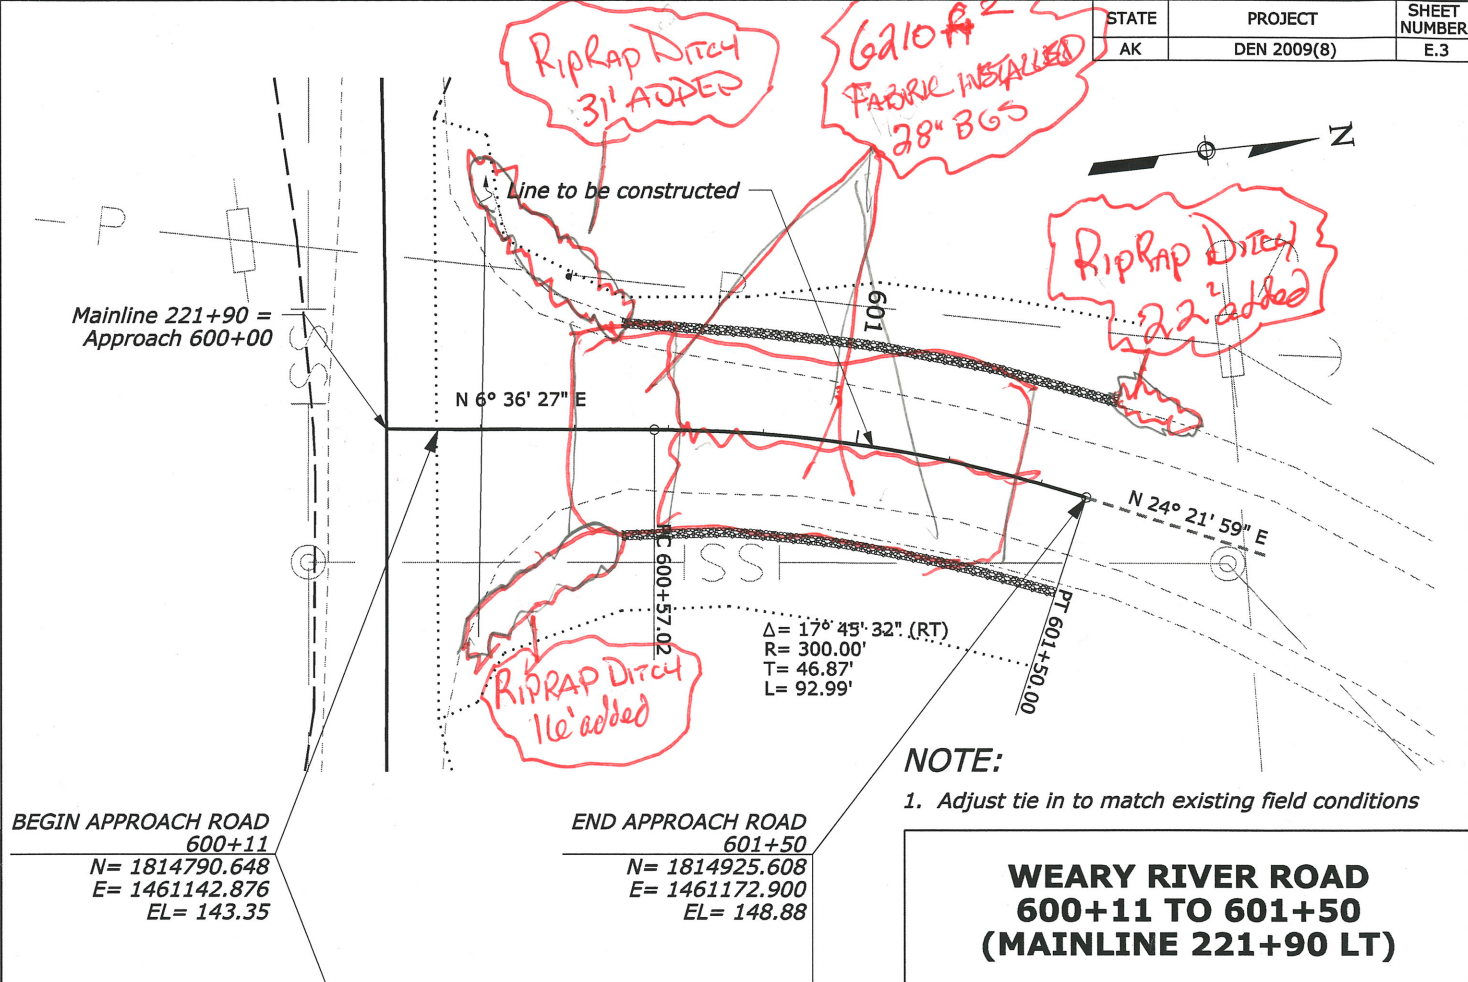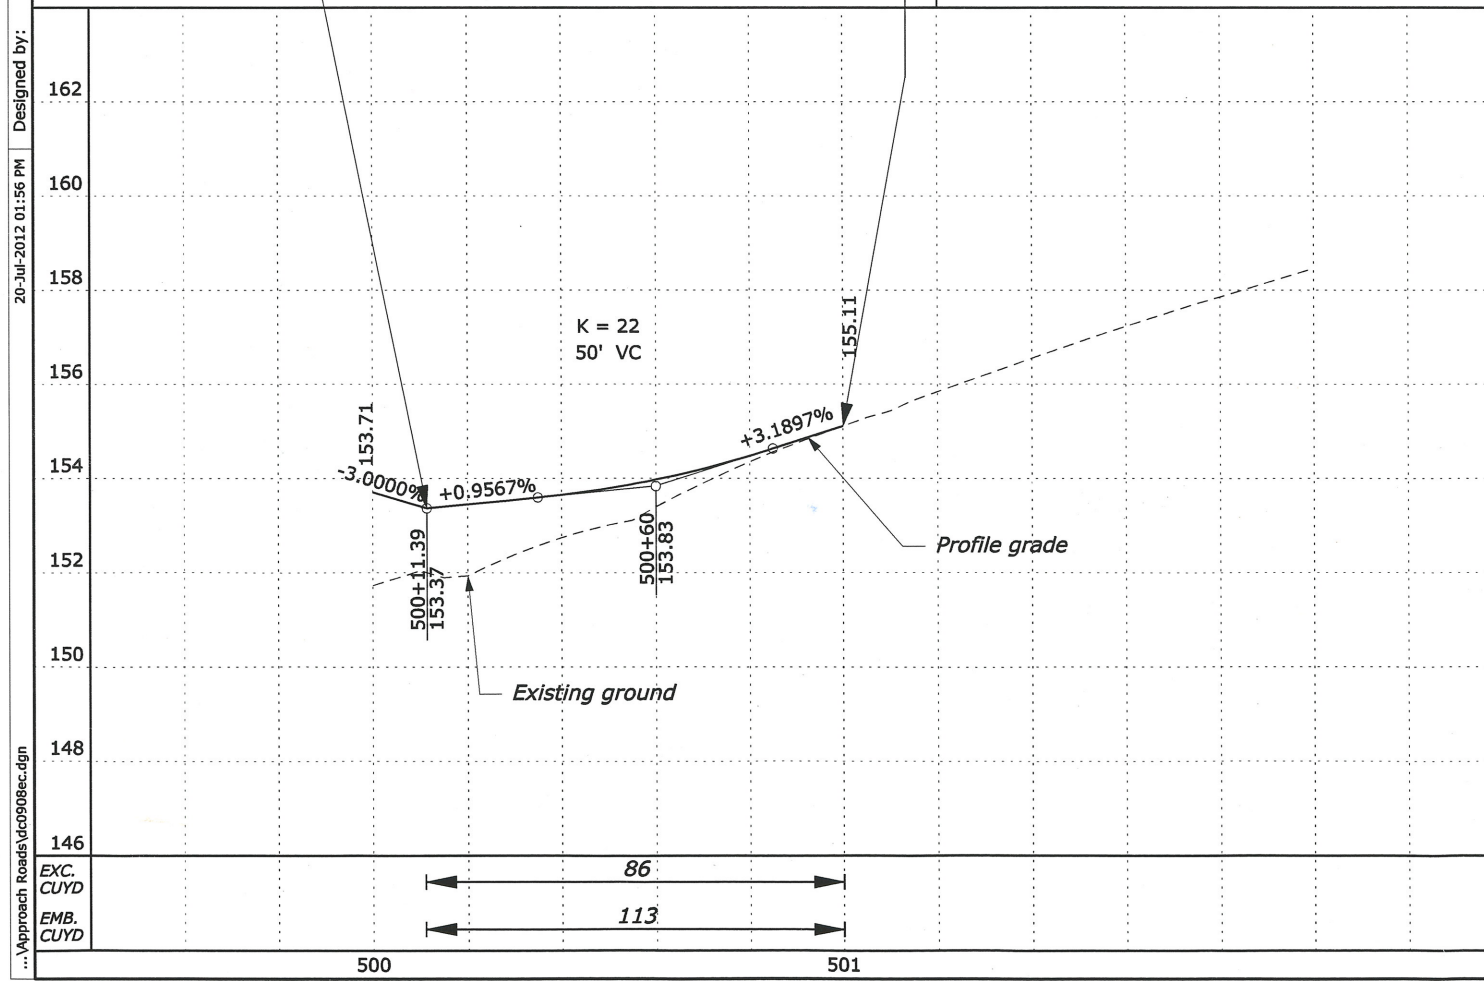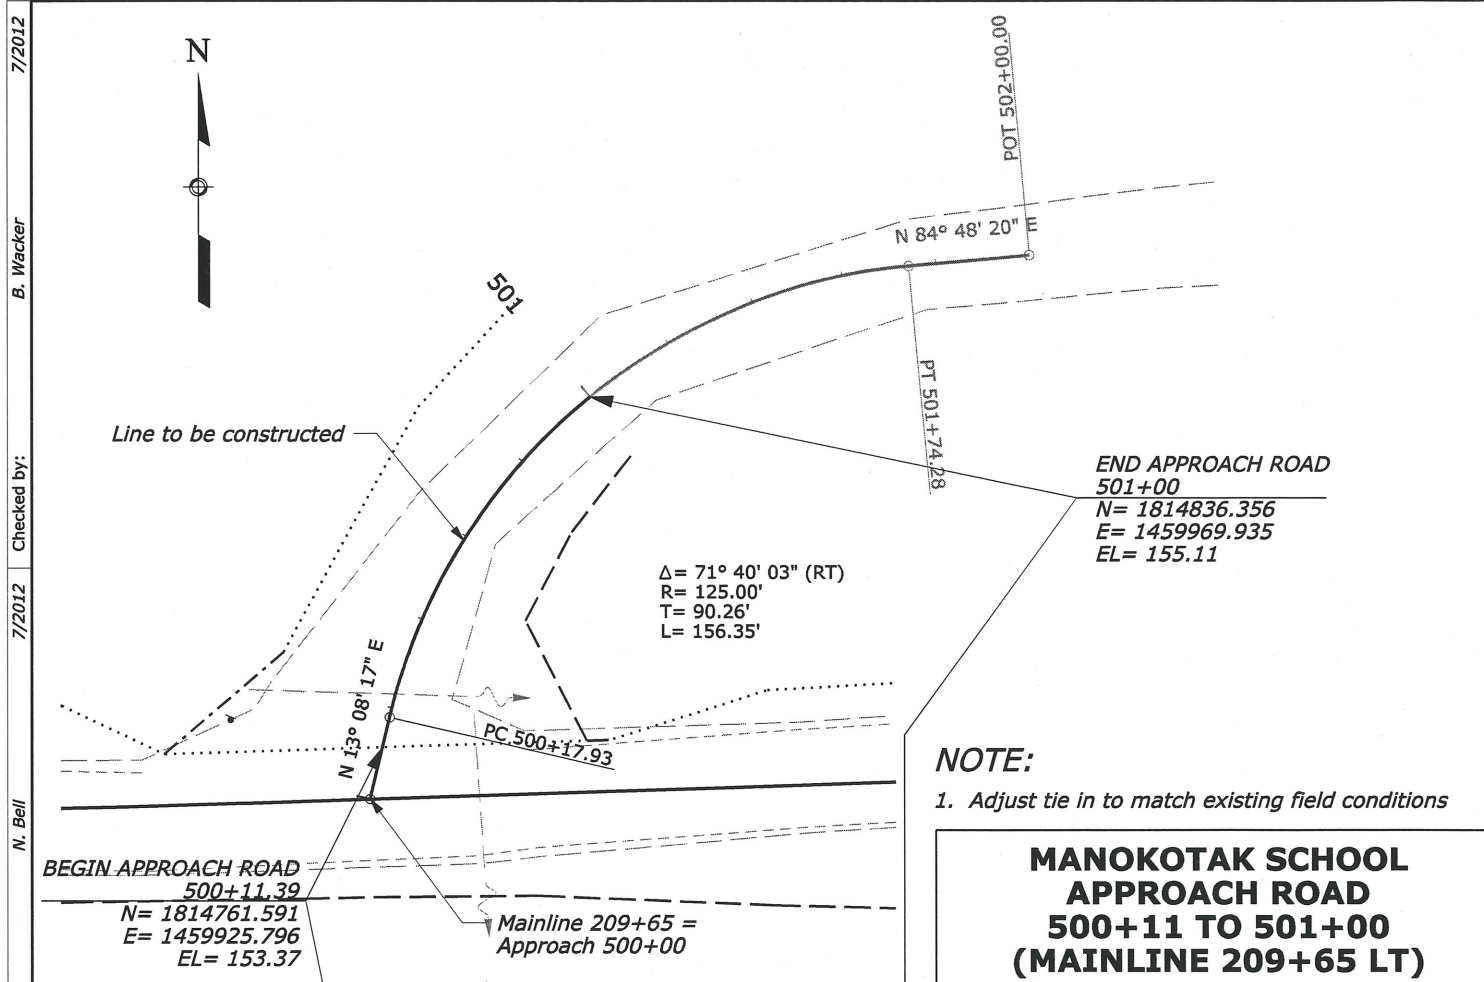





7/2012  
B. Wacker  
Checked by:  
7/2012  
N. Bell  
Designed by:  
20-Jul-2012 02:00 PM  
... \Approach Roads\dc0908ea.dgn

STATE	PROJECT	SHEET NUMBER
AK	DEN 2009(8)	E.4

APPROACH ROAD TABLE						
MAINLINE STATION	Type <sup>1/</sup>	W <sup>1/</sup>	R1 <sup>1/</sup>	R2 <sup>1/</sup>	L <sup>1/</sup>	REMARKS
70+35 LT	A	14	10	10	25	
80+60 LT	B	16	20	20	89	Old Manokotak Heights Road
119+10 LT	B	16	20	20	114	Old Manokotak Heights Road
209+65 LT	B	20	50	25	89	Manokotak School Approach Road
216+64 RT	A	20	25	25	25	
221+90 LT	B	24	50	50	139	Weary River Road
223+68 LT	A	26	15	40	20	
225+06 LT	A	30	30	30	20	
226+66 LT	A	14	15	15	20	
227+66 LT	A	14	20	10	20	
228+43 LT	A	20	20	10	15	
230+45 LT	A	18	10	10	25	

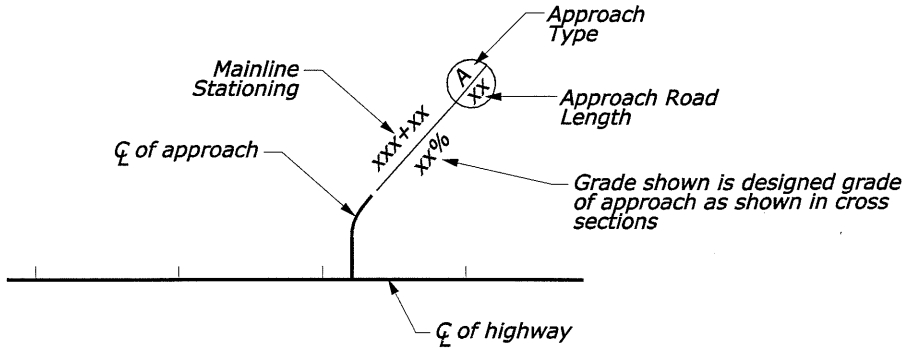

TYPE A APPROACH ROAD LOCATION SYMBOL

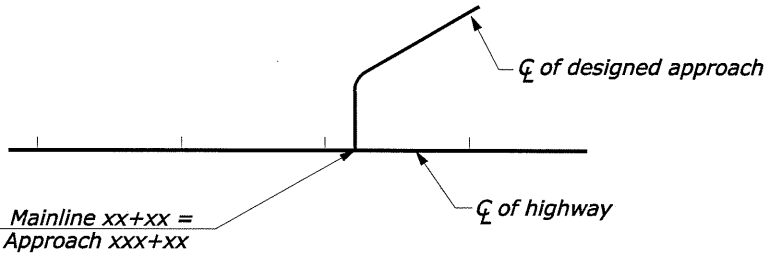

TYPE B APPROACH ROAD LOCATION SYMBOL

FOOTNOTE:  
<sup>1/</sup> See Sheet E.5.


APPROACH ROAD DETAILS

NO SCALE




7/2012 B. Wacker 7/2012 Checked by: 7/2012 N. Bell 22-Jul-2012 01:43 PM Designed by: ...\\Approach Roads\\dc0908ea.dgn


STATE	PROJECT	SHEET NUMBER
AK	DEN 2009(8)	E.5

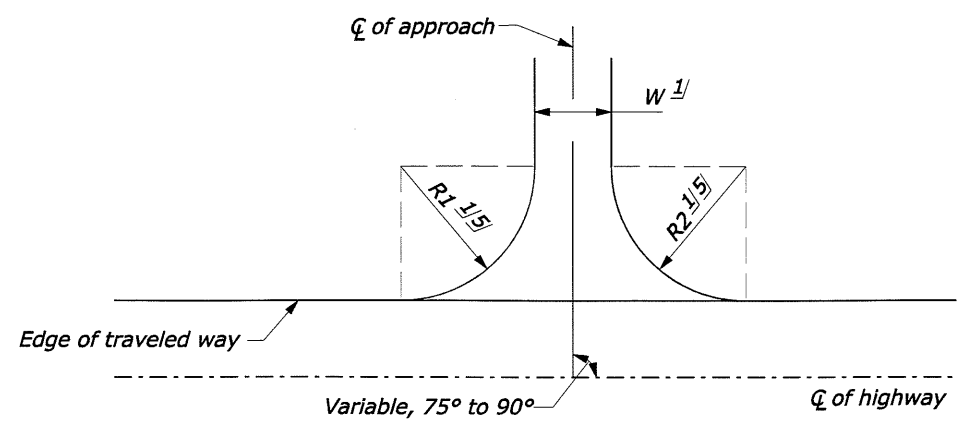


APPROACH ROAD PLAN DETAIL

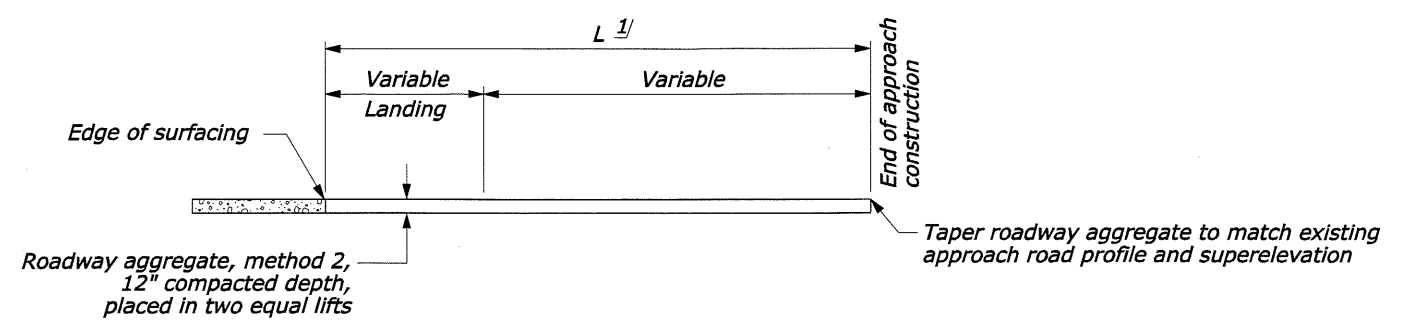

APPROACH ROAD CONNECTION DETAIL

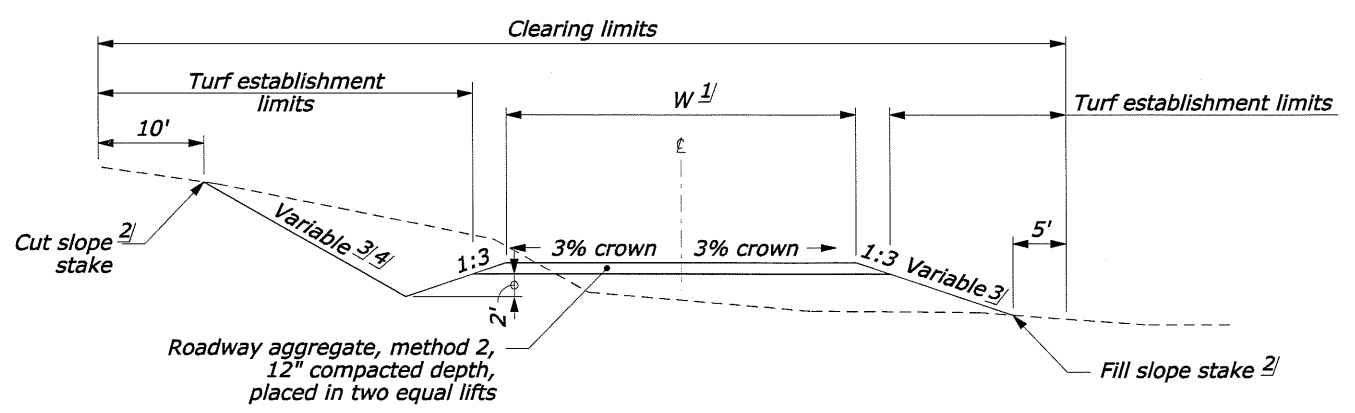

APPROACH ROAD SECTION DETAIL  
TYPES A AND B

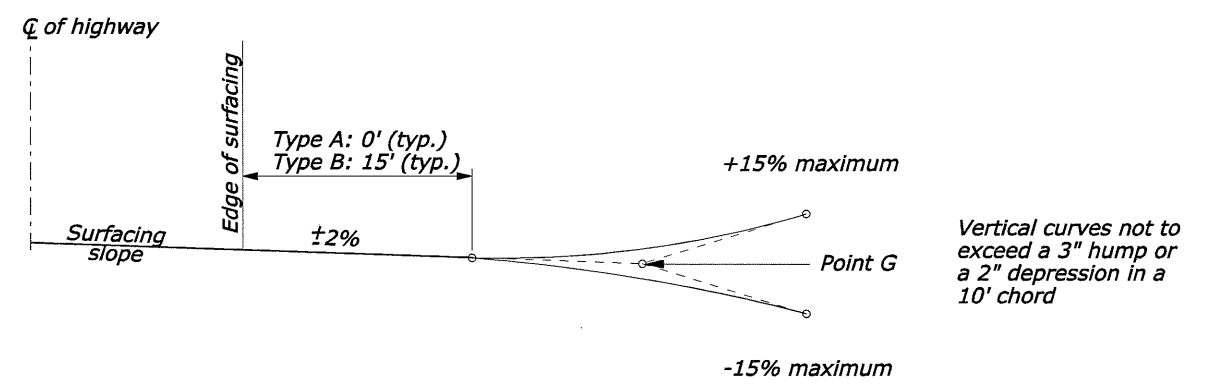

APPROACH ROAD PROFILE DETAIL

FOOTNOTE:

- 1/ See Sheet E.4.
- 2/ Round slopes as shown on Sheet C.2.
- 3/ Construct side slopes of approaches to be compatible with adjacent roadway construction.
- 4/ See Standard 602-6, "Pipe Culvert Inlet Treatment in Cut Slopes."
- 5/ Continue approach radius as required if connection to existing alignment of approach is at an angle.

APPROACH ROAD DETAILS

NO SCALE



TEMPORARY EROSION CONTROL QUANTITIES					
Location	Side	Item 15703-1000 Soil erosion control, soil stabilization, mulching <sup>4/</sup> (ACRE)	Item 15705-1300 Soil erosion control, temporary diversion channel <sup>1/</sup> (LNFT)	Item 15705-1500 Soil erosion control, sediment wattle, government-furnished <sup>2/</sup> (LNFT)	Item 15706-0400 Soil erosion control, sediment trap <sup>3/</sup> (EACH)
1+50 to 81+50	LT/RT	8.02		100.0 <sup>5/</sup>	
4+50 to 67+50	RT			6,441.0	
70+00 to 72+00	RT			165.0	
73+25	LT				1
74+00 to 80+50	LT			677.0	
74+00 to 81+50	RT			745.0	
74+00	RT				1
81+00 to 81+50	LT			48.0	
81+50 to 118+00	LT/RT	2.55			
81+50 to 100+00	RT			1,821.0	
84+00 to 99+00	LT			1,500.0	
99+43	LT/RT		56.0		
102+00 to 104+00	LT			220.0	
104+65	LT/RT		60.0		
105+50 to 115+50	LT			1,000.0	
106+00 to 115+50	RT			950.0	
108+21	LT/RT		53.0		
114+42	LT/RT		89.0		
118+00 to 231+00	LT/RT	11.94		200.0 <sup>5/</sup>	
118+00 to 222+00	RT			10,486.0	
118+30 to 118+80	LT			80.0	
119+30 to 120+20	LT			110.0	
119+55	LT				1
135+50 to 137+00	LT			150.0	
136+81	LT/RT		62.0		
144+07	LT/RT		75.0		
147+98	LT/RT		81.0		
153+72	LT/RT		84.0		
161+33	LT/RT		64.0		
163+52	LT/RT		63.0		
164+00	LT				1
165+58	LT/RT		80.0		
166+00	LT				1
212+50 to 213+00	LT			72.0	
212+68	LT/RT		78.0		
215+50 to 216+00	LT			52.0	
217+95	LT				1
218+00 to 221+50	LT			350.0	
218+64	LT/RT		55.0		
Schedule A Total		22.51	900.0	25,167.0	6
Schedule B Total		19.96	642.0	19,676.0	6
Schedule C Total		11.94	642.0	11,500.0	4

FOOTNOTE:

<sup>1/</sup> See Sheet F.7 for details.  
<sup>2/</sup> See Sheet F.9 for details.  
<sup>3/</sup> See Sheet F.8 for details.  
<sup>4/</sup> Apply to all disturbed areas. See Section 157.  
<sup>5/</sup> For use across ditches at culvert inlets in cut sections as approved by CO. See Sheet F.6.

TABULATION OF EROSION CONTROL QUANTITIES



7/2012 7/2012 7/2012 06-Sep-2012 02:54 PM ...\\Erosion Control\dc0908da.dgn

B. Wacker

Checked by:

N. Bell

Designed by:

EROSION CONTROL LEGEND:

Delineated wetland  
Sediment wattle  
Sediment trap  
Temporary diversion channel  
Soil stabilization, mulching, seeding  
Runoff direction

STATE	PROJECT	SHEET NUMBER
AK	DEN 2009(8)	F.2

BEGIN PROJECT AK DEN 2009(8)  
MANOKOTAK HEIGHTS  
ROAD RECONSTRUCTION  
BEGIN SCHEDULES A & B  
1+50.00



NOTE:  
Contours shown represent existing topography,  
prior to construction.

Install sediment wattle

Install sediment wattle

EROSION CONTROL PLANS  
1+50 TO 55+00



STATE	PROJECT	SHEET NUMBER
AK	DEN 2009(8)	F.3

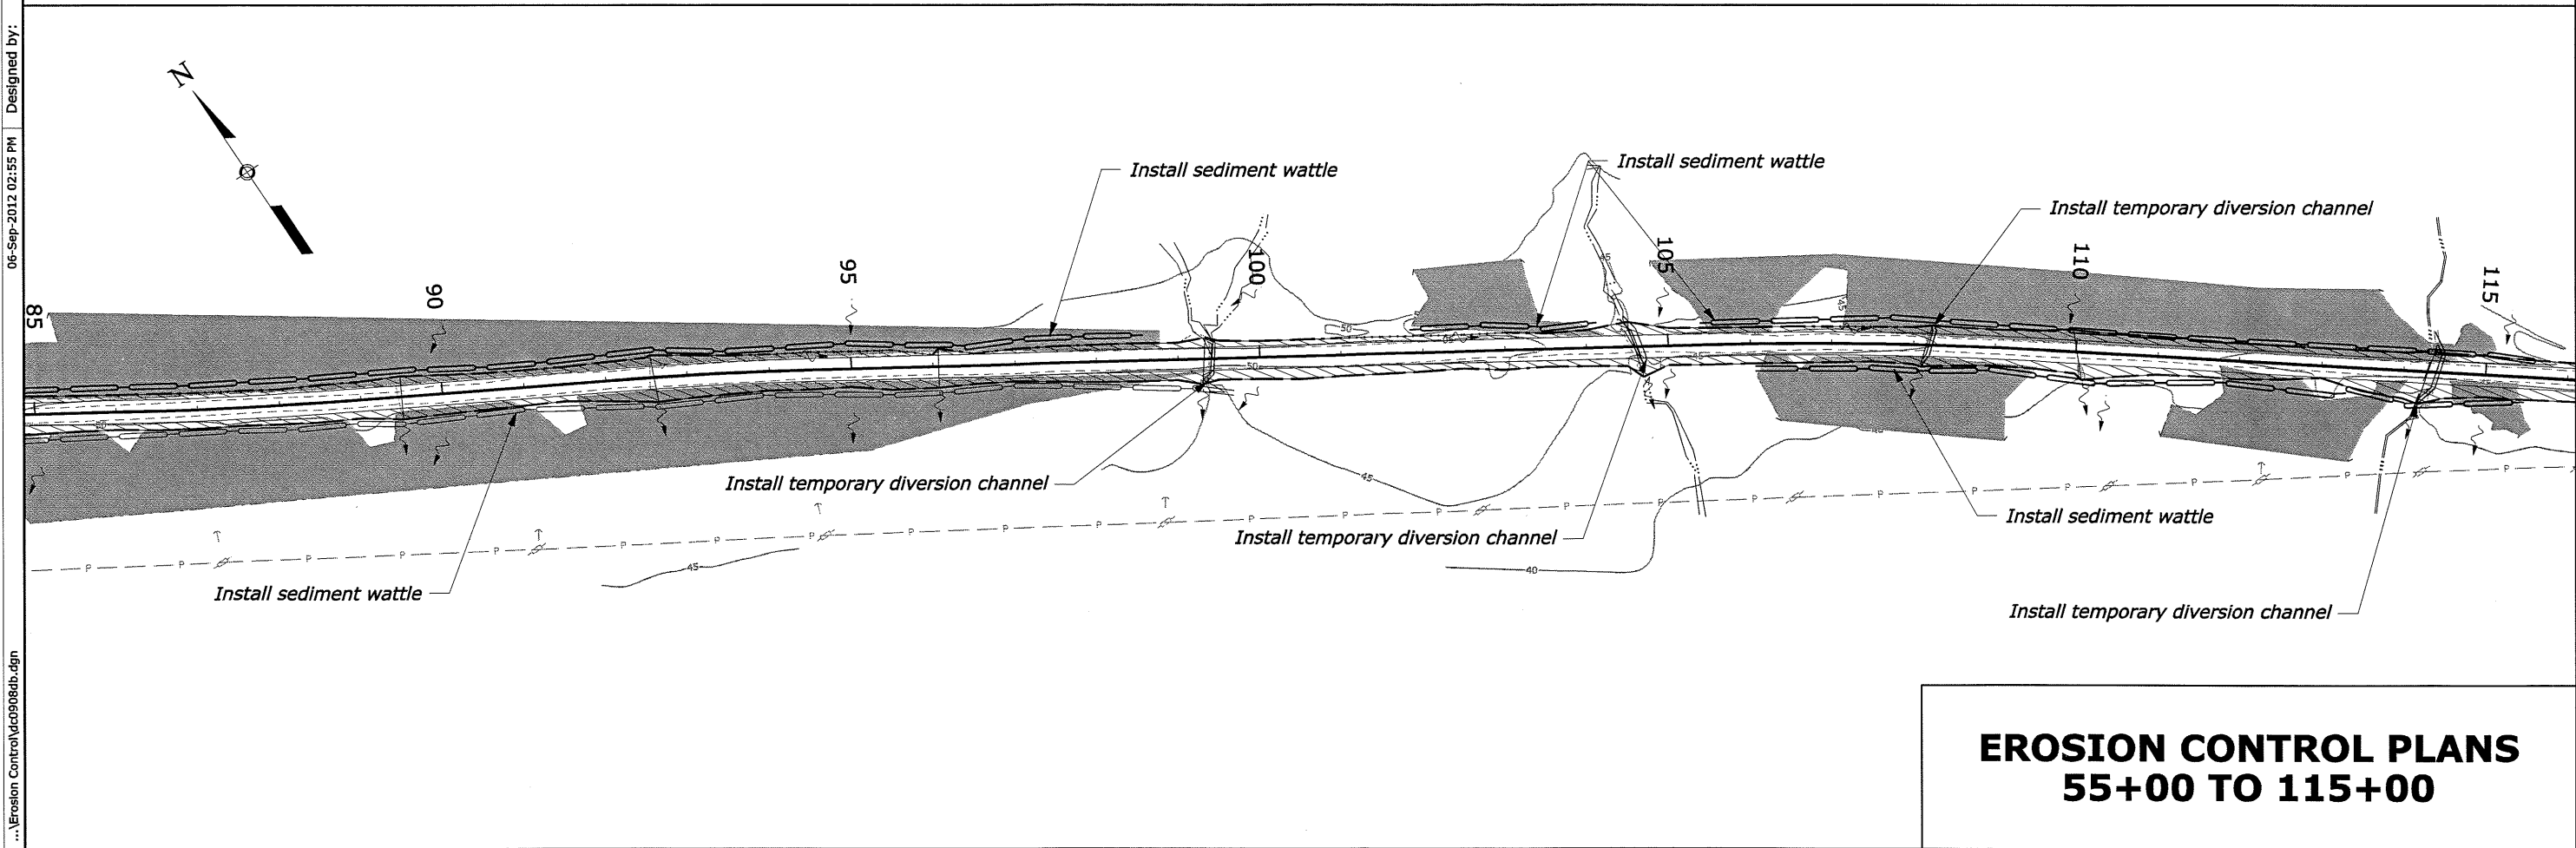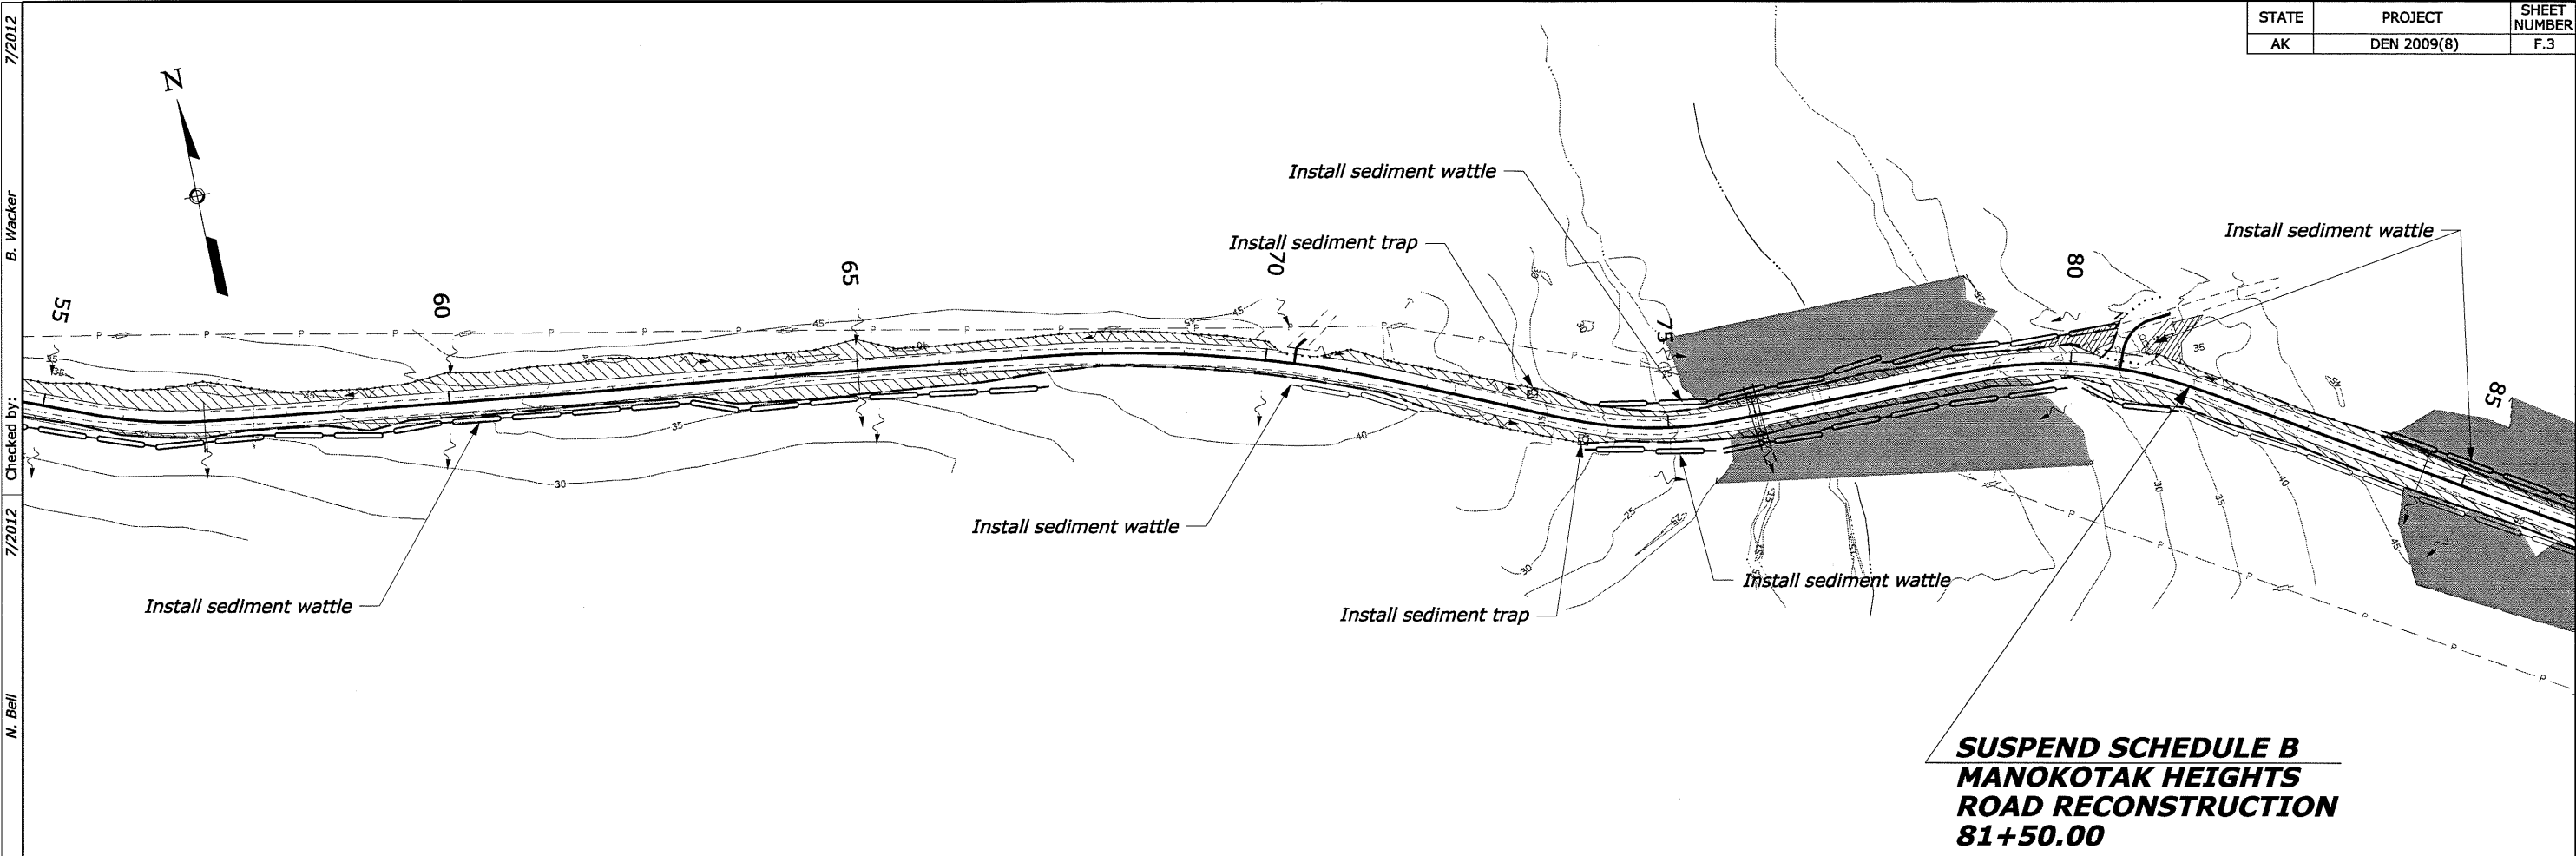





7/2012  
B. Wacker  
7/2012  
Checked by:  
N. Bell  
06-Sep-2012 02:57 PM  
Designed by:  
...\\Erosion Control\dc0908dc.dgn

STATE	PROJECT	SHEET NUMBER
AK	DEN 2009(8)	F.4

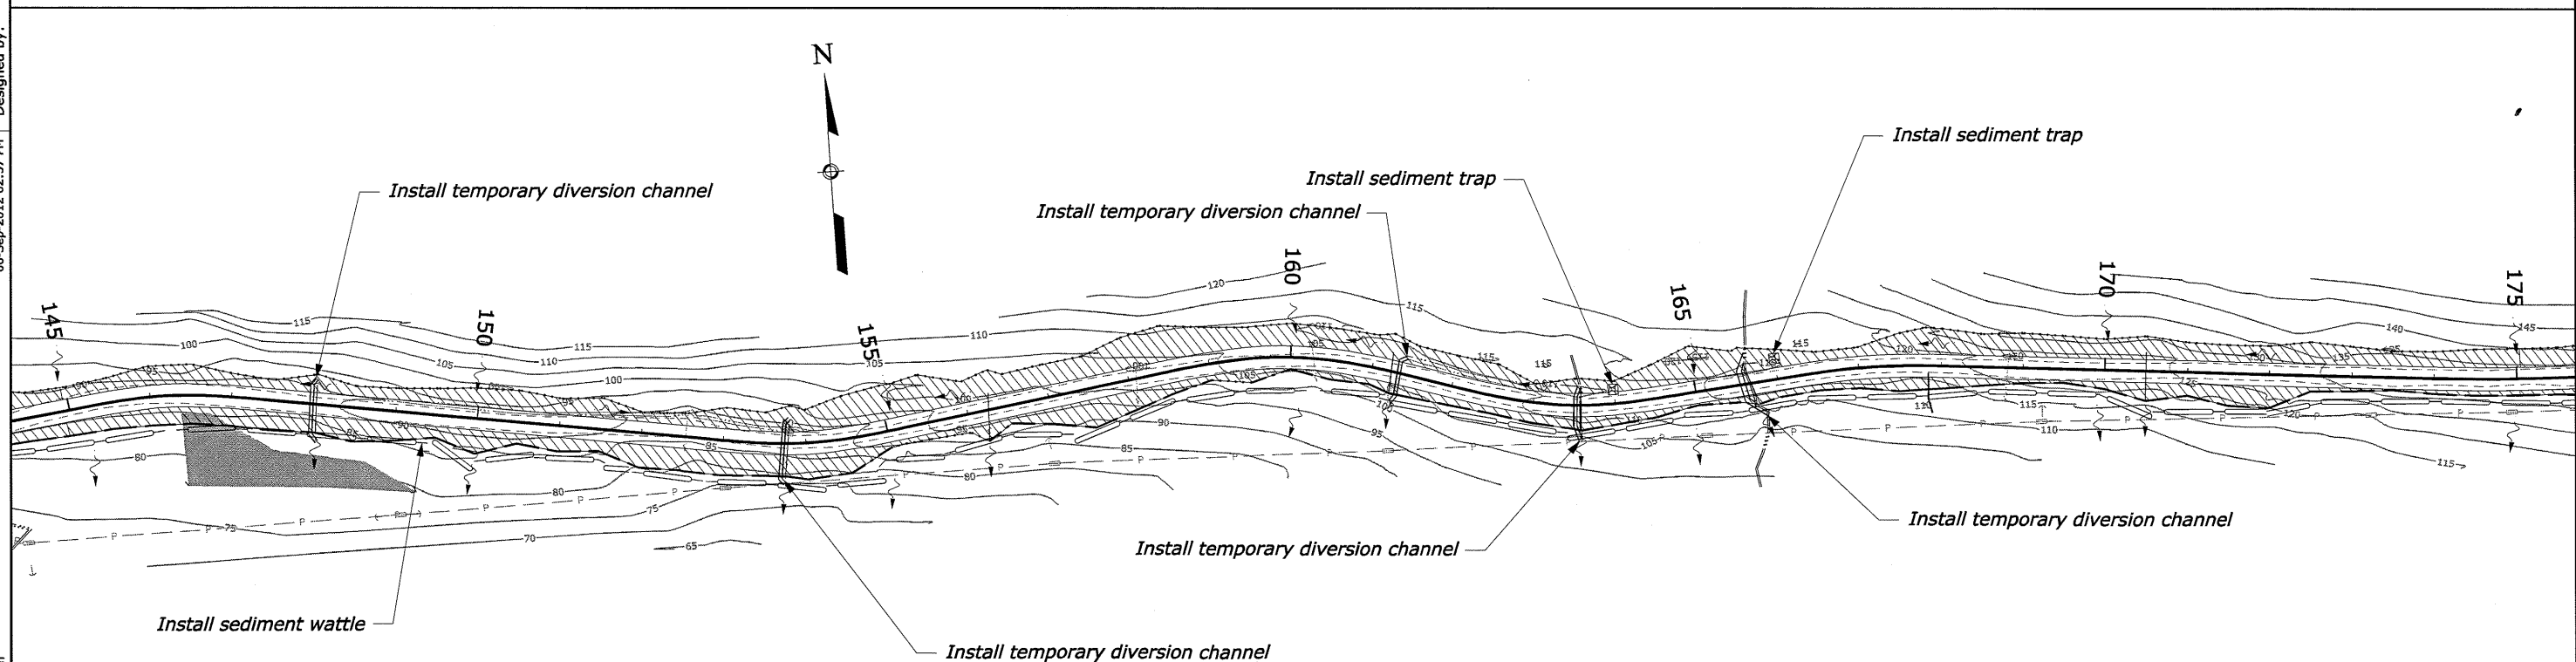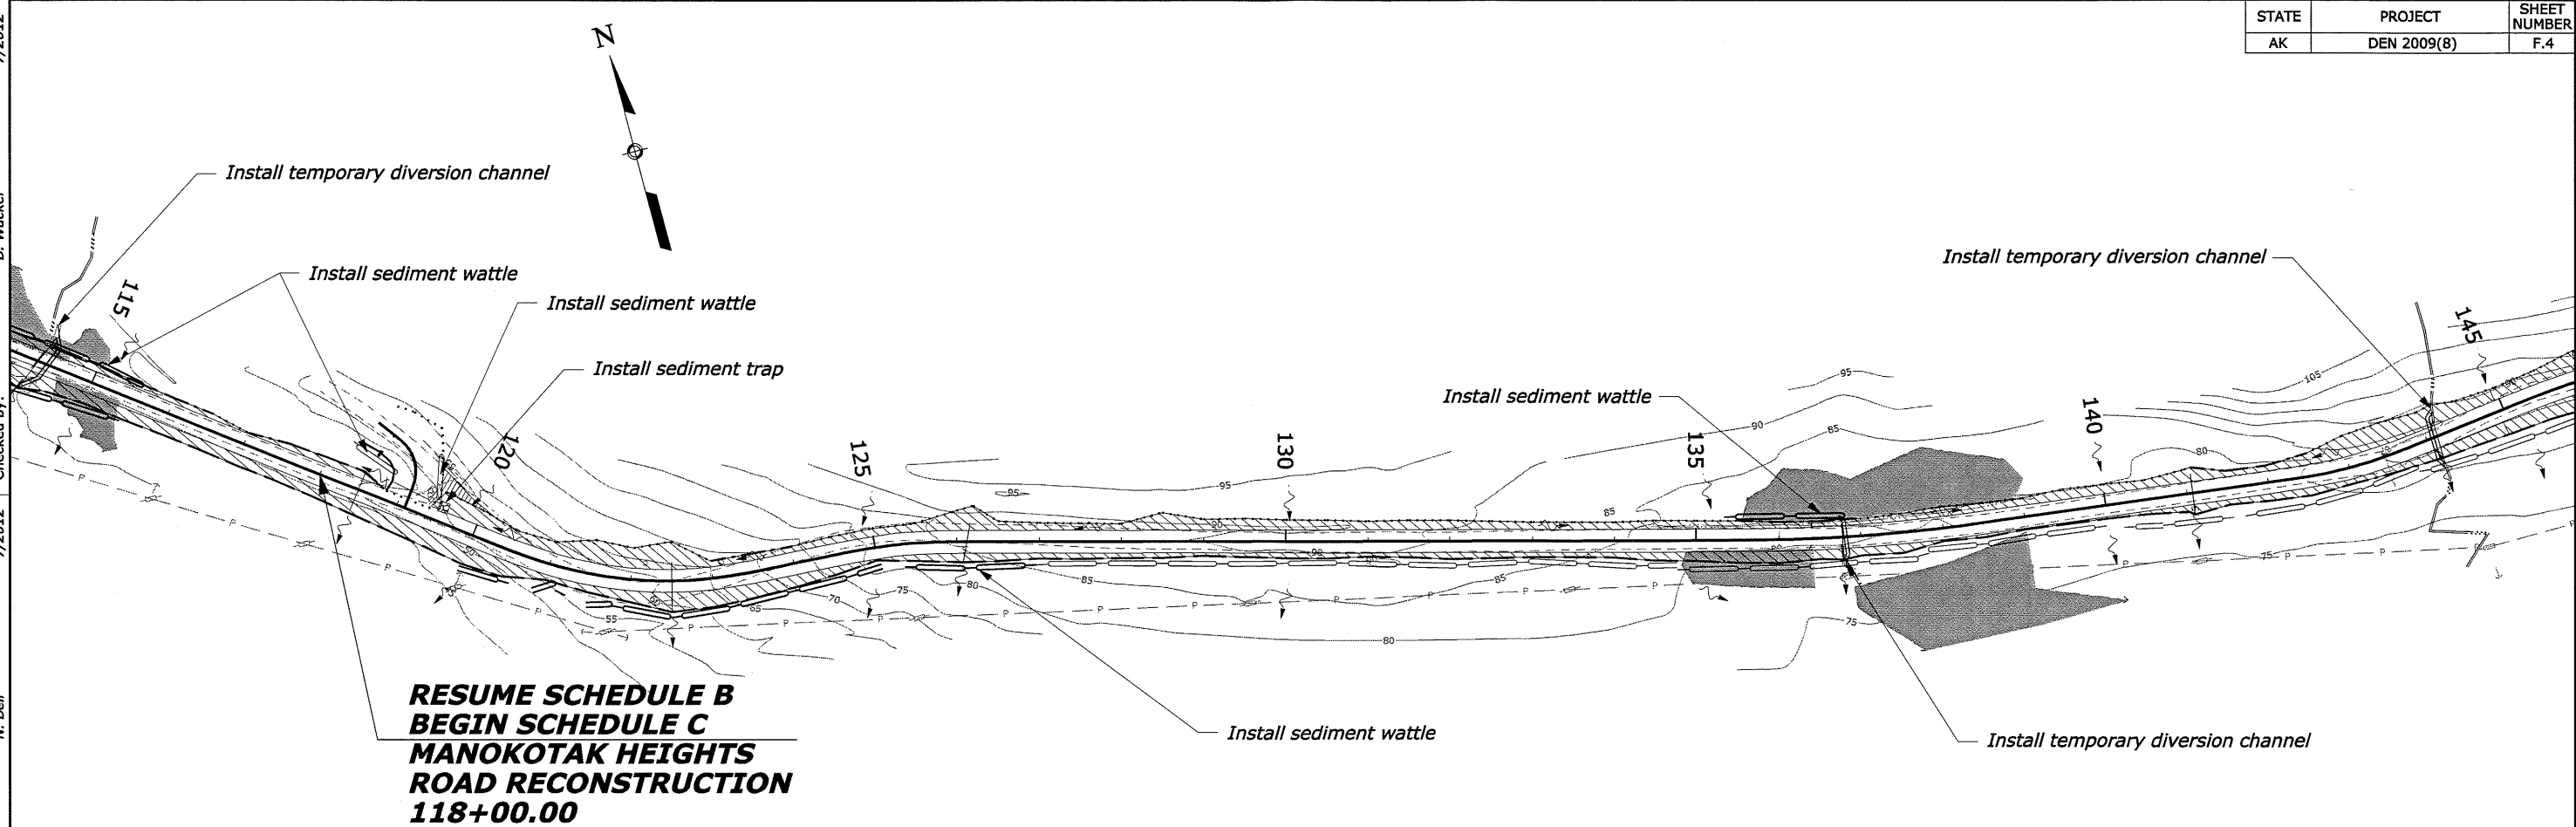

STATE	PROJECT	SHEET NUMBER
AK	DEN 2009(8)	F.5

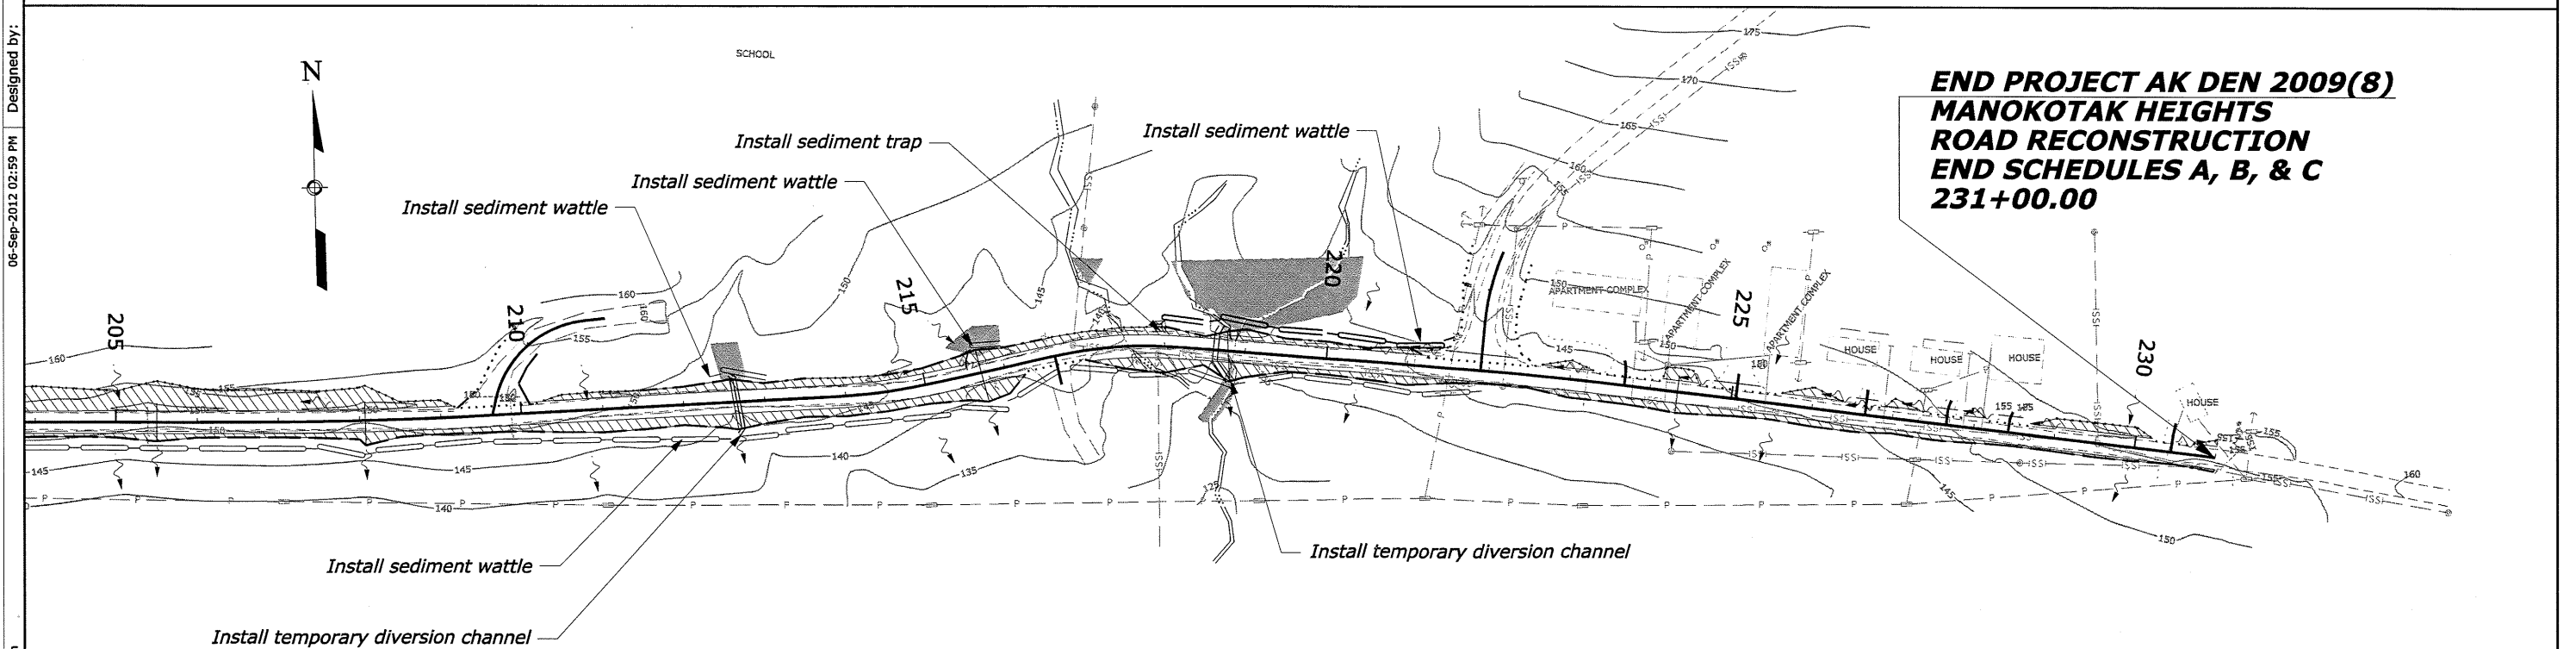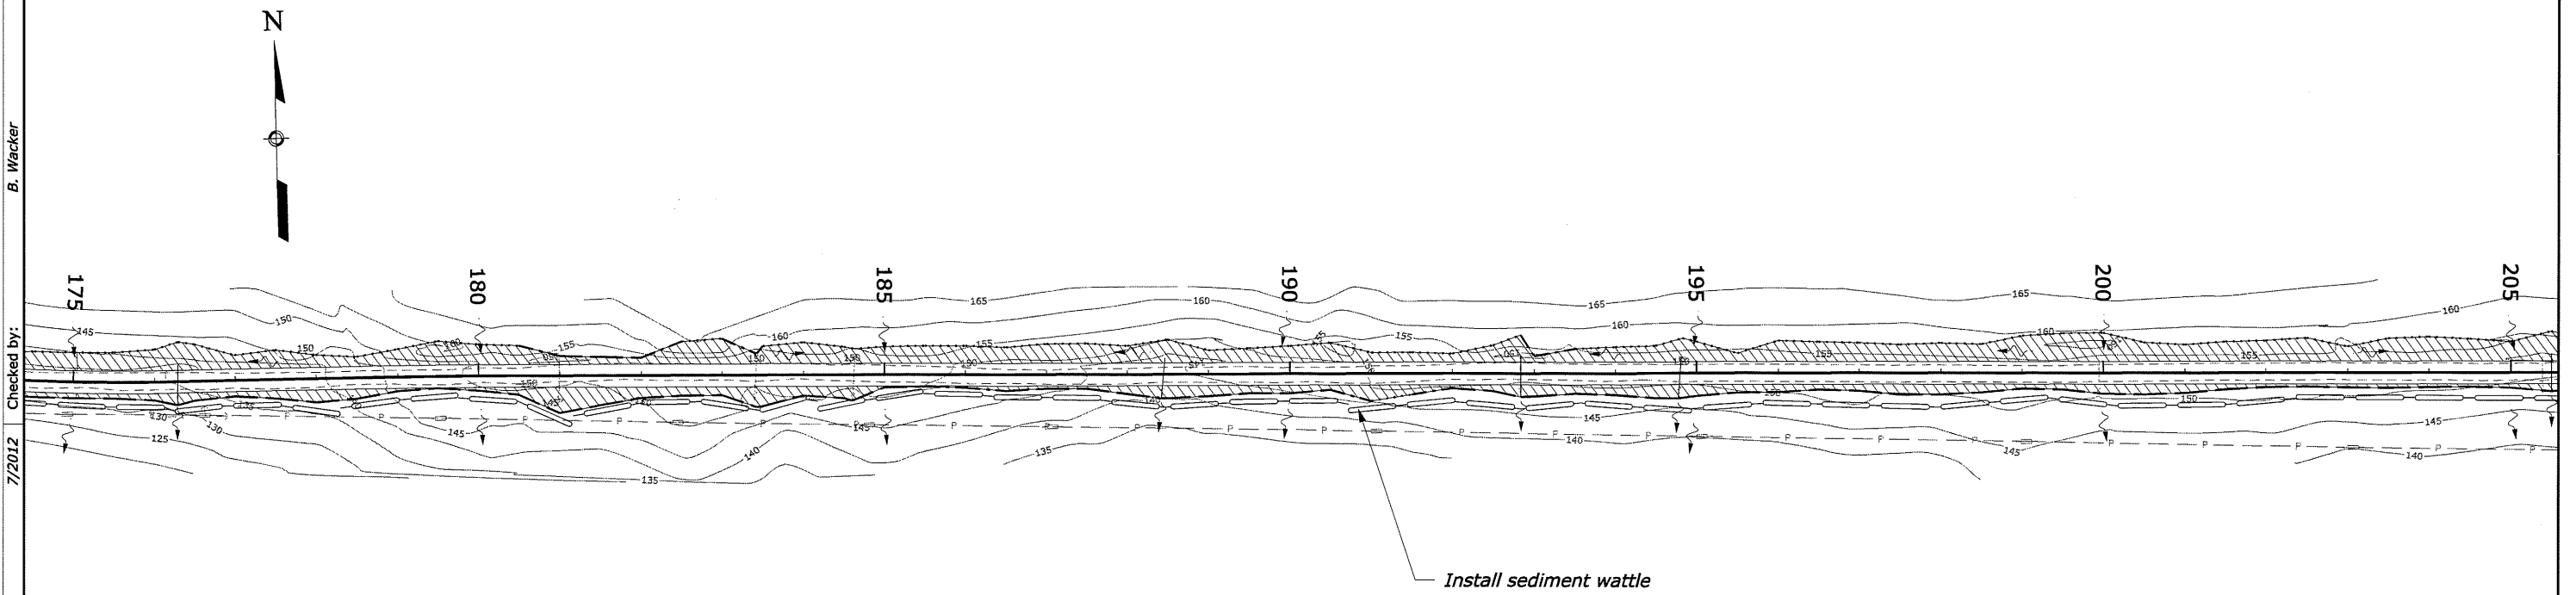

**END PROJECT AK DEN 2009(8)**  
**MANOKOTAK HEIGHTS**  
**ROAD RECONSTRUCTION**  
**END SCHEDULES A, B, & C**  
**231+00.00**

## EROSION CONTROL PLANS 175+00 TO 231+00



7/2012 7/2012 7/2012 15-Aug-2012 04:33 PM ...\\Erosion Control\dc0908dh.dgn

B. Wacker


Checked by:

7/2012


N. Bell

Designed by:

STATE	PROJECT	SHEET NUMBER
AK	DEN 2009(8)	F.6

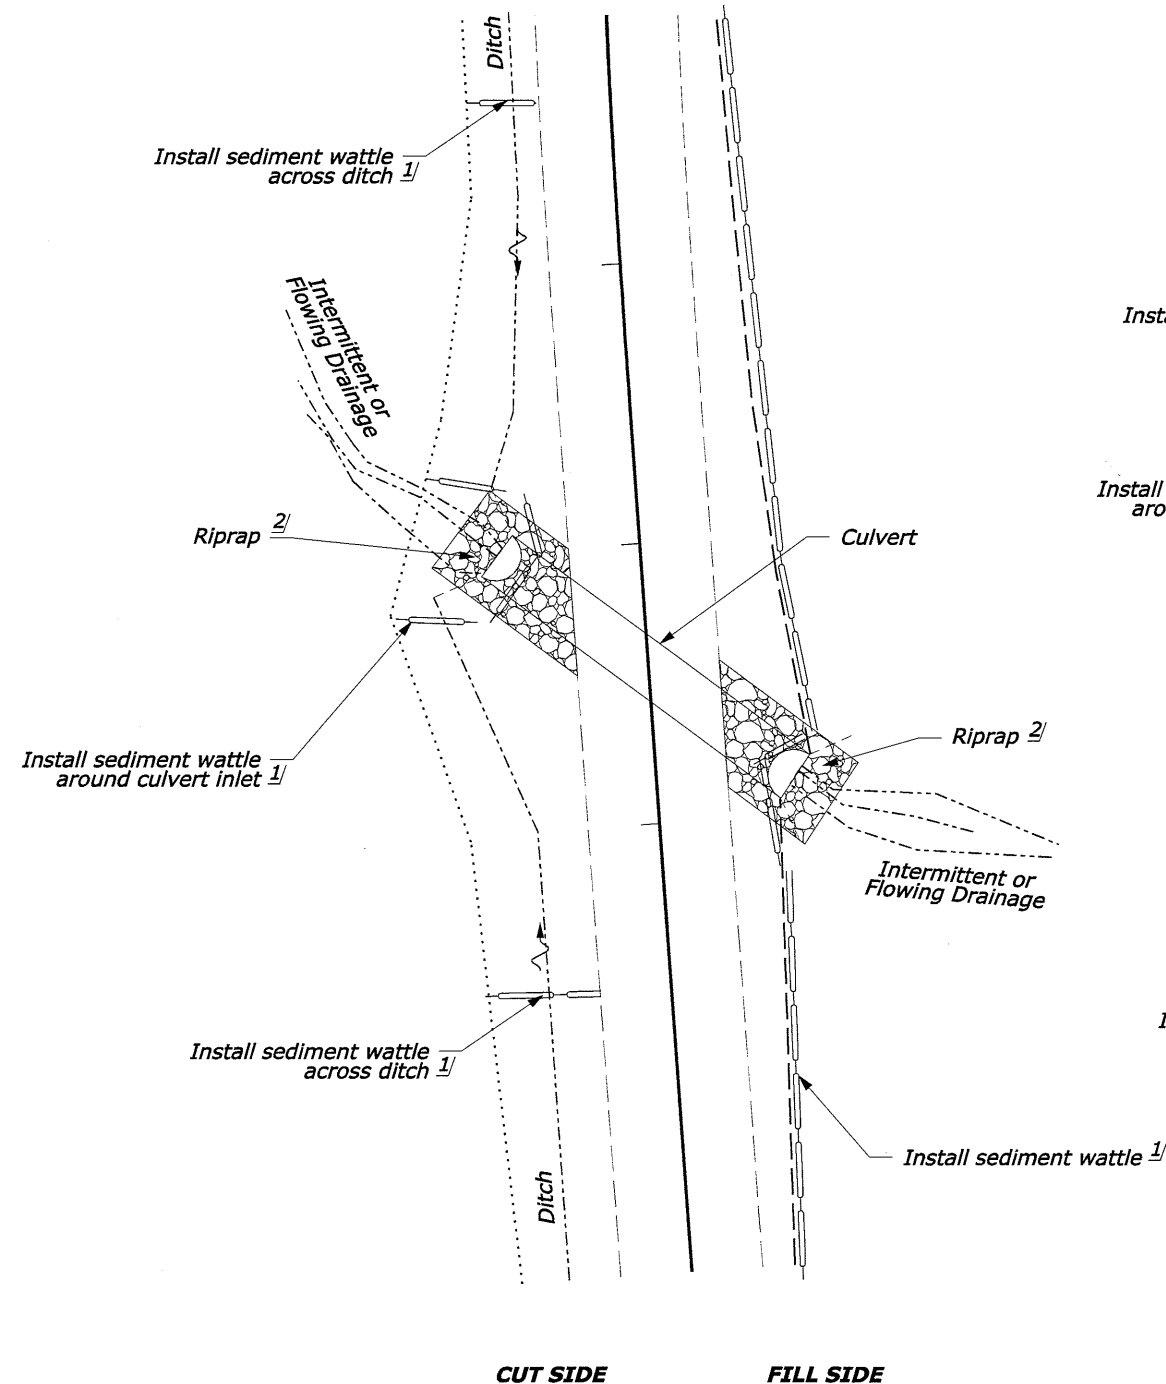

**TYPICAL SEDIMENT WATTLE  
PLACEMENT AT CULVERTS  
WITHIN FLOWING DRAINAGES**

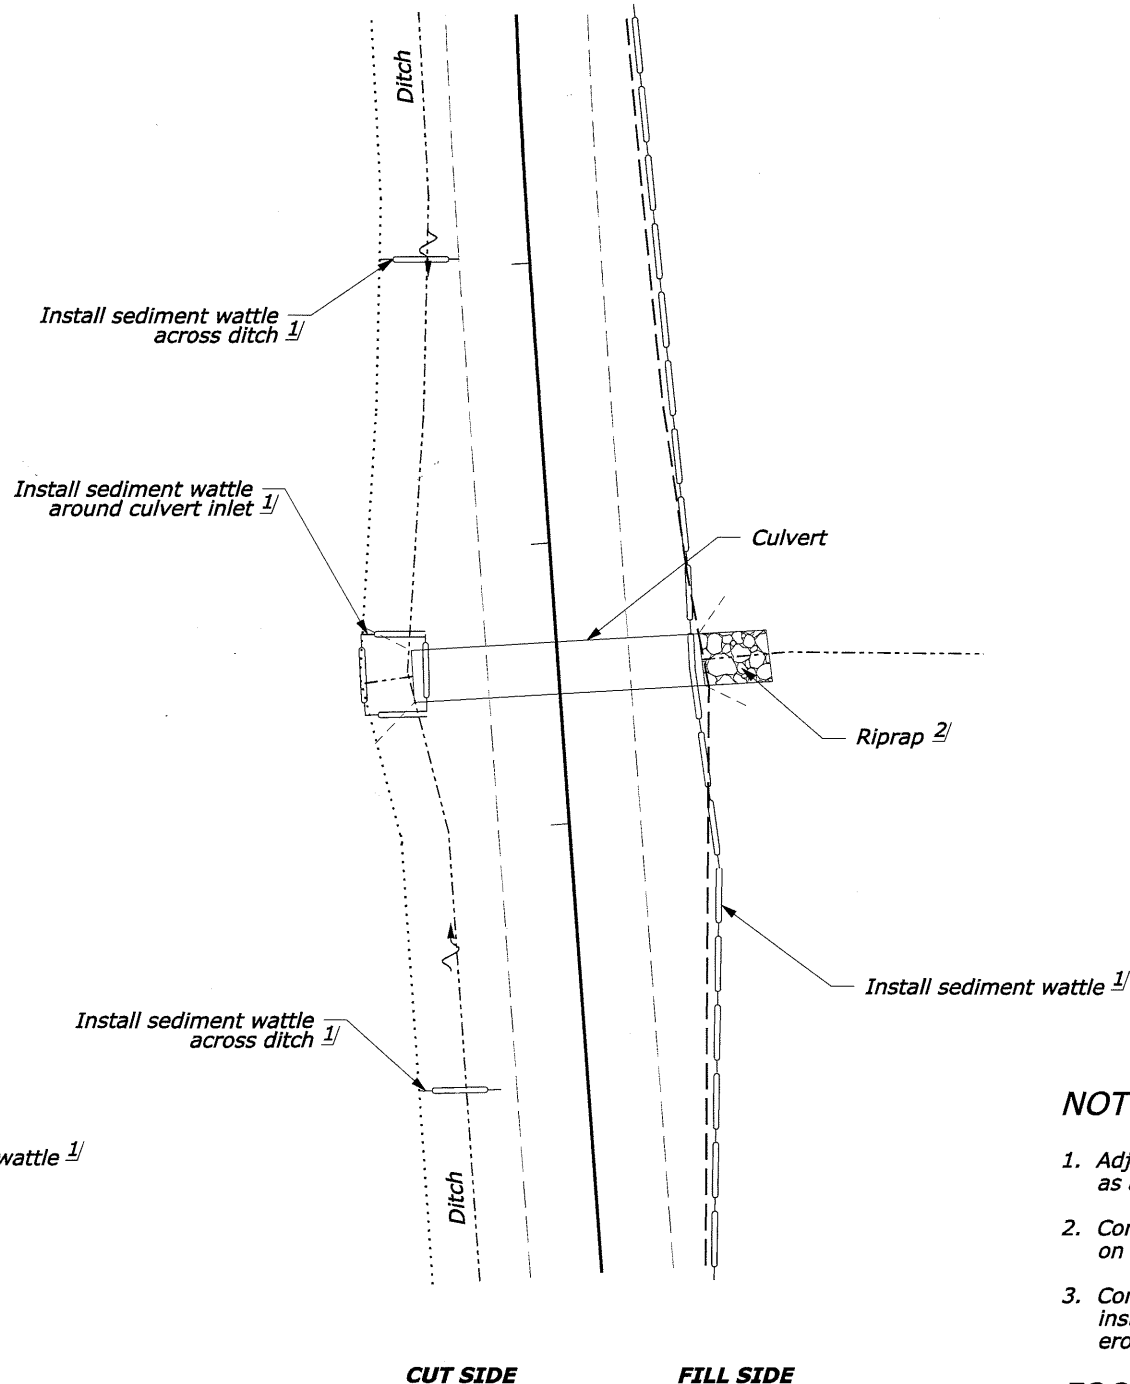

**TYPICAL SEDIMENT WATTLE  
PLACEMENT AT CULVERTS**

**NOTE:**

1. Adjust locations throughout project to fit field conditions as approved by CO.
2. Construct inlet/outlet protection at each culvert as specified on Sheets G.1-G.2.
3. Construct culvert outlet energy dissipators at time of culvert installation. Energy dissipators serve as an outlet erosion/sediment control.

**FOOTNOTE:**

- <sup>1/</sup> See Sheet F.1 for locations and quantities. Install wattles across ditch in 50' intervals as approved by CO.
- <sup>2/</sup> See Sheets G.1-G.2 for riprap inlet/outlet protection locations.


NO SCALE

**SEDIMENT WATTLES  
AT CULVERTS**





STATE	PROJECT	SHEET NUMBER
AK	DEN 2009(8)	F.8

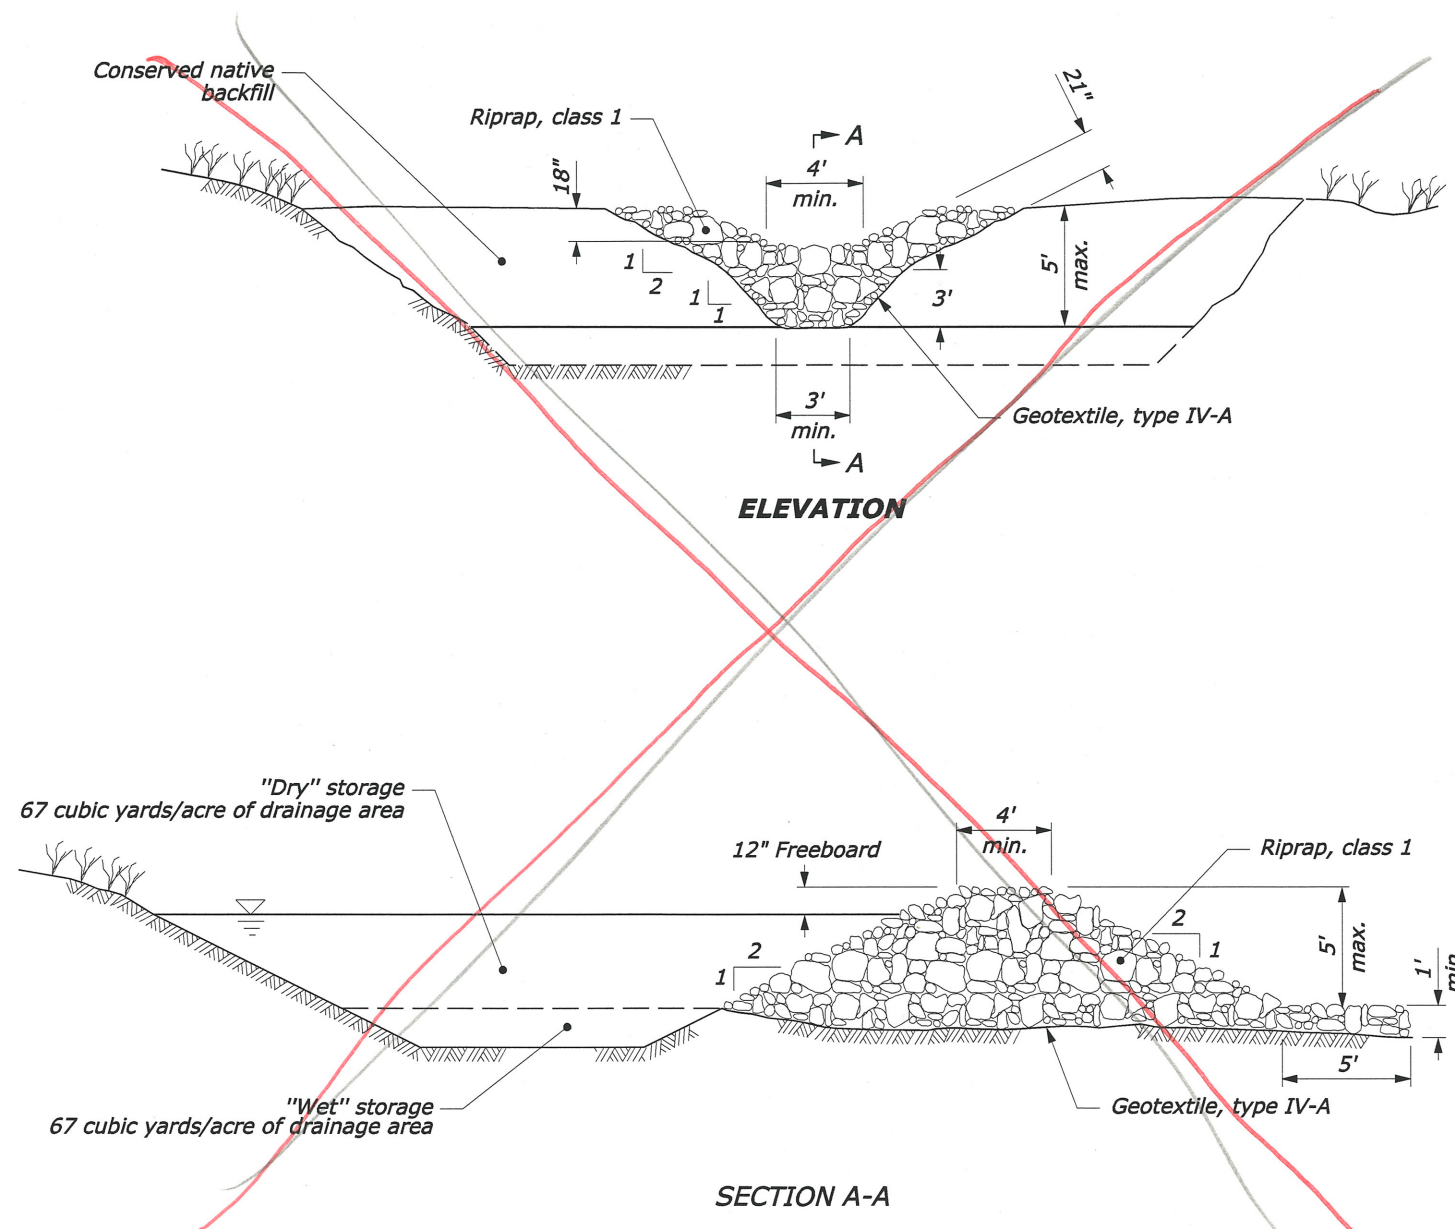


NOT INCORPORATED INTO PROJECT

**NOTE:**


1. See Section 157.
2. See Sheet F.1 for sediment trap locations.

**SEDIMENT TRAPS**



NO SCALE

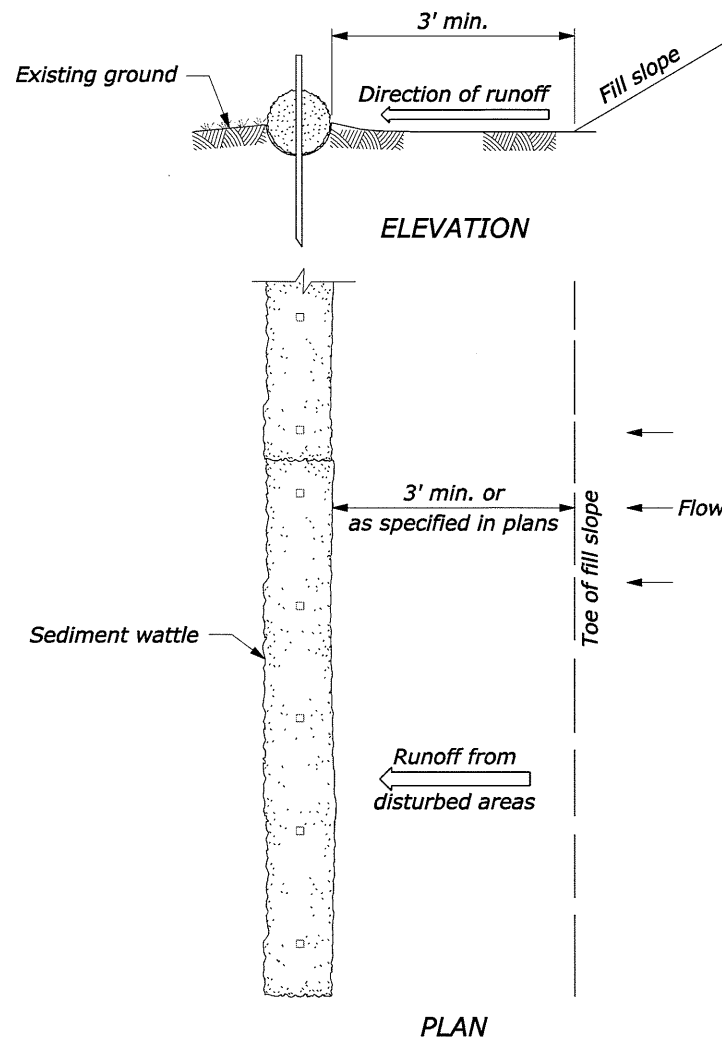

**INSTALLATION BEYOND TOE OF SLOPE**

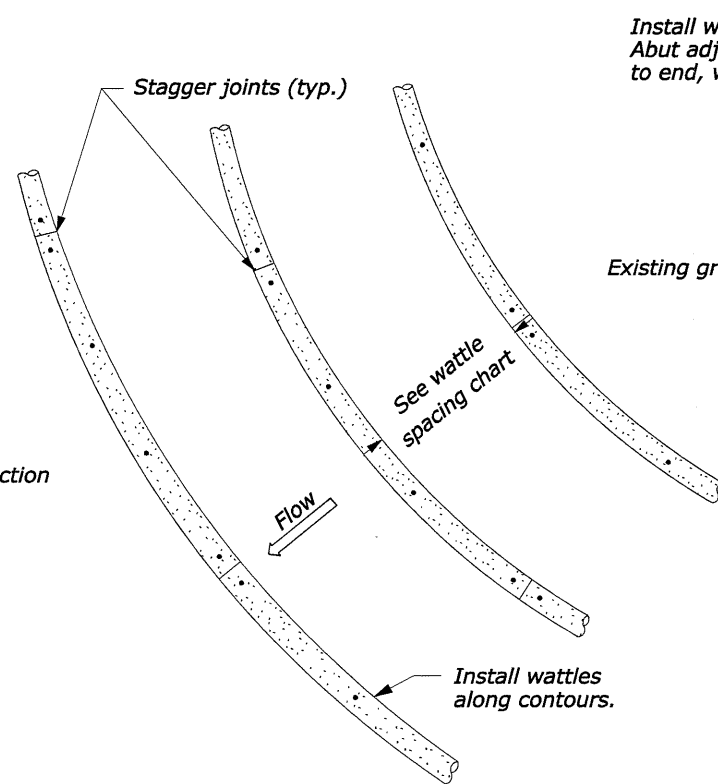

**INSTALLATION ALONG SLOPES**

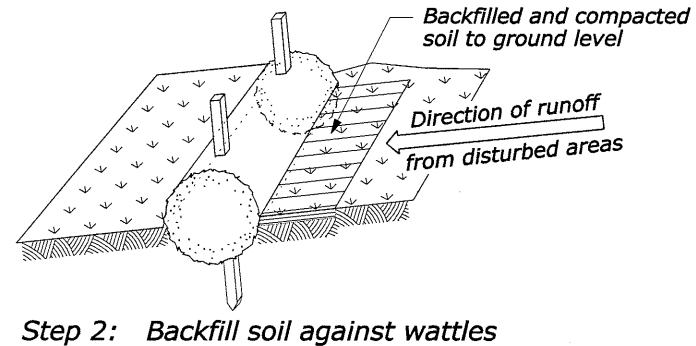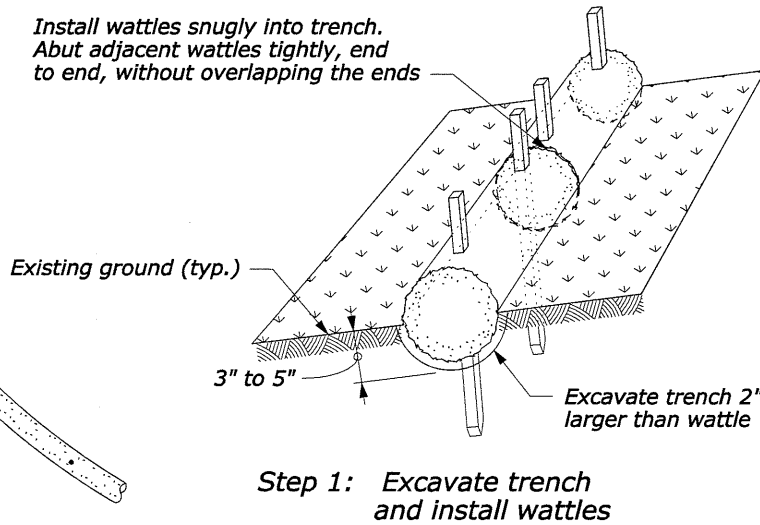




**PROPERLY STAKED AND ENTRENCHED WATTLE**

**NOTE:**

1. Drive stakes at each end and at 4' spacing until wattle is secure to slope. Do not crush wattle while staking. Live stakes may be used for permanent installations.
2. Use drainage ditch installation only in low flow conditions.

STAKES REQUIRED	
Wattle length (ft)	Stakes required for each wattle
25	8
20	6
12	4

WATTLE SPACING	
Slope	Spacing (ft)
1:4 or flatter	40
1:3	30
1:2	20
1:1	10

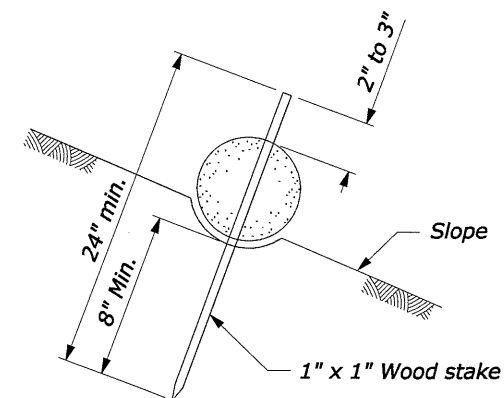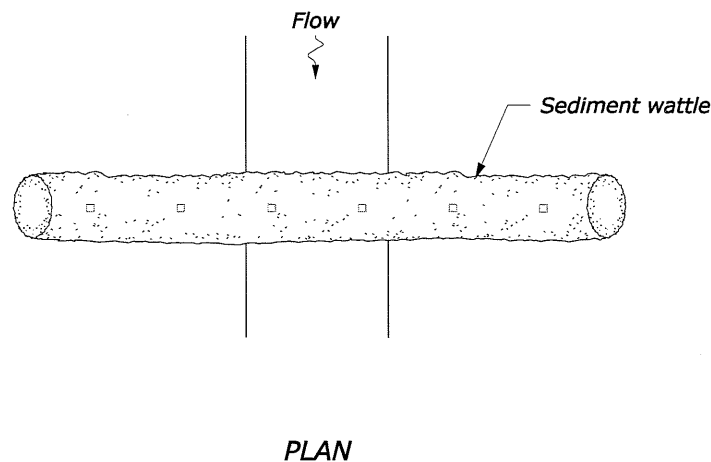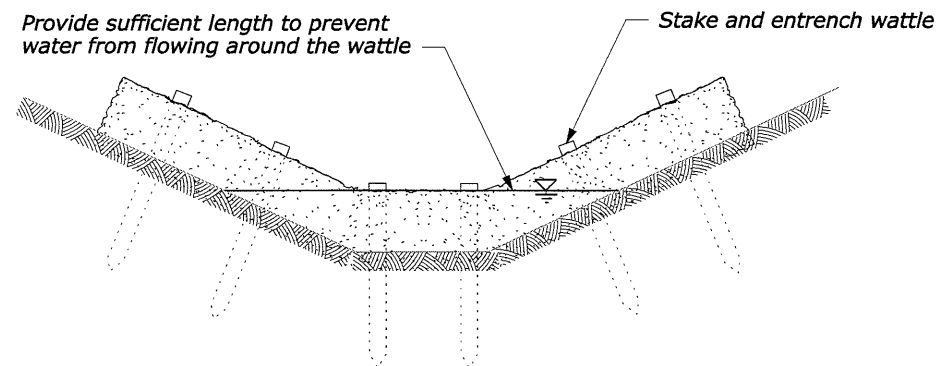

**WATTLE STAKING DETAIL**

**DRAINAGE DITCH INSTALLATION**

NO SCALE

U.S. DEPARTMENT OF TRANSPORTATION FEDERAL HIGHWAY ADMINISTRATION WESTERN FEDERAL LANDS HIGHWAY DIVISION	
U.S. CUSTOMARY DETAIL	
<b>SEDIMENT WATTLE</b>	
DETAIL APPROVED FOR USE 9/2007	DETAIL
REVISED:	W157-20



Note: The quantities shown hereon are approximate and are subject to field adjustments.

## TABULATION OF DRAINAGE QUANTITIES

STATE	PROJECT	SHEET NUMBER
AK	DEN 2009(8)	G.1

PAY ITEM NUMBER				25101		60201				60210			60501	60510	Allow. Pipe Material  (See key below)	BEVELS 1V:nH		FOOTNOTES  See below for numbered footnote	
				-3000		-0600	-0800	-1000	-2500	-0600	-0800	-1000	-0000			-1000			
STATION	EST MAX COVER (ft)	STR EXC (CUYD)		Placed Riprap, Class 3 (CUYD)		Pipe Culvert, Government-Furnished (LNFT)				End Section, Government-Furnished (EACH)			Standard underdrain system (LNFT)	8-Inch Outlet Pipe (LNFT)			Lt		Rt
DIAMETER or SPAN x RISE (inch)				Riprap Headwall	Energy Dissipator	18	24	36	144	18	24	36							
4+49    2.59    18							46				2				X/C,P			6, 7	
7+25 to 9+25													200	105				10	
13+13    4.18    28					2		54				2				X/C,P			2, 6, 7	
23+75    3.13    22							48				2				X/C,P			6, 7	
31+50    4.07    34							50				2				X/C,P			6, 7	
42+00    2.82    23							44				2				X/C,P			5, 6, 7	
46+40    2.61    22							42				2				X/C,P			6, 7	
51+74    7.52    30					2		72				2				X/C,P			2, 5, 6, 7	
57+00    2.91    31							44				2				X/C,P			5, 6, 7	
65+00    3.39    27							46				2				X/C,P			6, 7	
70+35 LT    2.00    10						22				2					X/C,P			1, 6, 7	
76+08    2.91    320				14					56						X/C,P	1.5	1.5	3, 4, 5, 8, 9	
80+60 LT    2.24    16						44				2					X/C,P			1, 6, 7	
84+50    2.81    17							42				2				X/C,P			6, 7	
89+50    3.43    21							46				2				X/C,P			6, 7	
92+59    4.22    26							52				2				X/C,P			6, 7	
96+07    2.65    21							42				2				X/C,P			6, 7	
99+32    4.11    30				4			50				2				X/C,P			3, 6, 7	
104+59    4.86    53				7				60				2			X/C,P			3, 6, 7	
108+16    3.05    21				3			46				2				X/C,P			3, 6, 7	
110+01    4.75    33							56				2				X/C,P			6, 7	
114+29    6.38    48				4			68				2				X/C,P			3, 6, 7	
118+50    3.72    27							48				2				X/C,P			6, 7	
119+10 LT    2.80    11						42				2					X/C,P			1, 6, 7	
122+50    4.79    13					2		54				2				X/C,P			2, 6, 7	
126+13    2.70    20							44				2				X/C,P			6, 7	
136+78    2.93    19				2			44				2				X/C,P			3, 6, 7	
141+07    2.91    14							44				2				X/C,P			6, 7	
144+14    3.02    21				3			44				2				X/C,P			3, 6, 7	
148+04    4.28    13				3	2		52				2				X/C,P			2, 3, 6, 7	
153+78    5.26    34				3	2		60				2				X/C,P			2, 3, 6, 7	
156+26    4.07    42					2		52				2				X/C,P			2, 6, 7	
161+24    2.91    21				3			44				2				X/C,P			3, 6, 7	
163+58    3.71    24				3			48				2				X/C,P			3, 6, 7	
165+68    2.62    42				6				46				2			X/C,P			3, 6, 7	
170+50    4.54    31					2		54				2				X/C,P			2, 6, 7	
176+29    3.45    24							46				2				X/C,P			6, 7	
CUMULATIVE TOTAL			1,207		55	14	108	1,482	106	56	6	60	4	200	105				

Schedule B

Schedule A

Schedule B &  
Schedule C

NOTE:

1. Steel pipe culvert minimum wall thickness as required by the Std. 602-1 fill height table.
2. Aluminized steel pipe culvert minimum wall thickness as required by the Std. 602-1 fill height table (steel).
3. Aluminum pipe culvert minimum wall thickness as required by the Std. 602-1 fill height table.
4. In cut sections, construct cut slope inlets as shown on Std. 602-6.

FOOTNOTES:

1. Approach road culvert.
2. Energy dissipator at outlet.
3. Riprap headwall at inlet.
4. Riprap headwall at outlet.
5. Inlet / Outlet ditch included in structural excavation.
6. Install end section at inlet.
7. Install end section at outlet.

8. Aquatic Organism Passage (AOP) culvert. Do not modify culvert installation unless approved by the CO. See Sheet G.3 for details.
9. Step bevel.
10. See Sheet G.7 for details.

Allowable pipe culvert material

- |         |                                     |
|---------|-------------------------------------|
| A       | Aluminum                            |
| AS      | Aluminized steel                    |
| C       | Concrete                            |
| GS      | Galvanized steel                    |
| P       | Plastic                             |
| (blank) | Any appropriate material            |
| X/___   | Any appropriate material except ___ |

## TABULATION OF DRAINAGE QUANTITIES

STATE	PROJECT	SHEET NUMBER
AK	DEN 2009(8)	G.2

PAY ITEM NUMBER				25101		60201				60210			60501	60510		Allow. Pipe Material  (See key below)	BEVELS 1V:nH		FOOTNOTES  See below for numbered footnotes
				-3000		-0600	-0800	-1000	-2500	-0600	-0800	-1000	-0000		-1000				
STATION	EST MAX COVER (ft)	STR EXC (CUYD)		Placed Riprap, Class 3 (CUYD)		Pipe Culvert, Government-Furnished (LNFT)				End Section, Government-Furnished (EACH)			Standard underdrain system (LNFT)	8-Inch Outlet Pipe (LNFT)					
				Riprap Headwall	Energy Dissipator	18	24	36	144	18	24	36				Lt	Rt		
DIAMETER or SPAN x RISE (inch)				Riprap Headwall	Energy Dissipator	18	24	36	144	18	24	36							
PREVIOUS SHEET			1,207		55	14	108	1,482	106	56	6	60	4	200	105				
188+45	3.58	21						48				2				X/C,P		6, 7	
192+84	3.42	23						46				2				X/C,P		6, 7	
194+80	3.91	22						48				2				X/C,P		6, 7	
205+50	2.54	19						40				2				X/C,P		6, 7	
208+07	3.65	18						48				2				X/C,P		6, 7	
212+62	4.96	22		4				56				2				X/C,P		3, 6, 7	
215+71	5.61	24						60				2				X/C,P		6, 7	
218+79	4.50	38		5					52				2			X/C,P		3, 6, 7	
221+90 LT	2.27	41				84				2						X/C,P		1, 6, 7	
224+34	2.87	21						44				2				X/C,P		6, 7	
225+06 LT	2.00	25				52				2						X/C,P		1, 6, 7	
226+66 LT	2.00	11				22				2						X/C,P		1, 6, 7	
227+66 LT	2.00	13				20				2						X/C,P		1, 6, 7	
228+43 LT	2.00	17				26				2						X/C,P		1, 6, 7	
															</				

Schedule B &  
Schedule C

## Schedule A

1. Steel pipe culvert minimum wall thickness as required by the Std. 602-1 fill height table.
2. Aluminized steel pipe culvert minimum wall thickness as required by the Std. 602-1 fill height table (steel).
3. Aluminum pipe culvert minimum wall thickness as required by the Std. 602-1 fill height table.
4. In cut sections, construct cut slope inlets as shown on Std. 602-6.

1. Approach road culvert.
2. Energy dissipator at outlet.
3. Riprap headwall at inlet.
4. Riprap headwall at outlet.
5. Inlet / Outlet ditch included in structural excavation.
6. Install end section at inlet.
7. Install end section at outlet.



8. Aquatic Organism Passage (AOP) culvert. Do not modify culvert installation unless approved by the CO. See Sheet G.3 for details.
9. Step bevel.
10. See Sheet G.7 for details.

A	Aluminum
AS	Aluminized steel
C	Concrete
GS	Galvanized steel
P	Plastic
(blank)	Any appropriate material
X/___	Any appropriate material except ___



7/2012 B. Wacker 7/2012 Checked by: N. Bell 16-Jul-2012 10:12 AM Designed by: ...Design\Drainage\dd0908ea.dgn

STATE	PROJECT	SHEET NUMBER
AK	DEN 2009(8)	G.3

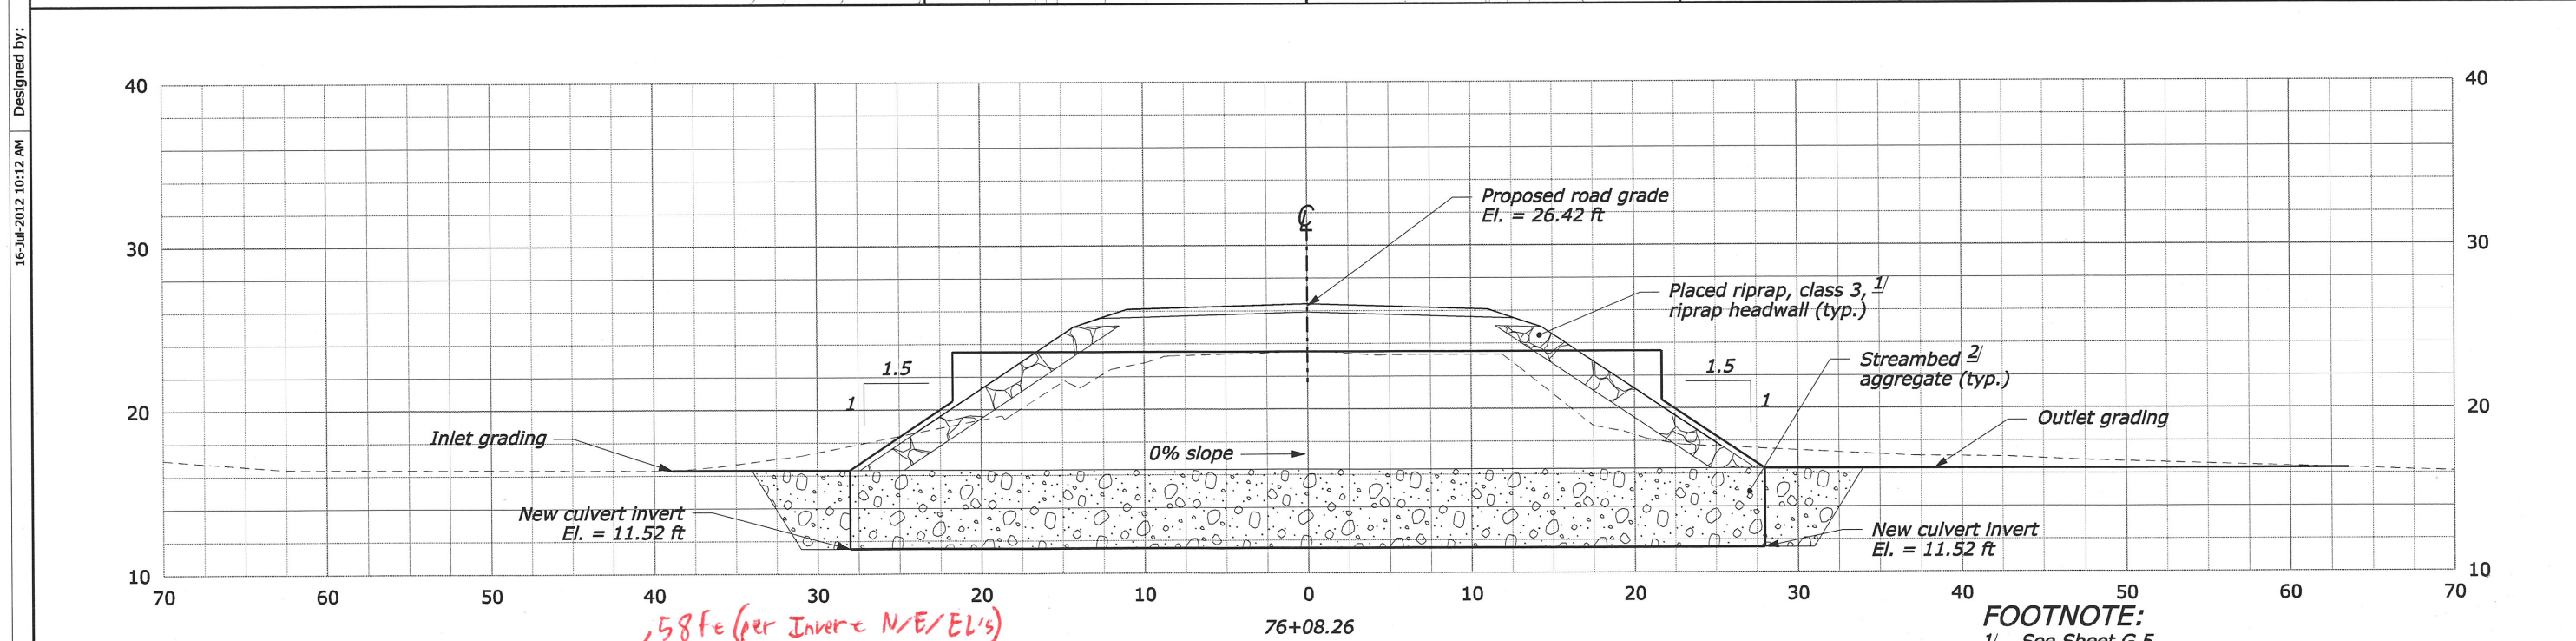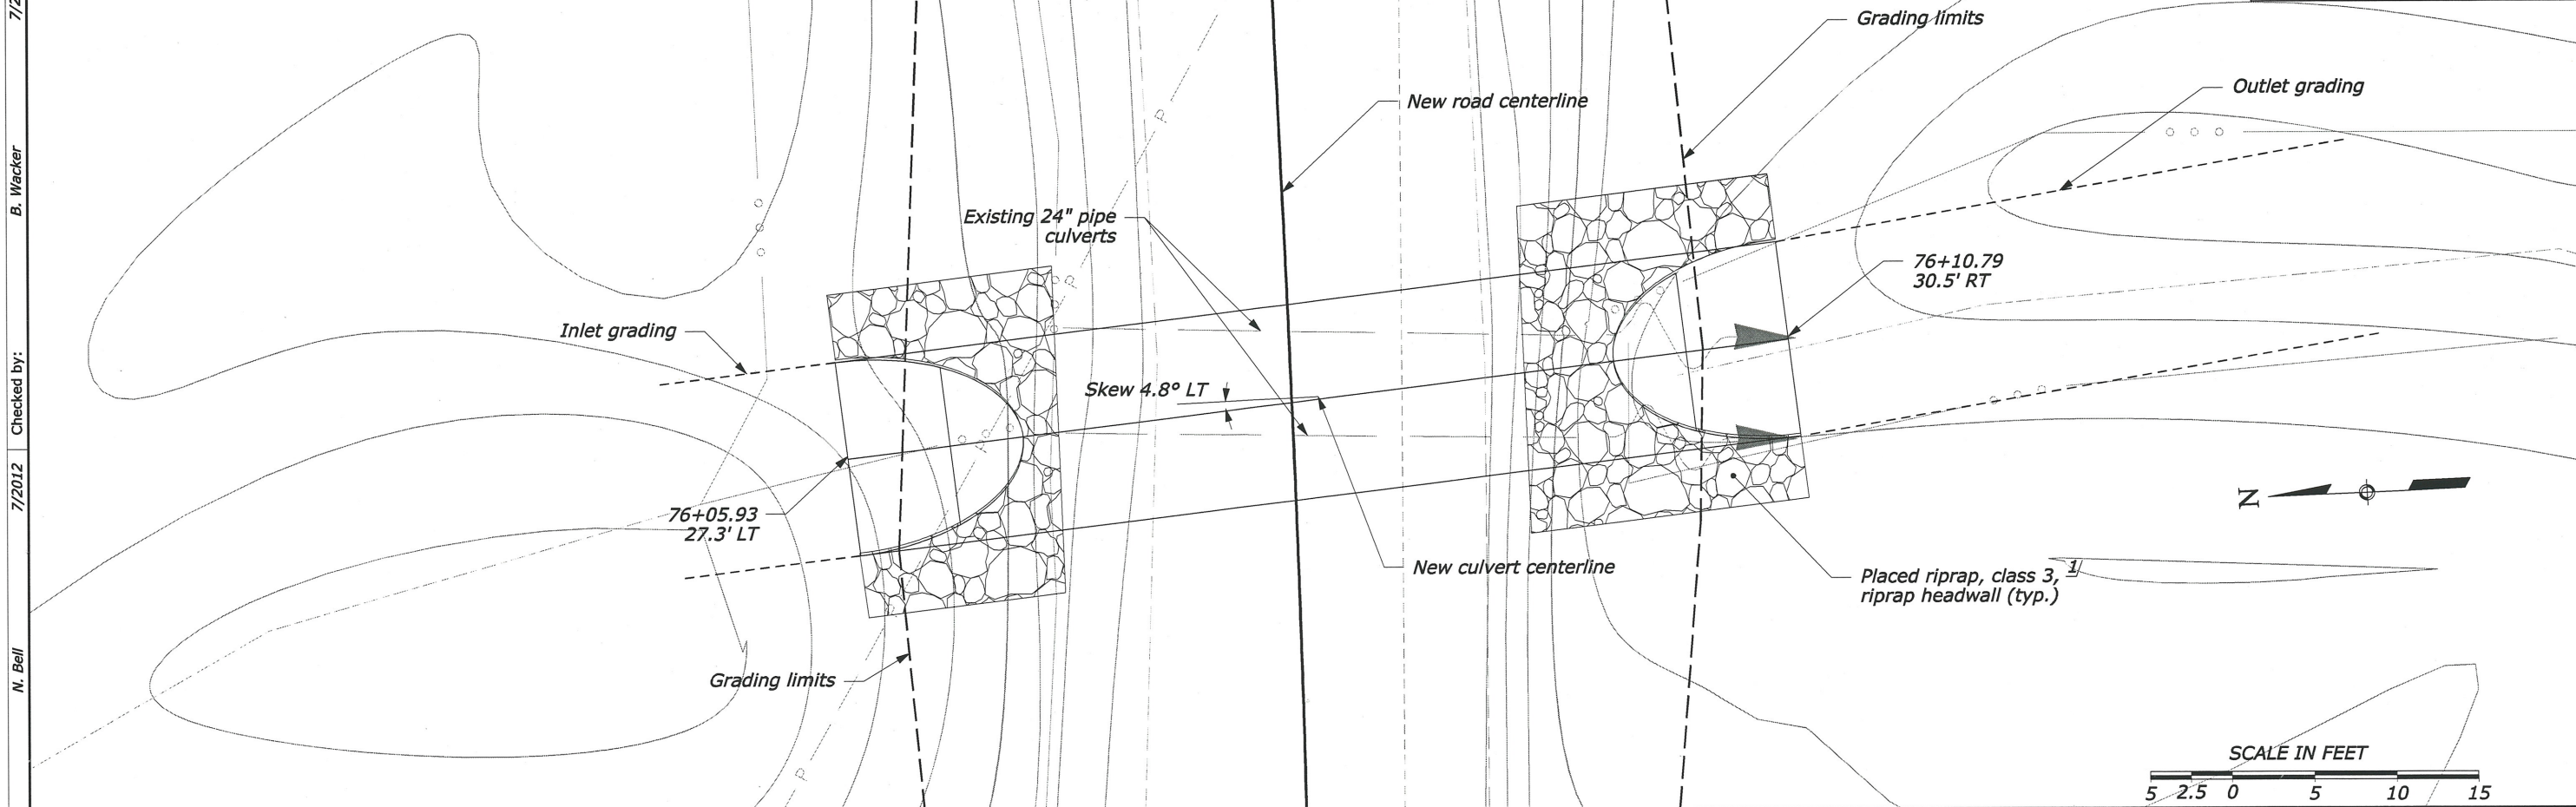


HYDRAULIC INFORMATION	PIPE	INLET	OUTLET
Q <sub>2</sub> : 21 CFS HW <sub>25</sub> : _____	TYPE: CMP ROUND	INV N/E/EL: 1817641.65/1447310.21/11.52	INV N/E/EL: 1817583.84/1447314.78/11.52
Q <sub>50</sub> : 81 CFS	LENGTH: 56 FT	BURIAL DEPTH: 57.6 in	BURIAL DEPTH: 57.6 in
ACTIVE CHANNEL WIDTH: 15 FT	WALL THICKNESS: 0.168 in	UPPER/LOWER BEVEL HEIGHT: 36.0 in/57.6 in	UPPER/LOWER BEVEL HEIGHT: 36.0 in/57.6 in
	PIPE SLOPE: 0 FT/FT	BEVEL: STEP, 1.5(H):1(V)	BEVEL: STEP, 1.5(H):1(V)
	FLOWLINE SLOPE: 0 FT/FT	HEADWALL: RIPRAP	HEADWALL: RIPRAP

**76+08 BEAVER CREEK CULVERT DETAIL**


FOOTNOTE:  
1/ See Sheet G.5.  
2/ See Sheet G.6.

7/2012  
B. Wacker  
Checked by:  
7/2012  
N. Bell  
Designed by:  
20-Jul-2012 02:48 PM  
...\\Design\\Drainage\\d0908eb.dgn


STATE	PROJECT	SHEET NUMBER
AK	DEN 2009(8)	G.4

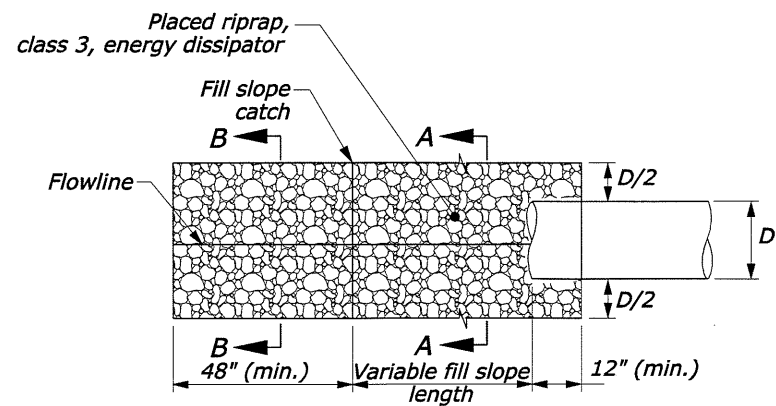

**ENERGY DISSIPATOR - PLAN**

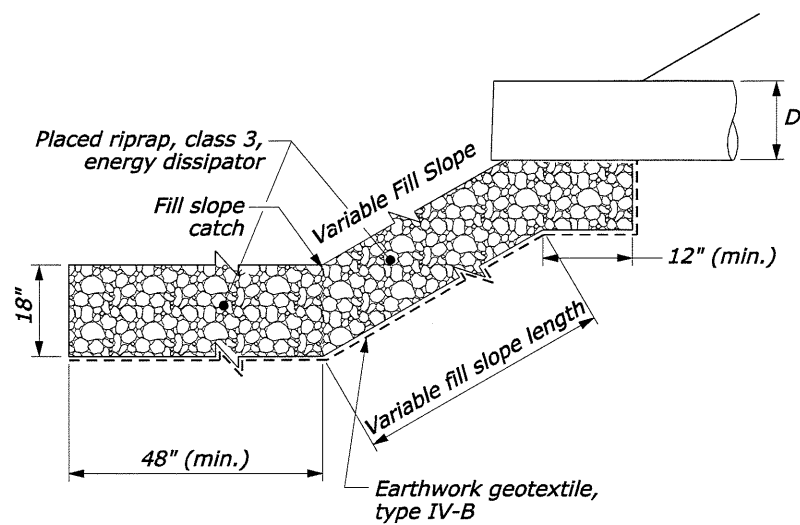

**ENERGY DISSIPATOR - ELEVATION**

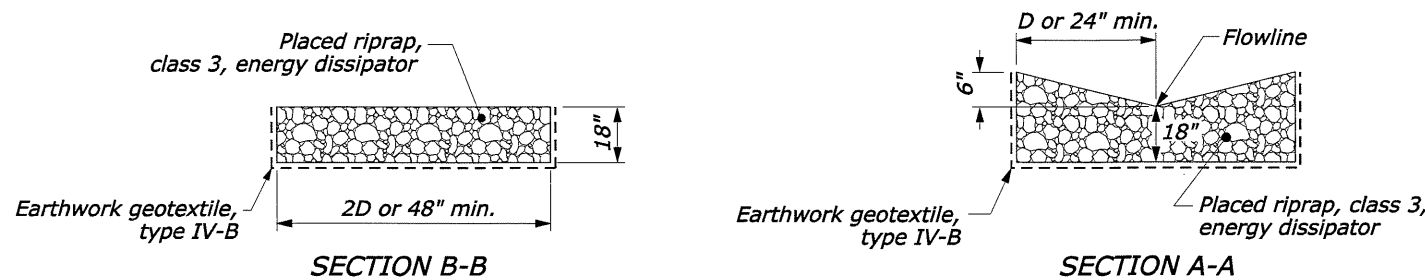


**NOTE:**

1. Place riprap in energy dissipators at the following rates:

Outlet Diameter	Section	Placed Riprap, Class 3	Earthwork Geotextile, Type IV-B
24"	A-A	0.26 cuyd/ft	0.89 sqyd/ft
24"	B-B	0.22 cuyd/ft	0.78 sqyd/ft
36"	A-A	0.39 cuyd/ft	1.11 sqyd/ft
36"	B-B	0.33 cuyd/ft	1.00 sqyd/ft

2. See Sheets G.1-G.2 for location and quantity.

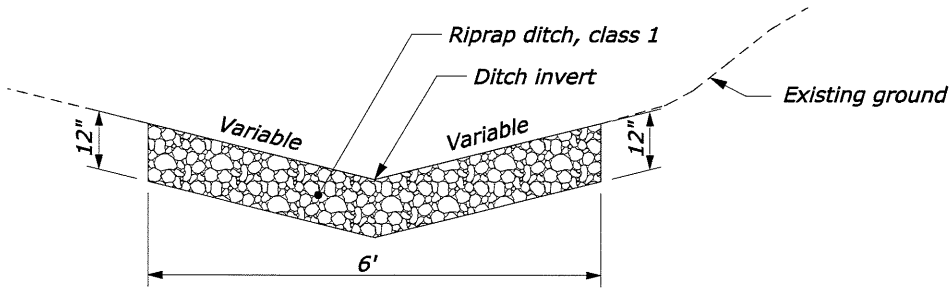

**RIPRAP DITCH, CLASS 1**

**NOTE:**

1. Place riprap in ditches at the following rates:

Location	Riprap ditch, class 1
Mainline	0.22 cuyd/ft
Approaches	0.22 cuyd/ft

2. See Sheets D.1 and E.1 for location and quantities.  
3. Grade ditch to define well established flowline.

NO SCALE

**ENERGY DISSIPATOR  
AND RIPRAP  
DITCH DETAILS**








7/2012  
B. Wacker  
7/2012  
N. Bell  
15-Jul-2012 02:05 PM  
Designed by:  
...Design\Drainage\dc0908ed.dgn

STATE	PROJECT	SHEET NUMBER
AK	DEN 2009(8)	G.6

INFILL INFORMATIONAL QUANTITIES

LOCATION	D (ft)	W (ft)	STREAMBED COBBLE GRADATION (in)	STREAMBED COBBLE (cuyd)	STREAMBED SEDIMENT (cuyd)	HABITAT STONE DIAMETER (in +/- 4)	HABITAT STONE (each)
76+08	12	9	6	45	75	18	14

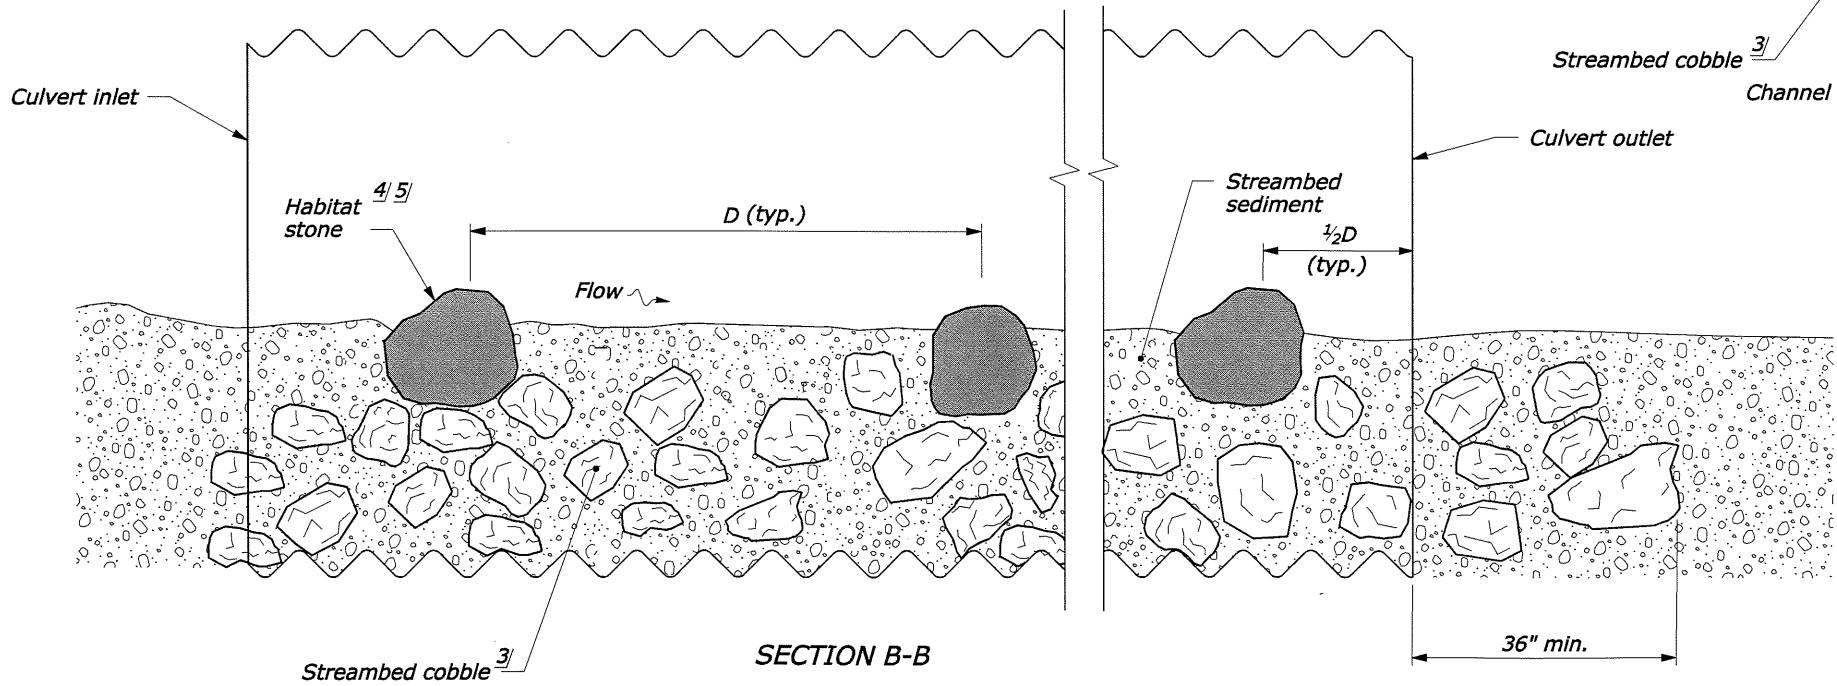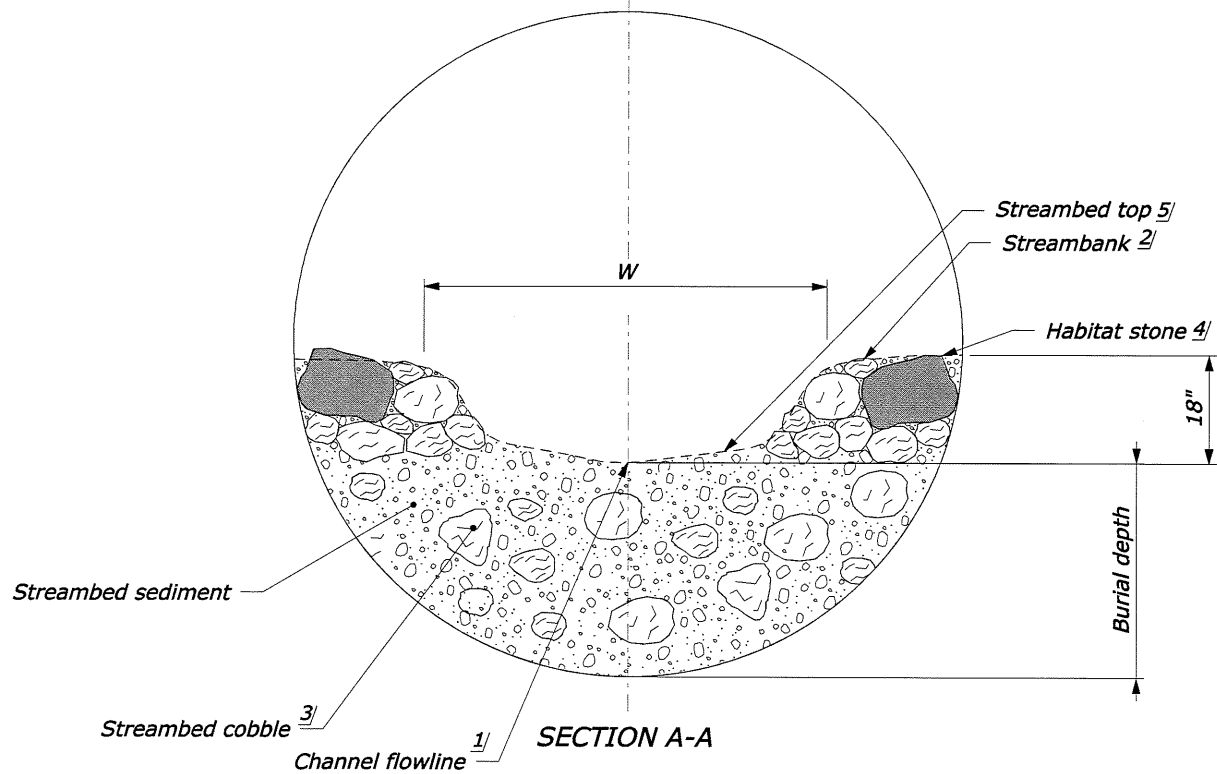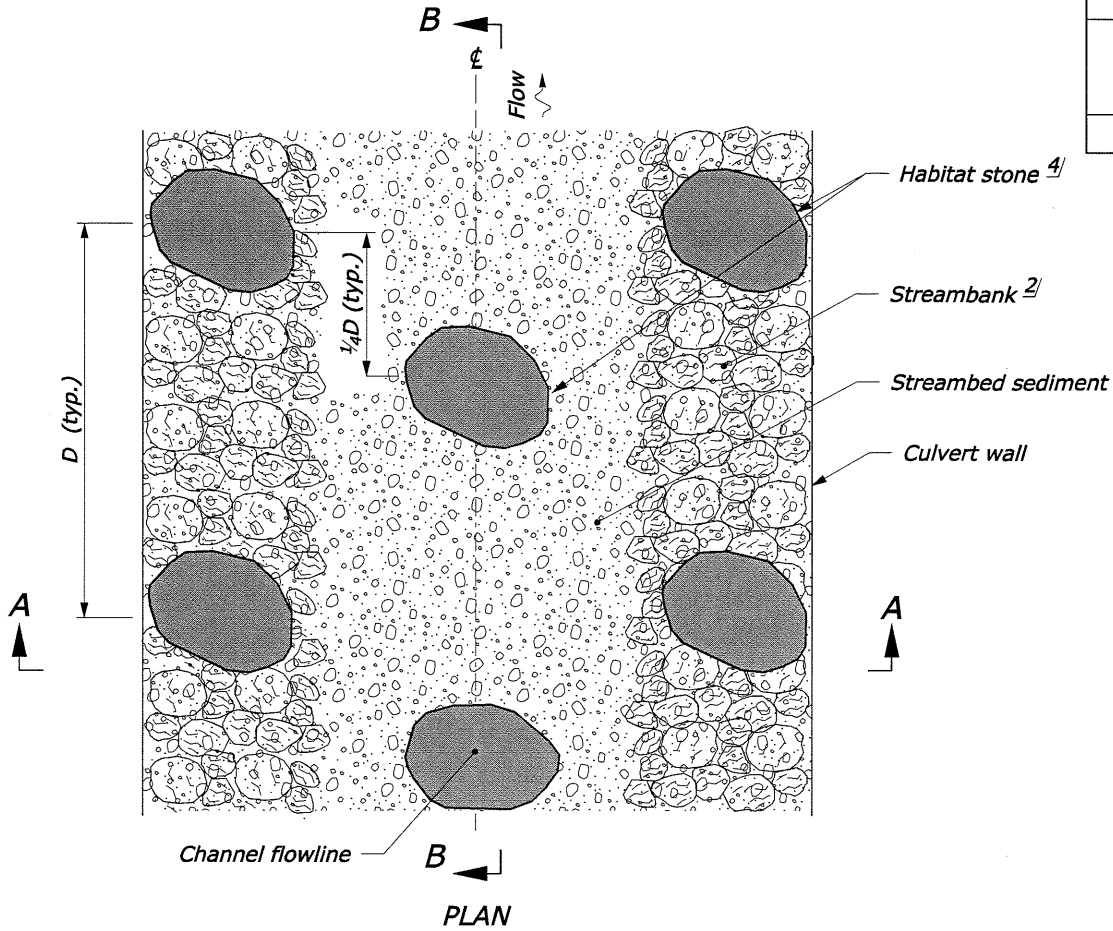

NOTE:

1. See Section 602.

FOOTNOTE:

- 1/ Slope streambed aggregate towards flowline to ensure parabolic shape.
- 2/ Construct well defined banks with streambed cobble and streambed sediment.
- 3/ Mix streambed cobbles evenly throughout streambed sediment.
- 4/ Stagger in-channel habitat stones within the culvert span.
- 5/ Embed habitat stones within active channel by  $\frac{3}{4}$  of the smallest dimension.

SIMULATED STREAM  
CULVERT INTERIOR  
TREATMENT

NO SCALE



7/2012 7/2012 7/2012 23-Jul-2012 01:57 PM ...\\Design\\Drainage\\dc0908ej.dgn


B. Wacker

Checked by:

N. Bell

Designed by:

STATE	PROJECT	SHEET NUMBER
AK	DEN 2009(8)	G.7

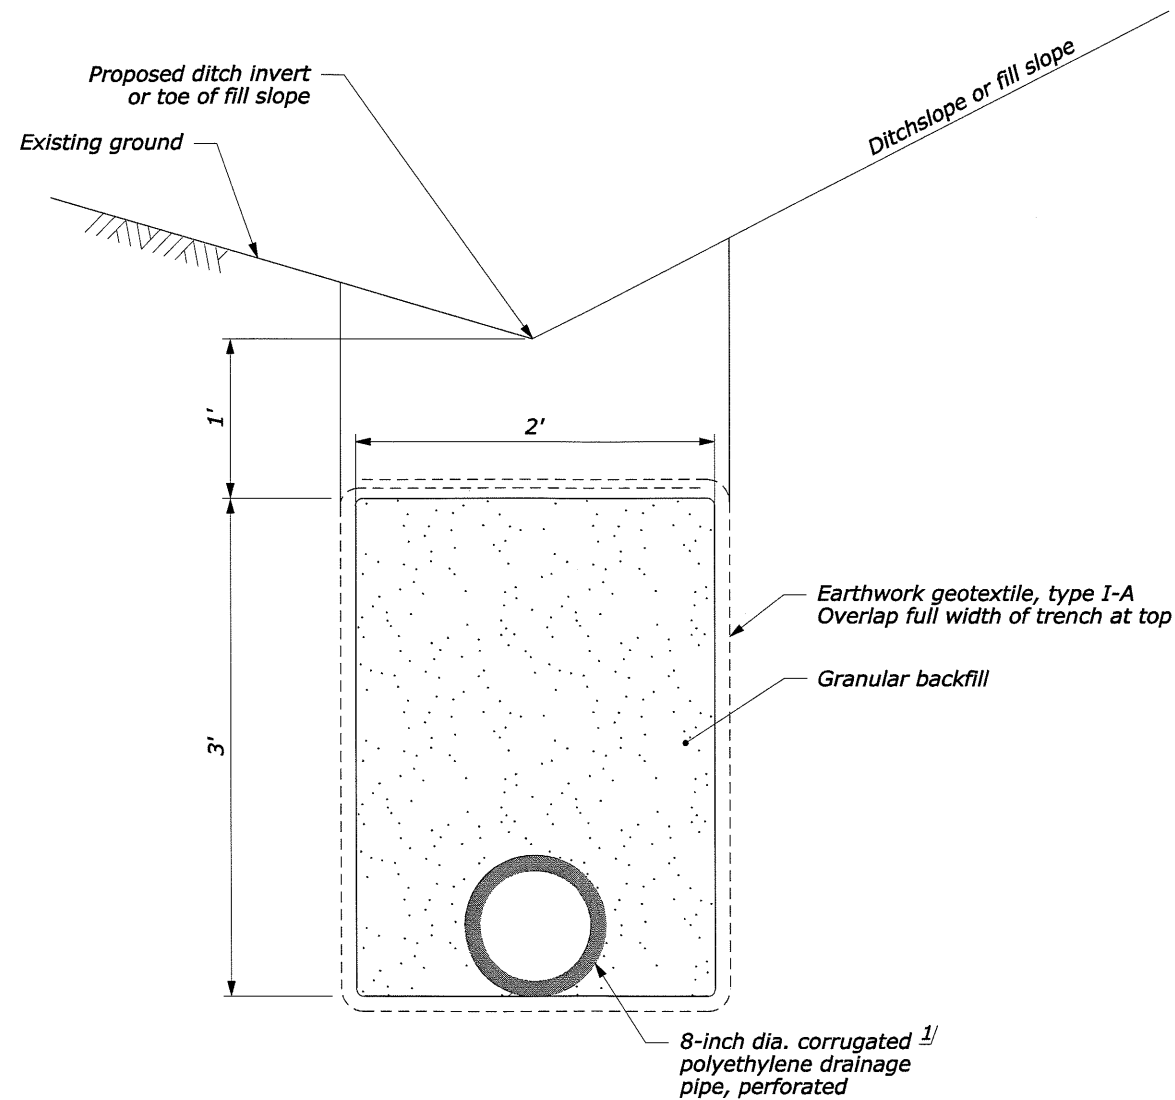

### STANDARD UNDERDRAIN SYSTEM DETAIL

#### NOTE:

1. See Sheets G.1-G.2 for locations and quantities.
2. Place materials in the underdrain at the following rates:

<u>Granular Backfill</u>	<u>Earthwork Geotextile, Type I-A</u>
0.22 CUYD/FT	1.33 SQYD/FT

#### FOOTNOTE:

- <sup>1/</sup> Daylight drainage pipe across road with 8" non-perforated outlet pipe at locations approved by CO.

See page D.2 for location

NO SCALE

### STANDARD UNDERDRAIN SYSTEM DETAIL

METAL ROUND PIPE CULVERT

FILL HEIGHT AND METAL THICKNESS TABLE FOR HELICAL LOCKSEAM AND WELDED SEAM PIPE CULVERT

STEEL																	
PIPE SIZE DIAMETER INCHES	MINIMUM COVER INCHES	2 <sup>2</sup> / <sub>3</sub> " x 1 <sup>1</sup> / <sub>2</sub> " CORRUGATIONS					3" x 1" CORRUGATIONS					5" x 1" CORRUGATIONS					
		METAL THICKNESS (INCH/GAGE)															
		0.064/16	0.079/14	0.109/12	0.138/10	0.168/8	0.064/16	0.079/14	0.109/12	0.138/10	0.168/8	0.064/16	0.079/14	0.109/12	0.138/10	0.168/8	
		MAXIMUM FILL HEIGHT ABOVE TOP OF PIPE (FEET)															
12	12	100	100	100	100	100											
15	12	100	100	100	100	100											
18	12	100	100	100	100	100											
21	12	100	100	100	100	100											
24	12	100	100	100	100	100											
30	12	85	100	100	100	100											
36	12	71	89	100	100	100	81	100	100	100	100						
42	12	61	76	100	100	100	70	87	100	100	100						
48	12	53	66	93	100	100	61	76	100	100	100	54	68	95	100	100	
54	12		59	83	100	100	54	68	95	100	100	48	60	85	100	100	
60	12			74	97	100	49	61	86	100	100	43	54	76	98	100	
66	12				87	100	44	55	78	100	100	39	49	69	89	100	
72	12				80	97	40	51	71	92	100	36	45	63	82	100	
78	12					87	37	47	66	85	100	33	42	58	75	92	
84	12					75	35	43	61	78	96	31	39	54	70	86	
90	12						32	40	57	73	90	29	36	51	65	80	
96	12							38	53	69	84		34	48	61	75	
102	18							36	50	65	79		32	45	57	71	
108	18								47	61	75			42	54	67	
114	18								45	58	71			40	52	63	
120	18								43	55	67			38	49	60	
126	18									52	64				47	57	
132	18									50	61				44	54	
138	18									48	58				42	52	
144	18										56					50	

ALUMINUM															
PIPE SIZE DIAMETER INCHES	MINIMUM COVER  INCHES	2 <sup>2</sup> / <sub>3</sub> " x 1 <sup>1</sup> / <sub>2</sub> " CORRUGATIONS					3" x 1" CORRUGATIONS								
		METAL THICKNESS (INCH/GAGE)													
		0.060/16	0.075/14	0.105/12	0.135/10	0.164/8	0.060/16	0.075/14	0.105/12	0.135/10	0.164/8				
		MAXIMUM FILL HEIGHT ABOVE TOP OF PIPE (FEET)													
12	12	100	100	100	100	100									
15	12	100	100	100	100	100									
18	12	100	100	100	100	100									
21	12	88	100	100	100	100									
24	12	77	97	100	100	100									
30	12	62	77	100	100	100	71	89	100	100	100				
36	12	52	64	90	100	100	59	74	100	100	100				
42	12	44	55	77	99	100	51	64	89	100	100				
48	12			67	87	100	44	56	78	100	100				
54	18			54	71	88	39	50	69	93	100				
60	18				57	72	35	45	62	83	98				
66	18					58	32	40	56	76	89				
72	18					45	30	37	55	70	82				
78	24							34	48	64	75				
84	24								44	59	70				
90	24								41	62	65				
96	24								38	51	61				
102	24									46	55				
108	24									42	50				
114	24											45			
120	24												40		

NOTE:

- When directed, camber pipe culverts upward from a chord through the inlet and outlet inverts an ordinate amount equal to 1% of the pipe length. Develop camber on a parabolic curve. If the midpoint elevation on the parabolic curve as designed exceeds the elevation of the inlet invert, reduce the amount of camber or increase the pipe culvert gradient.
- Fill heights exceeding 100 feet require special analysis by the CO.
- The fill heights in the table are for helical lockseam and welded seam pipe only. Fill heights for culvert pipe with annular corrugations are more restrictive than those of helical lockseam and welded seam pipe. Obtain approval before furnishing annular corrugation pipe.
- Measure minimum cover from the top of the pipe culvert to the subgrade for flexible pavements, and to the top of the pavement for rigid pavements. Measure maximum fill height from the top of the pipe to the top of the pavement for both flexible and rigid pavement.

METAL PIPE ARCH CULVERT

FILL HEIGHT AND METAL THICKNESS TABLE FOR HELICAL LOCKSEAM AND WELDED SEAM PIPE CULVERT

STEEL																	
PIPE ARCH SIZE SPAN x RISE INCHES	EQUI- VALENT DIAMETER INCHES	MINIMUM CORNER RADIUS INCHES	MINIMUM COVER INCHES	2 <sup>2</sup> / <sub>3</sub> " x 1 <sup>1</sup> / <sub>2</sub> " CORRUGATIONS					3" x 1" CORRUGATIONS					5" x 1" CORRUGATIONS			
				METAL THICKNESS (INCH/GAGE)													
				0.064/16 0.079/14 0.109/12 0.138/10 0.168/8 0.079/14 0.109/12 0.138/10 0.168/8 0.079/14 0.109/12 0.138/10 0.168/8													
				MAXIMUM FILL HEIGHT ABOVE TOP OF PIPE (FEET)													
17 x 13	15	3	12	13													
21 x 15	18	3	12	12													
24 x 18	21	3	12	13													
28 x 20	24	3	12	13													
35 x 24	30	3	12	12													
42 x 29	36	3.5	12	12													
49 x 33	42	4	12		12												
57 x 38	48	5	12			12											
60 x 46	54	8	15						21				21				
64 x 43	54	6	12			12											
66 x 51	60	9	15						21				21				
71 x 47	60	7	12				12										
73 x 55	66	12	18						20				20				
77 x 52	66	8	12					12									
81 x 59	72	14	18						17				17				
83 x 57	72	9	12				12										
87 x 63	78	14	18						17				17				
95 x 67	84	16	18						17				17				
103 x 71	90	16	18							17			17				
112 x 75	96	18	21							16				16			
117 x 79	102	18	21							16				16			
128 x 83	108	18	24								16				16		
137 x 87	114	18	24								16				16		
142 x 91	120	18	24									16				16	

ALUMINUM													
PIPE ARCH SIZE SPAN x RISE INCHES	EQUI- VALENT DIAMETER INCHES	MINIMUM CORNER RADIUS INCHES	MINIMUM COVER INCHES	2½" x ½" CORRUGATIONS				3" x 1" CORRUGATIONS					
				METAL THICKNESS (INCH/GAGE)									
				0.060/16 0.075/14 0.105/12 0.135/10 0.060/16 0.075/14 0.105/12 0.135/10									
				MAXIMUM FILL HEIGHT ABOVE TOP OF PIPE (FEET)									
17 x 13	15	3	12	13									
21 x 15	18	3	12	12									
24 x 18	21	3	12	13									
28 x 20	24	3	12		13								
35 x 24	30	3	12		12								
42 x 29	36	3.5	15			12							
49 x 33	42	4	15			12							
57 x 38	48	5	15				12						
60 x 46	54	8	15					21					
64 x 43	54	6	18				12						
66 x 51	60	9	18					21					
73 x 55	66	12	18						20				
81 x 59	72	14	21								17		
87 x 63	78	14	21								17		
95 x 67	84	16	24								17		
103 x 71	90	16	24										17



COUPLING BANDS FOR METAL PIPE CULVERT <sup>1/</sup>					
CORRUGATION SIZE <sup>2/</sup> INCHES	ROUND PIPE DIAMETER INCHES	PIPE ARCH SPAN x RISE INCHES	MINIMUM BAND WIDTH (INCHES)		
			ANNULAR CORRUGATED BANDS <sup>3/</sup>	HELICALLY CORRUGATED BANDS <sup>4/</sup>	SEMI- CORRUGATED BANDS <sup>5/</sup>
1 1/2 x 1/4	underdrain <sup>6/</sup>	-	10.5	7	10.5
2 2/3 x 1/2	12 to 36	17 x 13 to 42 x 29	7	12	
	42 to 72	49 x 33 to 83 x 57	10.5	12	
3 x 1	78 to 84	-	10.5	12	10.5
	36 to 72	60 x 46 to 81 x 59	12	14	10.5
5 x 1	78 to 144	87 x 64 to 142 x 91	12	14	10.5
	36 to 72	60 x 46 to 81 x 59	20	22	
	78 to 144	87 x 64 to 142 x 91	20	22	

<sup>1/</sup> Fabricate annular, helical and semi-corrugated type coupling bands from the same metal as the connecting pipe. Provide coupling bands not more than 3 nominal sheet thicknesses thinner than the thickness of the pipe to be connected, and no thinner than 0.052 inch for steel or 0.048 inch for aluminum. Fasten coupling bands with the following diameter of bolt:  
3/8" for 18" round culvert (21" x 15" pipe arch) or less  
1/2" for 21" round culvert (24" x 18" pipe arch) or more


<sup>2/</sup> For helically corrugated pipe with rerolled ends, the nominal corrugations size refers to the dimension of the end corrugation in the pipe.

<sup>3/</sup> Use annular corrugated bands with pipes having annular corrugations or with helical pipe having rerolled end to form annular corrugations. A 10.5 inch band is acceptable on pipe ends rerolled with 2 2/3" x 1/2" corrugations. A 12 inch band is acceptable on pipe ends rerolled with 3" x 1" pipe corrugations.

<sup>4/</sup> Use helical corrugated bands with pipes having helically corrugated ends.

<sup>5/</sup> The minimum band widths shown for 3" x 1" and 5" x 1" corrugated sizes apply to 2 2/3" x 1/2" corrugations on rerolled pipe ends.


<sup>6/</sup> Smooth sleeve-type couplers and flat bands may be used for pipe diameters of 12" or less. Use a matching metal having a nominal thickness of not less than 0.040 inch for steel, or 0.036 inch for aluminum, or a plastic with an equivalent strength to metal.

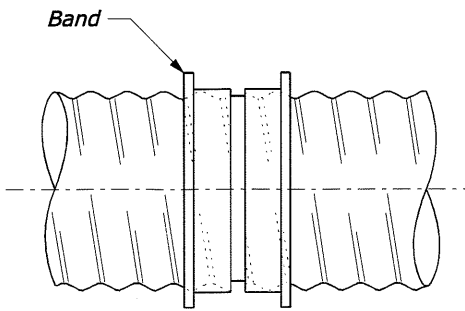

SLEEVE JOINT

Smoothen sleeve with center stop.  
Stab type joint


SMOOTH SLEEVE BAND

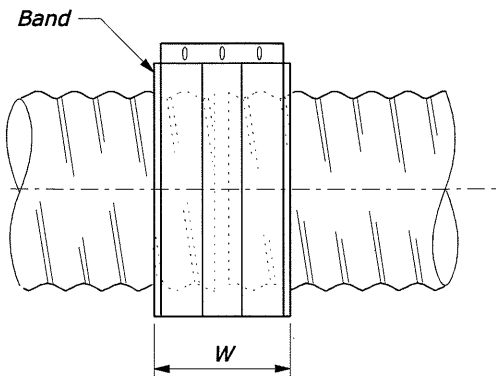


FLAT BAND

NOTE:


- Watertight pipe joints are not required unless specified in the Special Contract Requirements.
- Other types of coupling bands or fastening devices that comply with the joint performance criteria of AASHTO Standard specifications for Highway Bridges, Division II Section 26 may be used.

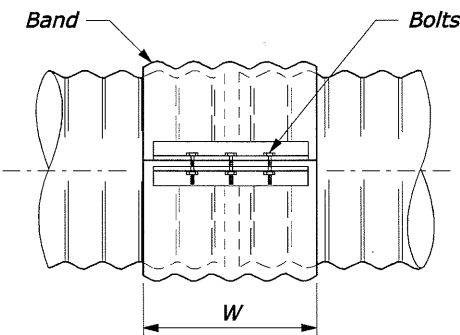


SIDE VIEW

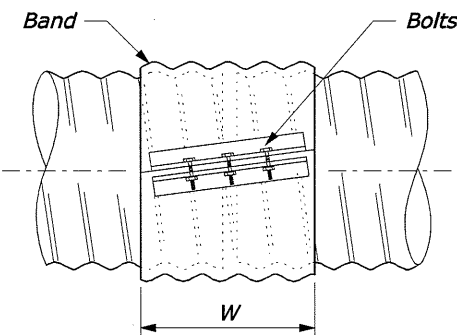


SIDE VIEW

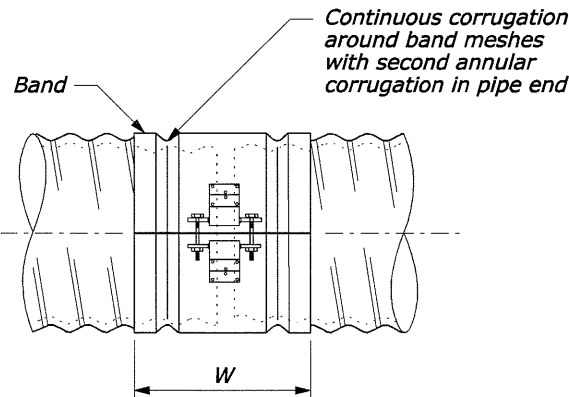


SIDE VIEW

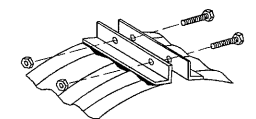


Band Angle

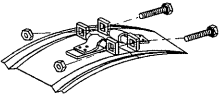


Bar & Strap

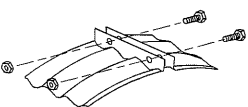

Integral Flange

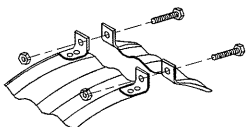


Oval Lug

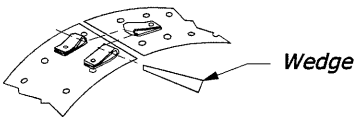

Wedge and Strap


Rivet, spot weld, or  
fillet weld at crest  
of corrugation at  
heel and toe of angle

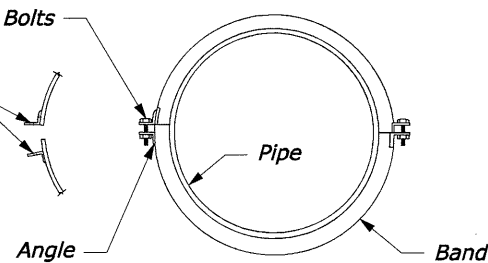

END VIEW

Second angle connection optional  
to 42" diameter, required above  
42" diameter


ANNULAR BAND

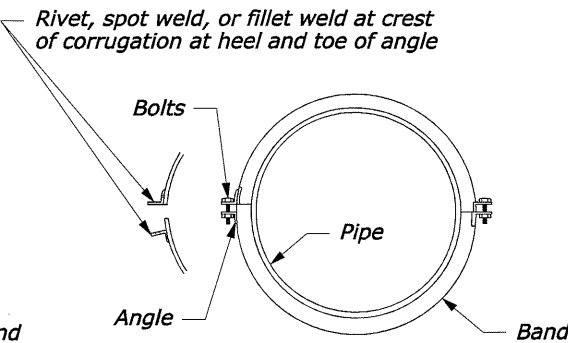

END VIEW

Second angle connection optional  
to 42" diameter, required above  
42" diameter

HELICAL BAND

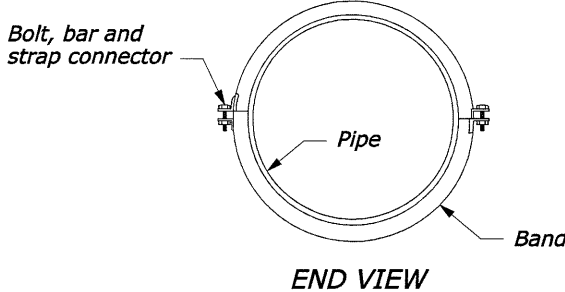


END VIEW


SEMI-CORRUGATED BAND

U.S. DEPARTMENT OF TRANSPORTATION FEDERAL HIGHWAY ADMINISTRATION FEDERAL LANDS HIGHWAY	
U.S. CUSTOMARY STANDARD	
<b>METAL PIPE CULVERT COUPLING BAND</b>	
STANDARD APPROVED FOR USE 12/1993 REVISED: 4/1994 6/2005	STANDARD 602-2


NO SCALE

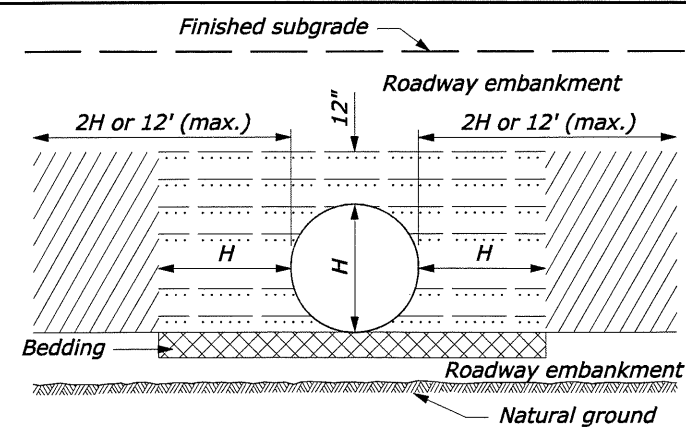

**ABOVE NATURAL GROUND**

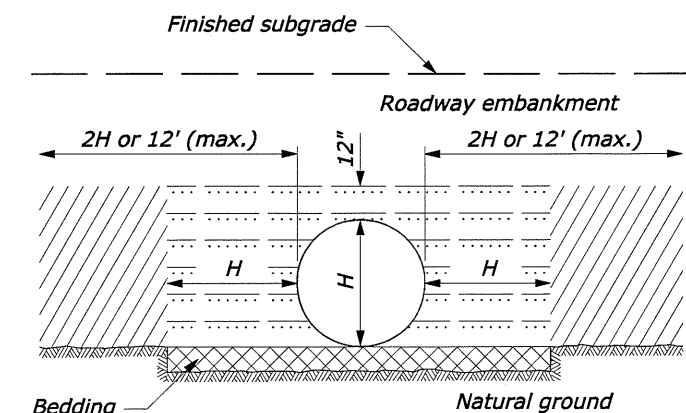


**ON NATURAL GROUND**

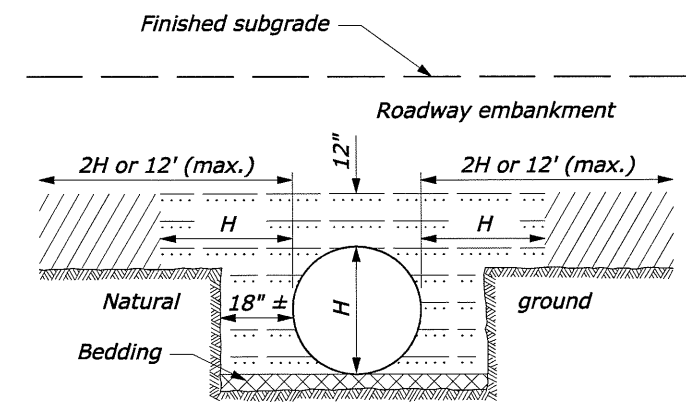


**ABOVE AND BELOW NATURAL GROUND**


- Bedding material (uncompacted)
- Embankment material placed in layers not exceeding 6" compacted depth.
- Compacted backfill material placed in layers not exceeding 6" compacted depth meeting the following:
- Metal Pipe: Maximum particle size = 3"
  - Soil classification: A-1, A-2, or A-3
  - Plastic Pipe: Maximum particle size: 1 1/2"
  - Soil classification: A-1, A-2-4, A-2-5, or A-3
  - Or lean concrete backfill in accordance with Section 614.

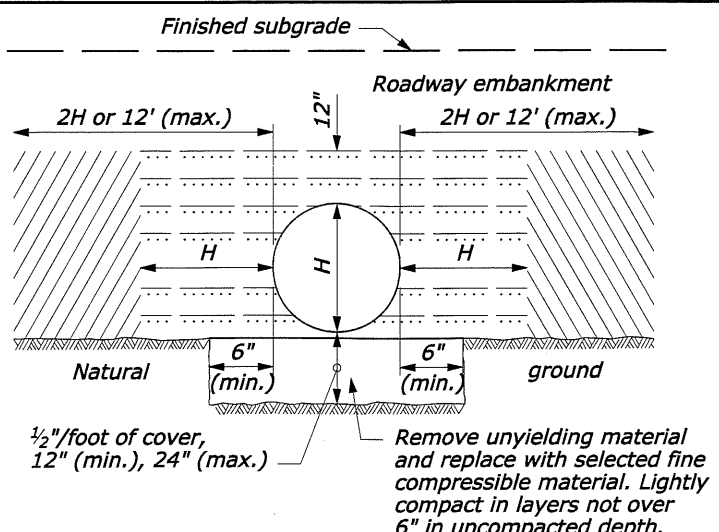

**ON UNYIELDING MATERIAL**

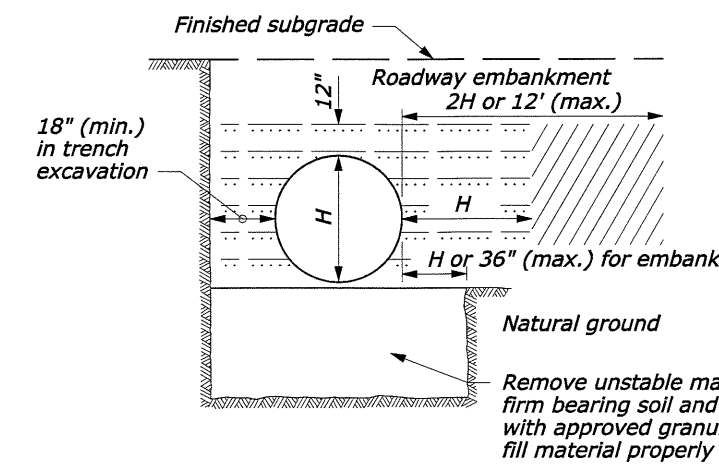


**ON UNSTABLE MATERIAL**

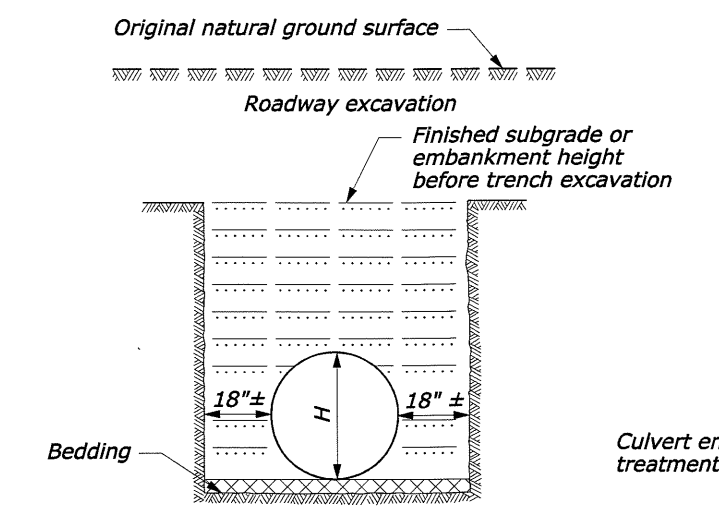

**BELOW NATURAL GROUND OR TRENCH EXCAVATION IN EMBANKMENT**

BEDDING DEPTH	
PIPE SIZE (H)	DEPTH
12" to 54"	4"
> 54"	6"

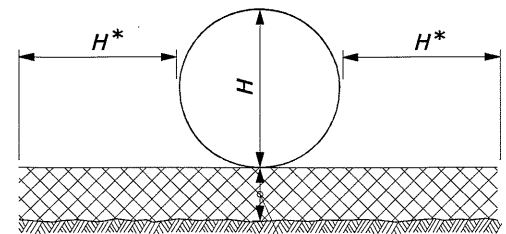


**PIPE BEDDING**

MINIMUM SPACING	
DIAMETER or SPAN	SPACING
UP to 48"	24"
48" and UP	Half diameter or span OR 36" whichever is less


**NOTE:**

1. When directed, camber pipe culverts upward from a chord through the inlet and outlet inverts an ordinate amount equal to 1% of the pipe length. Develop camber on a parabolic curve. If the midpoint elevation on the parabolic curve as designed exceeds the elevation of the inlet invert, reduce the amount of camber or increase the pipe culvert gradient.
2. H equals the diameter of all round pipe culverts or the rise dimension of all pipe arch culverts.

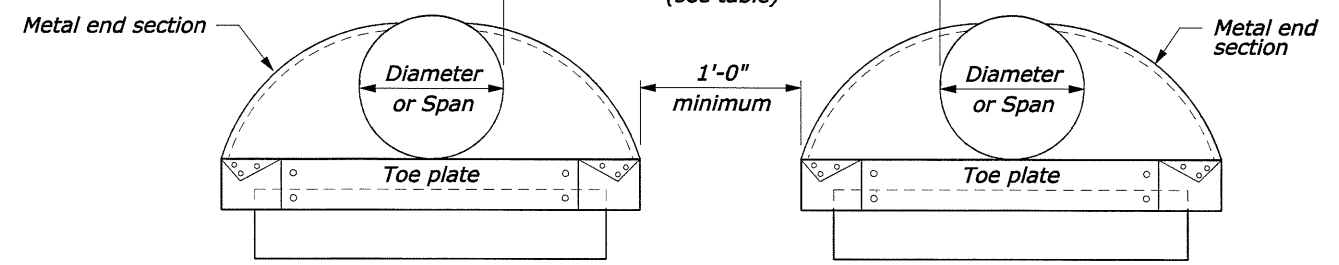

**ELEVATION**

**MULTIPLE PIPE INSTALLATION**

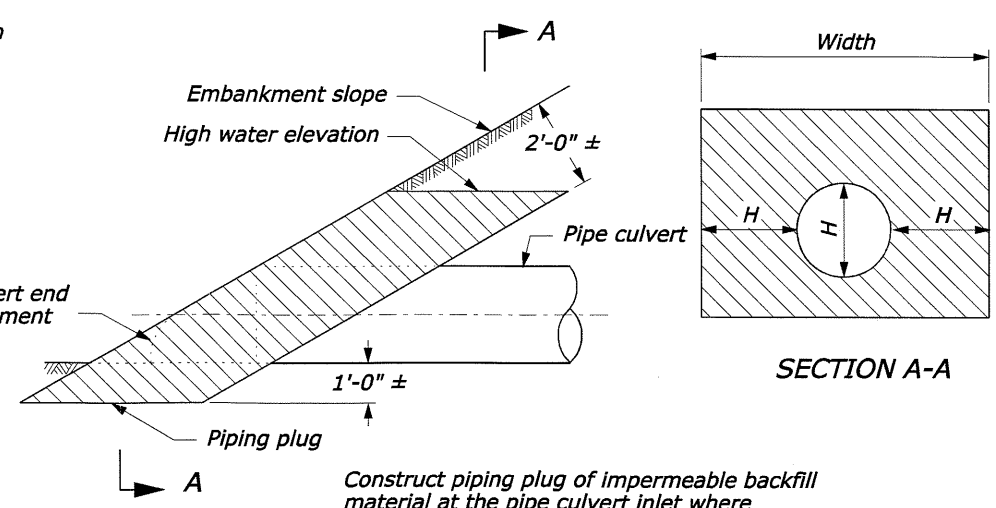

**PIPING PLUG**

**NO SCALE**

U.S. DEPARTMENT OF TRANSPORTATION  
FEDERAL HIGHWAY ADMINISTRATION  
FEDERAL LANDS HIGHWAY

U.S. CUSTOMARY STANDARD

**METAL AND PLASTIC  
PIPE CULVERT BEDDING**


STANDARD APPROVED FOR USE 12/1993  
REVISED: 4/1994 6/2005

STANDARD  
602-3



END SECTIONS FOR ROUND PIPE CULVERT

PIPE SIZE DIAMETER INCHES	METAL THICKNESS				DIMENSIONS INCHES					SLOPE  Approx.
	STEEL		ALUMINUM		A (min)	B (max)	H (min)	L (±2")	W (max)	
	INCHES	GAGE	INCHES	GAGE						
12	0.064	16	0.060	16	5	7	6	21	44	2¼
15	0.064	16	0.060	16	6	8	6	26	52	2¼
18	0.064	16	0.060	16	7	10	6	31	58	2½
21	0.064	16	0.060	16	8	12	6	36	66	2½
24	0.064	16	0.060	16	9	13	6	41	72	2½
30	0.079	14	0.075	14	11	16	8	51	88	2½
36	0.079	14	0.075	14	13	19	9	60	105	2
42	0.109	12	0.105	12	15	25	10	69	122	2½
48	0.109	12	0.105	12	17	29	12	78	131	2
54	0.109	12	0.105	12	17	33	12	84	143	2
60	0.109	12	0.105	12	17	36	12	87	157	1⅞
66	0.109	12	0.105	12	17	39	12	87	162	1⅞
72	0.109	12	0.105	12	17	44	12	87	169	1½
78	0.109	12	0.105	12	17	48	12	87	178	1⅜
84	0.109	12	0.105	12	17	52	12	87	184	1⅓
90	0.109	12	0.105	12	17	58	12	87	188	1¼
96	0.109	12	0.105	12	17	58	12	87	197	1⅞

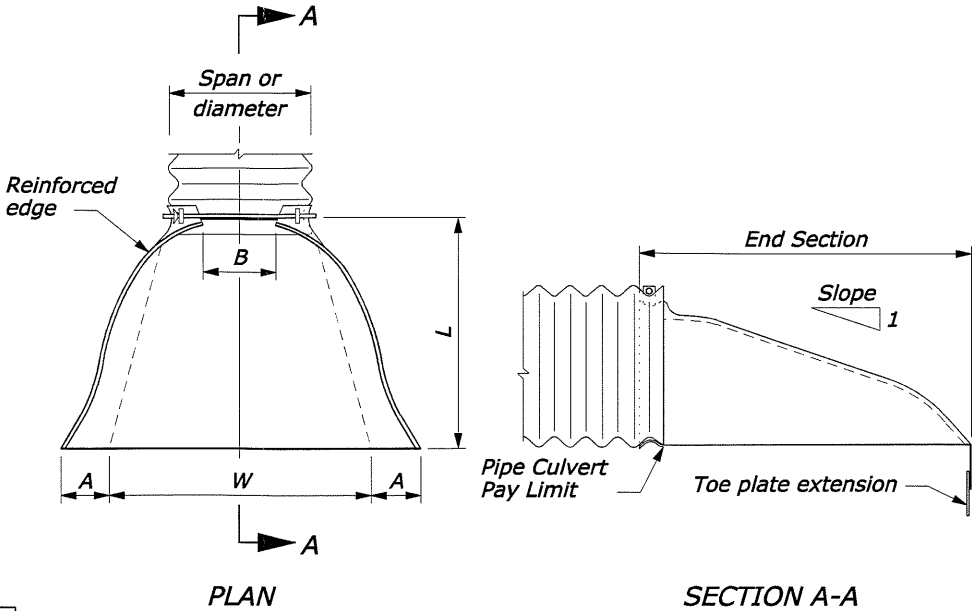


ROUND OR PIPE ARCH CULVERT

NOTE:


- Variations in design and dimensions are permitted to allow for manufacturer's standards.
- Fabricate the diameter of the end section of Design B to match the inside diameter of the concrete pipe culvert.
- Design C may be used in lieu of design A for all metal pipe culvert sizes. Coupling bands may be any acceptable type for the pipe culvert specified.
- Fabricate multiple piece bodies with lap seams tightly joined by 3/8" rivets or bolts. Fabricate end section center panels for 60" and larger diameter pipe and equivalent pipe arch from 0.138 inch steel or 0.135 inch aluminum.
- On end section center panels for 66" and larger equivalent pipe arch provide 2½" x 2½" x ¼" angle reinforcement bolted or riveted under the center panel seam.
- Supplement the reinforced edges of end sections for 60" and larger diameter pipe and 66" and larger equivalent pipe arch with 2½" x 2½" x ¼" stiffener angles attached with bolts or rivets.
- Fabricate connector section, corner plate and toe plate extensions from the same metal thickness as the panel body. Use toe plate extension where shown on the plans.
- Warp embankment slopes to match the slope of the flared end sections.

END SECTIONS FOR PIPE ARCH CULVERT


PIPE SIZE SPAN x RISE INCHES	METAL THICKNESS				DIMENSIONS INCHES					SLOPE Approx.
	STEEL		ALUMINUM		A (min)	B (max)	H (min)	L (±2")	W (max)	
	INCHES	GAGE	INCHES	GAGE						
17 x 13	0.064	16	0.060	16	5	9	6	20	52	2½
21 x 15	0.064	16	0.060	16	6	11	6	24	58	2
24 x 18	0.064	16	0.060	16	7	12	6	28	58	2½
28 x 20	0.064	16	0.060	16	7	16	6	32	66	2
35 x 24	0.079	14	0.075	14	9	16	6	39	72	1⅞
42 x 29	0.079	14	0.075	14	11	18	7	46	88	1⅞
49 x 33	0.109	12	0.105	12	12	21	9	53	105	1¾
57 x 38	0.109	12	0.105	12	16	26	12	62	122	1⅞
60 x 46	0.109	12	0.105	12	17	36	12	70	142	1⅞
64 x 43	0.109	12	0.105	12	17	30	12	69	131	1⅞
66 x 51	0.109	12	0.105	12	17	36	12	77	156	1¾
71 x 47	0.109	12	0.105	12	17	36	12	77	143	1⅞
73 x 55	0.109	12	0.105	12	17	36	12	77	168	1½
77 x 52	0.109	12	0.105	12	17	36	12	77	157	1⅞
81 x 59	0.109	12	0.105	12	17	44	12	77	179	1⅞
83 x 57	0.109	12	0.105	12	17	44	12	77	162	1½
87 x 63	0.109	12	0.105	12	17	44	12	77	186	1½
95 x 67	0.109	12	0.105	12	17	44	12	87	210	1½
103 x 71	0.109	12	0.105	12	17	44	12	87	222	1⅓
112 x 75	0.109	12	0.105	12	17	44	12	87	226	1¼

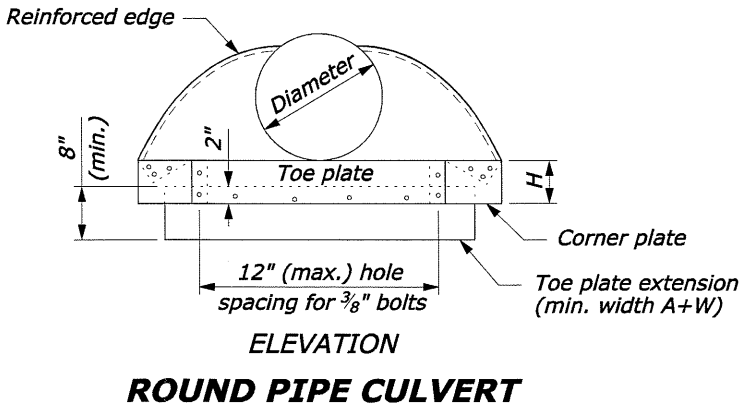


ROUND PIPE CULVERT

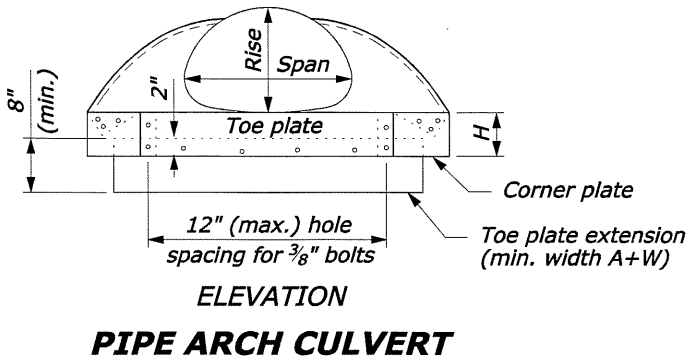


PIPE ARCH CULVERT

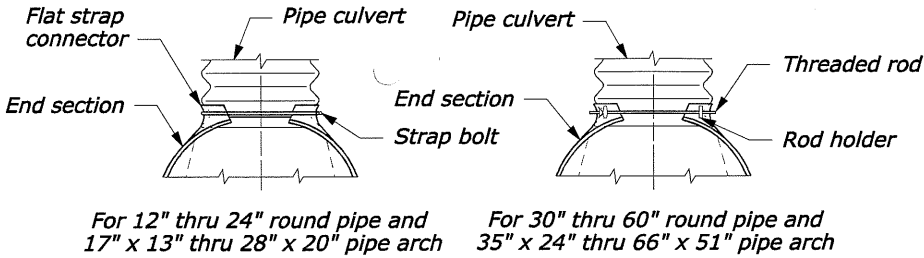

DESIGN A  
CONNECTION TO ANNULAR  
CORRUGATED METAL PIPE

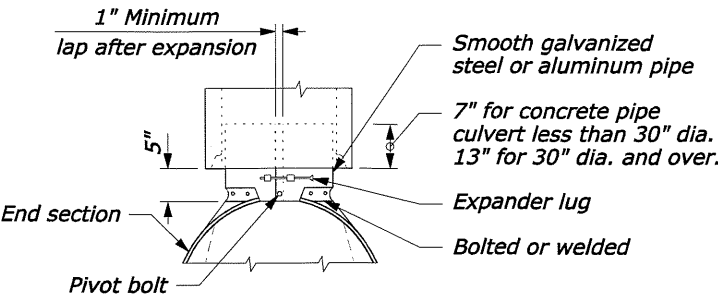

DESIGN B  
CONNECTION TO CONCRETE  
PIPE INLET END

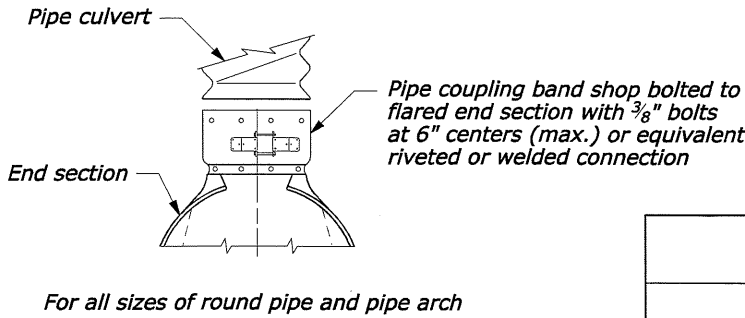

DESIGN C  
CONNECTION TO METAL PIPE  
OR OUTLET END OF CONCRETE PIPE  
NO SCALE

U.S. DEPARTMENT OF TRANSPORTATION  
FEDERAL HIGHWAY ADMINISTRATION  
FEDERAL LANDS HIGHWAY

U.S. CUSTOMARY STANDARD





METAL END SECTIONS

STANDARD APPROVED FOR USE 12/1993  
REVISED: 4/1994 6/2005  
DRAFT: 10/2007

STANDARD  
602-4

**NOTE:**

1. *D* equals the diameter of all round pipe or the rise dimension of all pipe arch culverts.

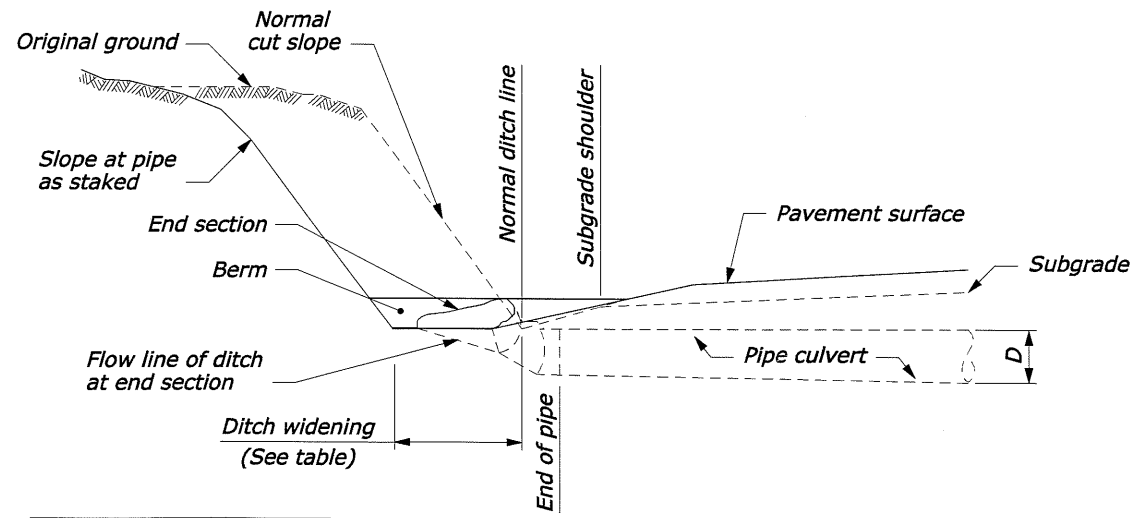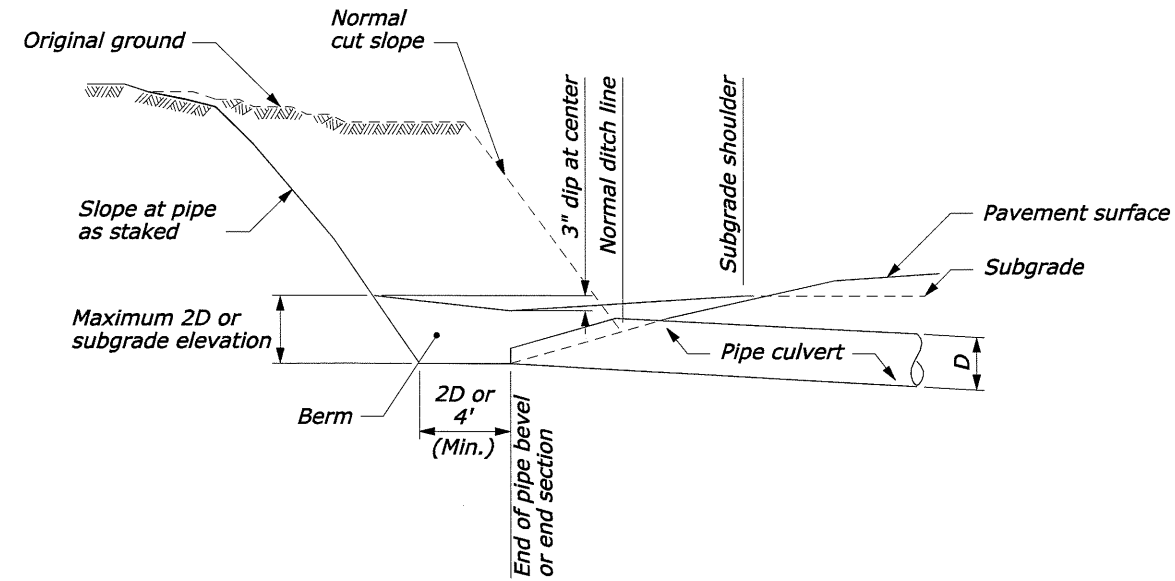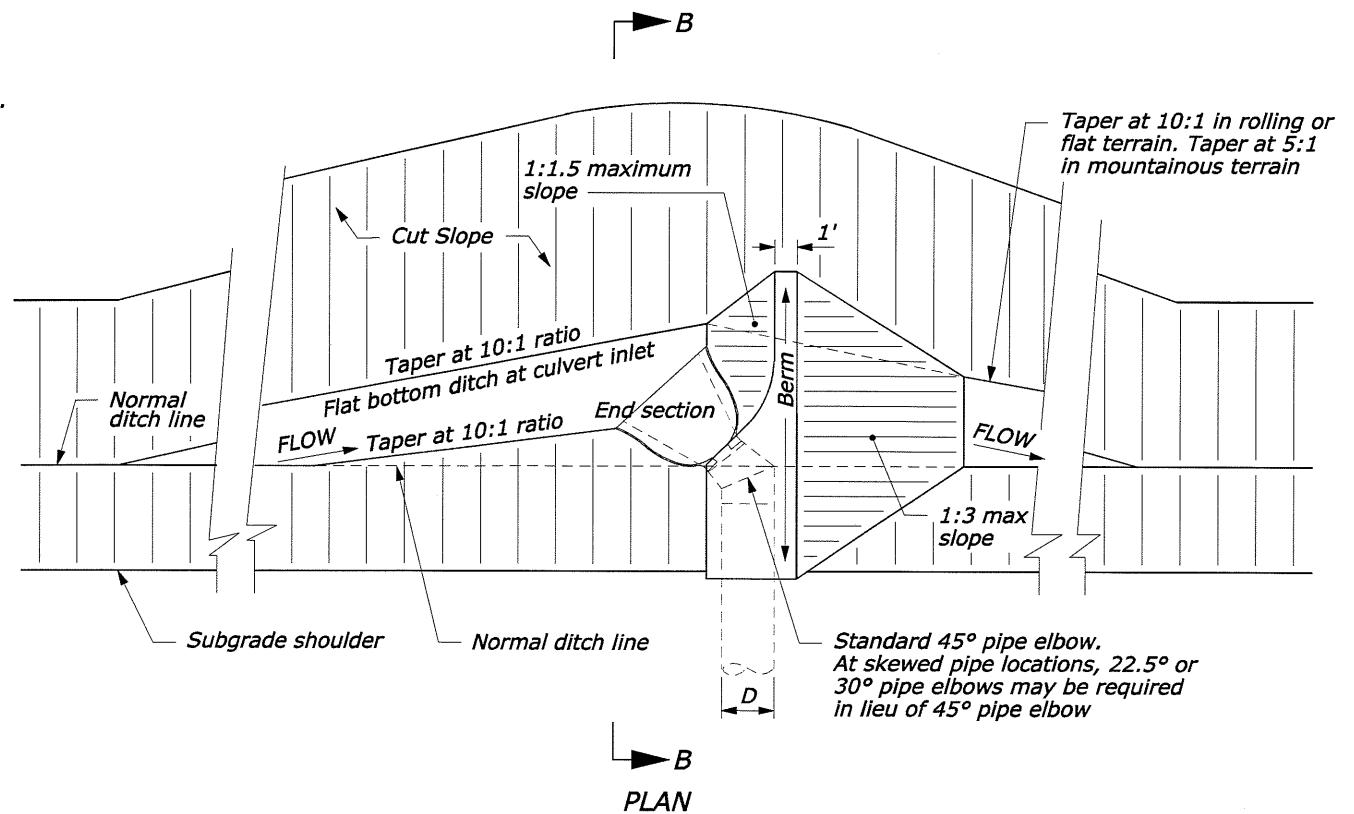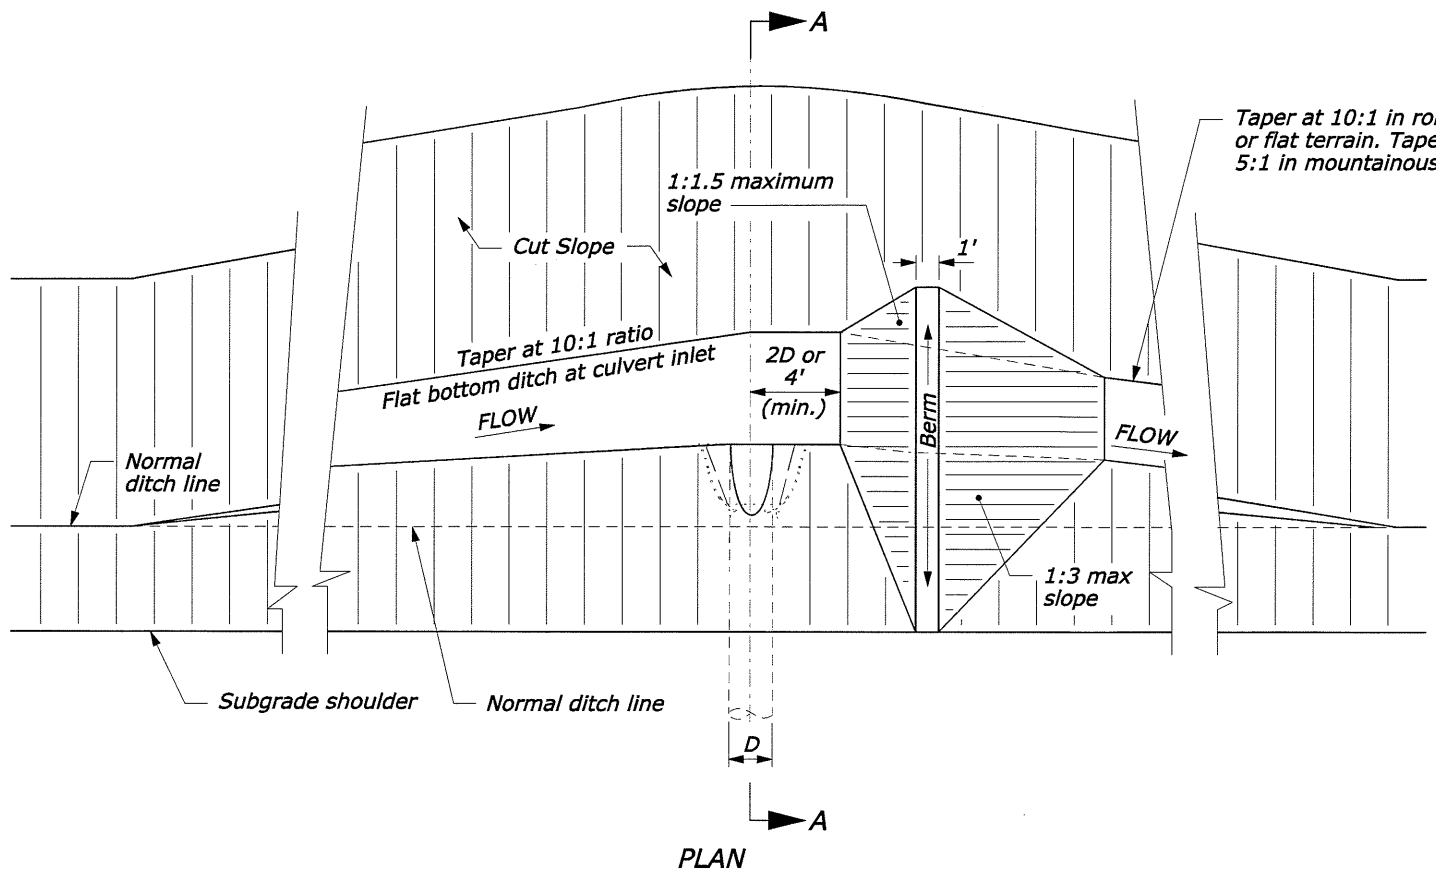

DITCH WIDENING	
PIPE SIZE (D)	WIDENING
18"	5'
24"	6'
30"	7'

**SECTION B-B  
TYPE II**


NO SCALE

U.S. DEPARTMENT OF TRANSPORTATION FEDERAL HIGHWAY ADMINISTRATION FEDERAL LANDS HIGHWAY	
U.S. CUSTOMARY STANDARD	
<b>PIPE CULVERT INLET TREATMENT IN CUT SLOPES</b>	
STANDARD APPROVED FOR USE 12/1993 REVISED: 4/1994 6/2005	STANDARD 602-6

23-Jul-2012 01:41 PM  
...Design\Drainage\dc0908e\dgn



STATE	PROJECT	SHEET NUMBER
AK	DEN 2009(8)	H.1

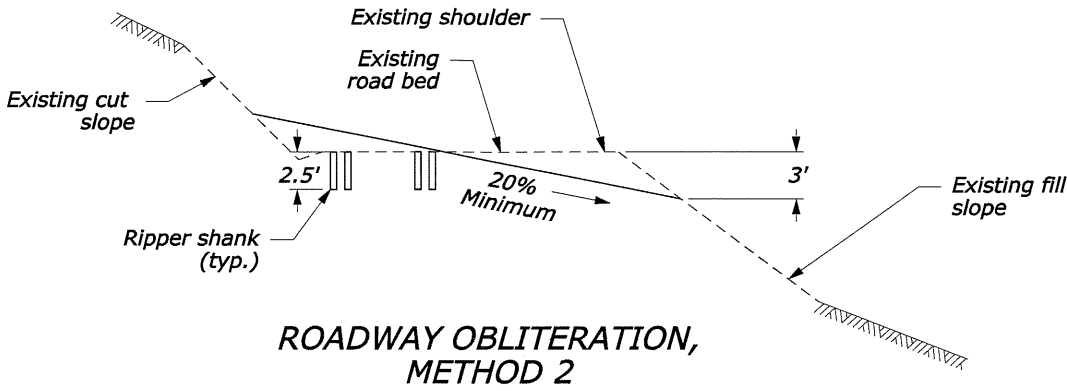

1. Rip the inside lane using two passes with a minimum of two ripper shanks.
2. Excavate outside shoulder 3' deep.
3. Outslope roadbed 20% minimum.
4. Place excavated shoulder material against back slope.

**NOTE:**  
1. See Sheet D.1 for locations and quantities.  
2. See Section 211.

**ROADWAY OBLITERATION  
DETAILS**

NO SCALE

7/2012 7/2012 7/2012 23-Jul-2012 01:27 PM ...\\miscellaneous\dc0908qb.dgn


B. Thompson

Checked by:


N. Bell

Designed by:

STATE	PROJECT	SHEET NUMBER
AK	DEN 2009(8)	H.2

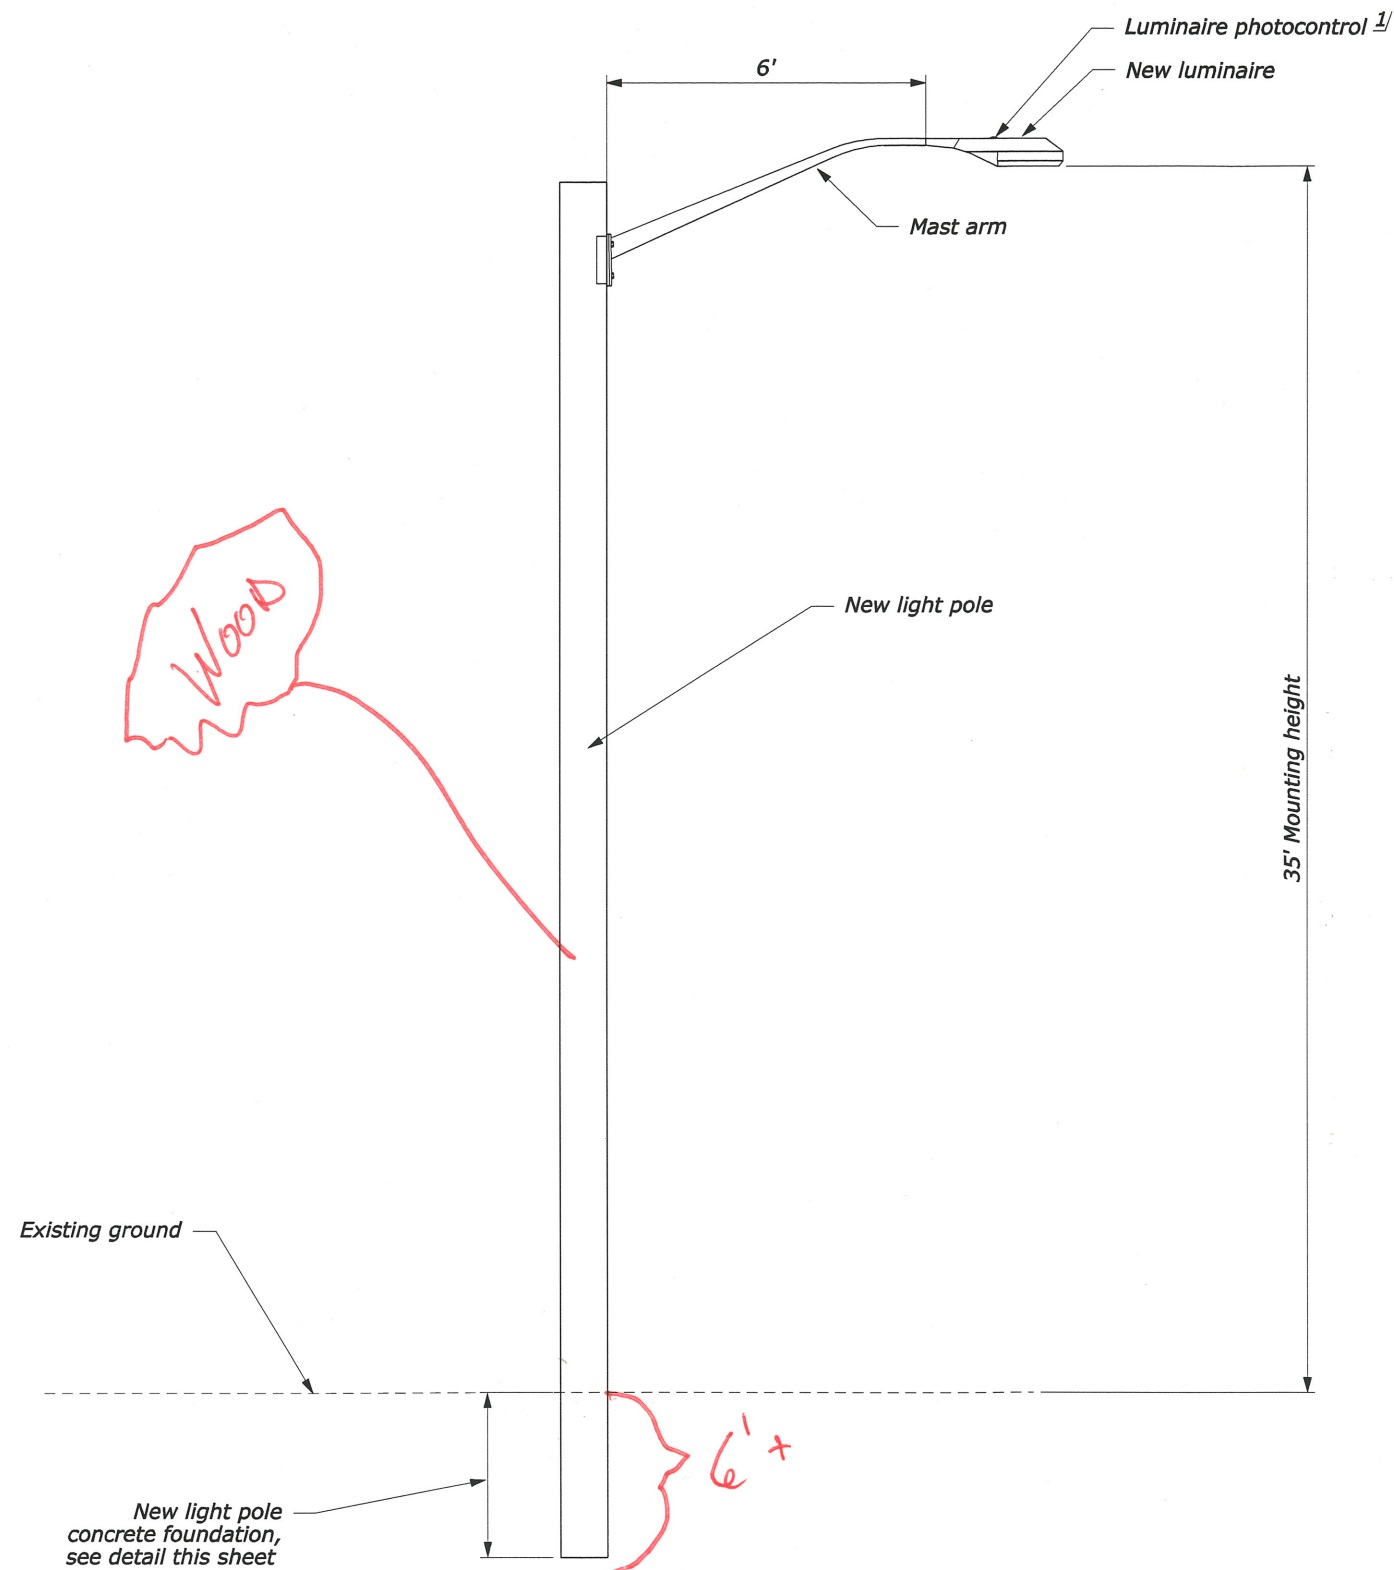

LUMINAIRE DETAIL

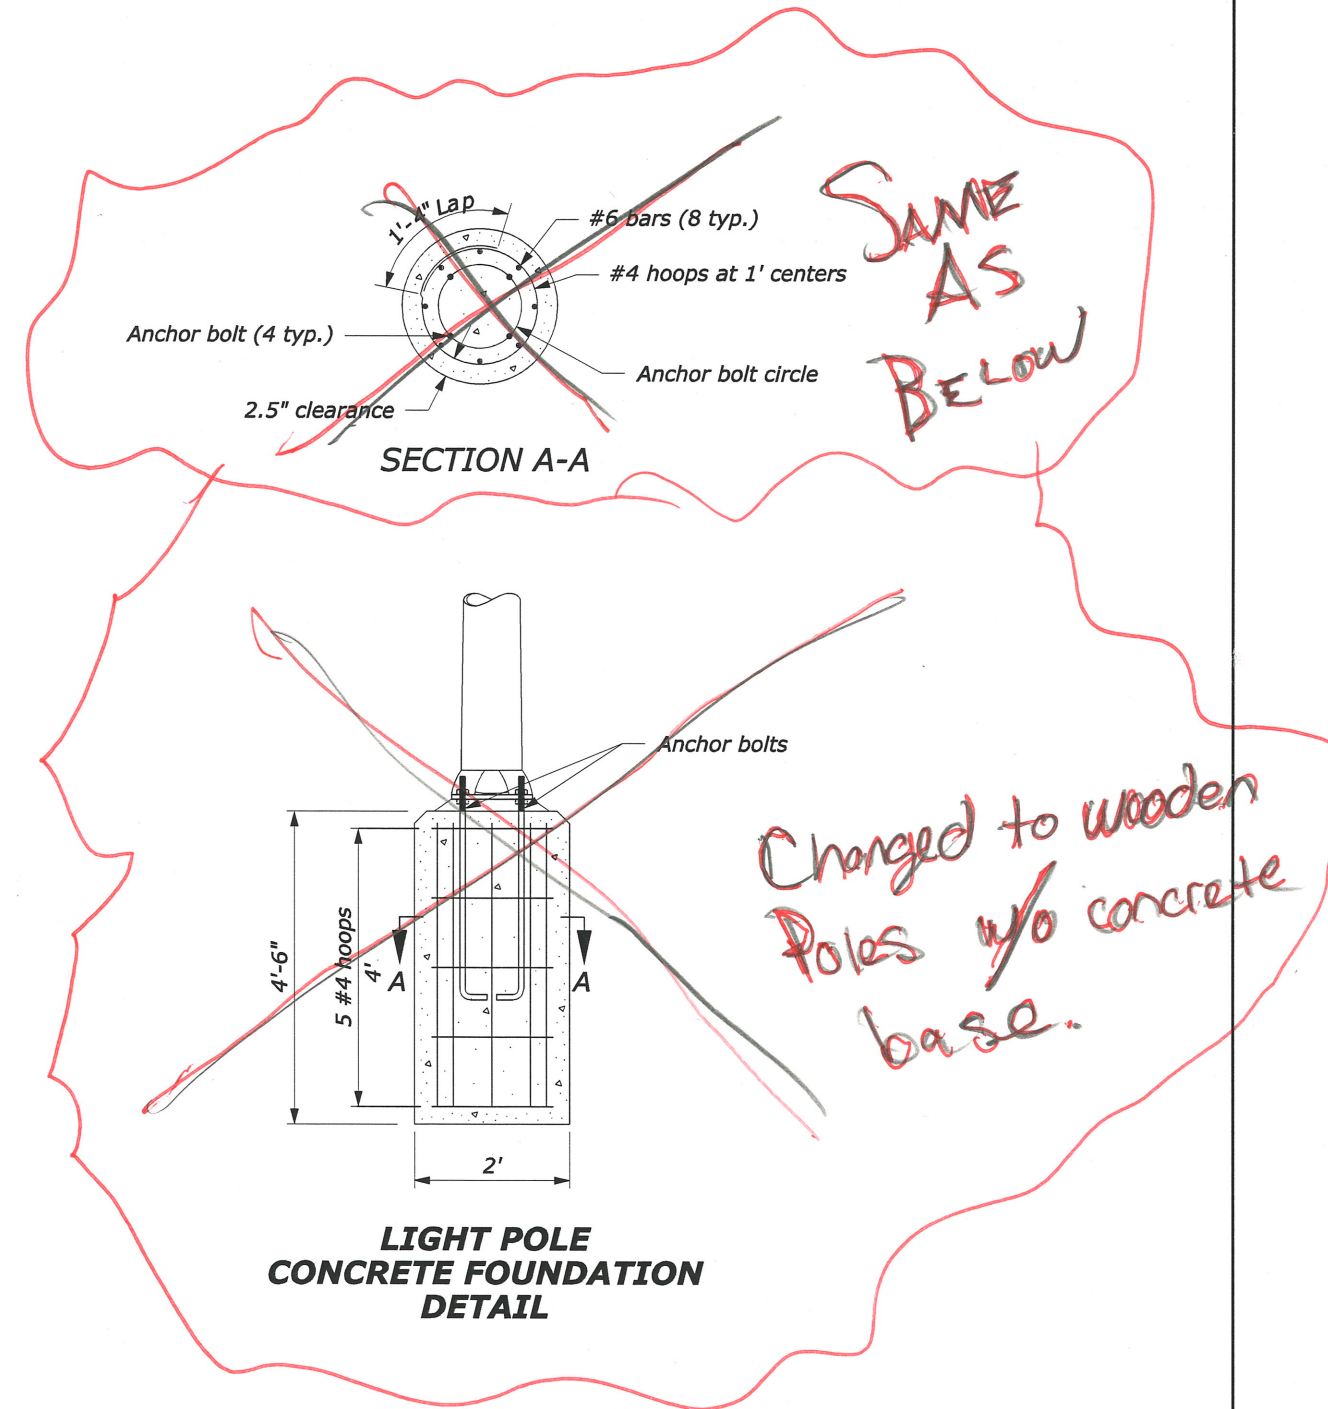

FOOTNOTE:

<sup>1/</sup> Mount luminaire photocontrol on first system luminaire.


LIGHTING SYSTEM  
INSTALLATION DETAILS

NO SCALE



7/2012 B. Thompson 7/2012 Checked by: 7/2012 N. Bell 09-Aug-2012 02:42 PM Designed by: ...\\miscellaneous\\dc0908qc.dgn

STATE	PROJECT	SHEET
AK	DEN 2009(8)	NUMBER
		H.3

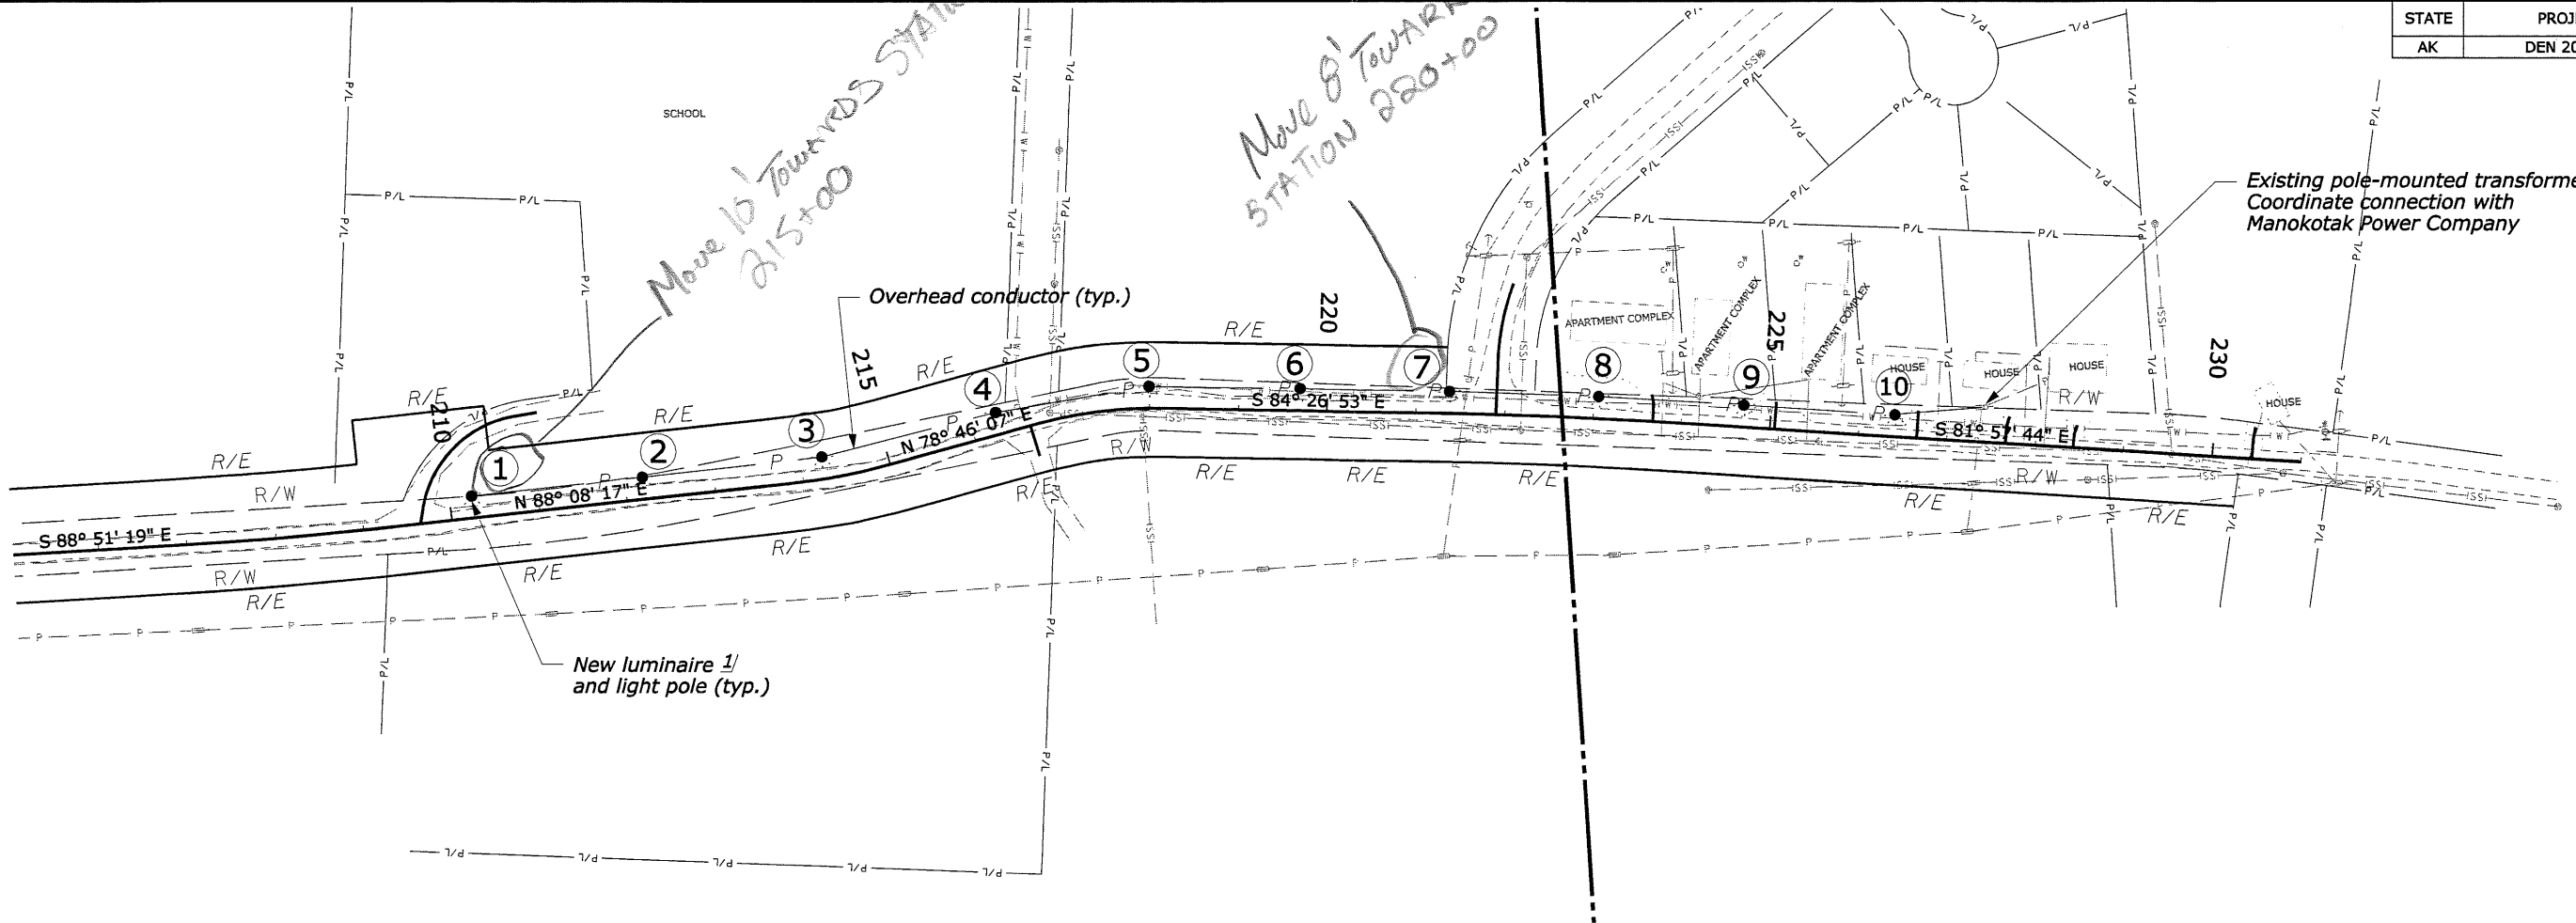

LIGHTING SYSTEM PLAN


LUMINAIRE SCHEDULE		
Station	Luminaire No.	Offset from $\bar{C}$ (ft)
210+25 LT	1	25
212+20 LT	2	25
214+25 LT	3	25
216+30 LT	4	25
218+00 LT	5	25
219+69 LT	6	25
221+37 LT	7	25
223+05 LT	8	25
224+69 LT	9	25
226+40 LT	10	25

FOOTNOTE:  
1/ See Sheet H.2 for details.


LIGHTING SYSTEM  
INSTALLATION DETAILS

7/2012  
B. Wacker  
Checked by:  
7/2012  
N. Bell  
Designed by:  
23-Jul-2012 01:42 PM  
...\\miscellaneous\\dc0908qd.dgn

STATE	PROJECT	SHEET NUMBER
AK	DEN 2009(8)	H.4

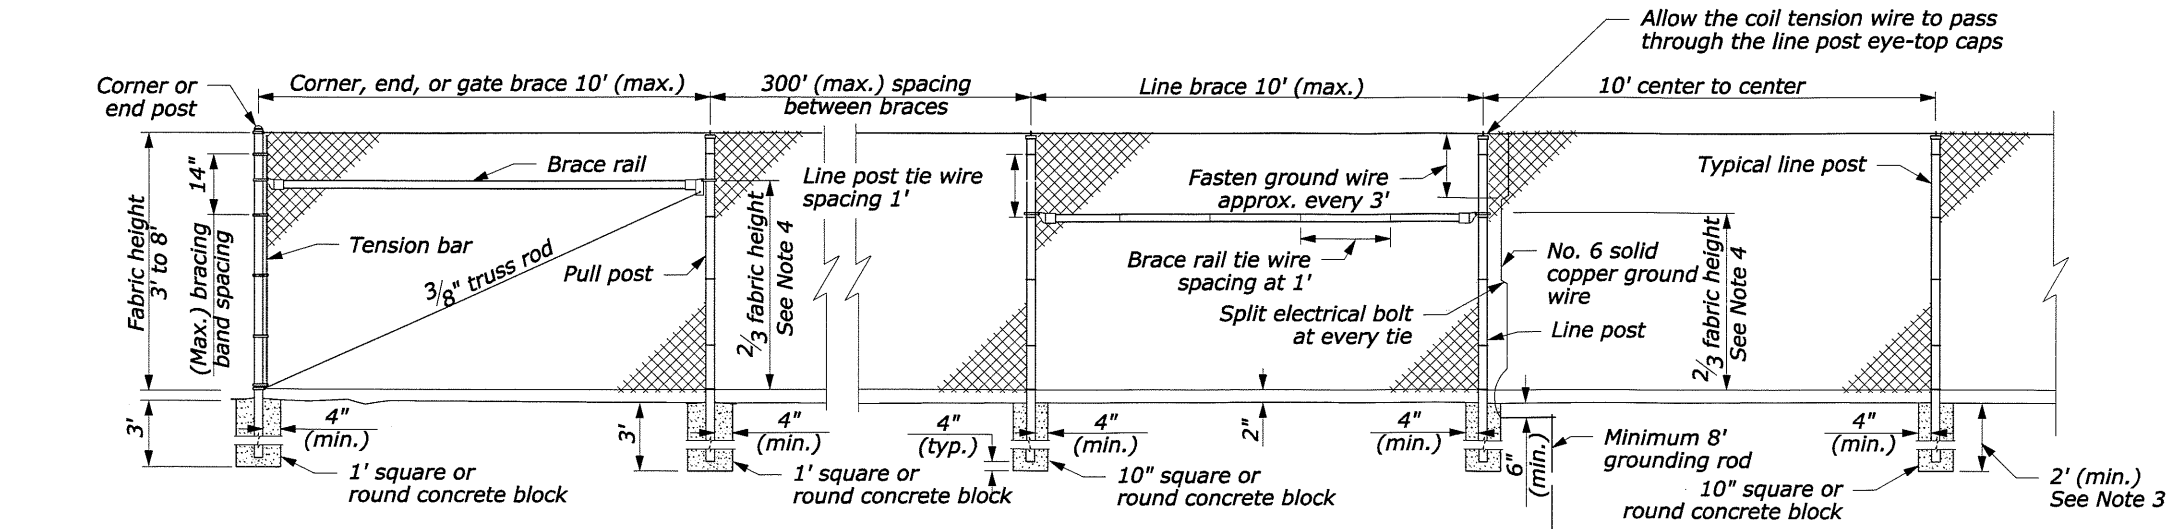


- NOTE:**
1. Set all posts in concrete. Set corner, end, pull posts to the dimensions shown. The minimum depth of concrete for line posts is 24". Increase depth 3" for each additional 1' of fence height over 4'.
  2. Install braces on all terminals on fences without a top rail. No braces are required on fabric 6' in height or less where a top rail is specified. Install braces where fabric is over 6' in height. Where a top rail is used, attach the brace at the halfway point of the terminal post above grade and, where the rail is omitted, at the two-thirds point above grade. Do not install top rail unless so specified in the special contract requirements.
  3. Adjust the post top elevations to provide a smooth visual fence profile. Install corner posts at horizontal breaks in the fence of 15° or more.
  4. Provide fence fabric with a 2" mesh. Use 11 gage wire in fabric heights of 4' or less and 9 gage wire in fabric heights greater than 4'. Provide a Class D coating when zinc-coated steel fence fabric is provided. Knuckle both selvages on fabric less than 6' high. For fabric 6' high or higher, knuckle one selvage and twist the other.
  5. See Sheet H.5 for hardware requirements.

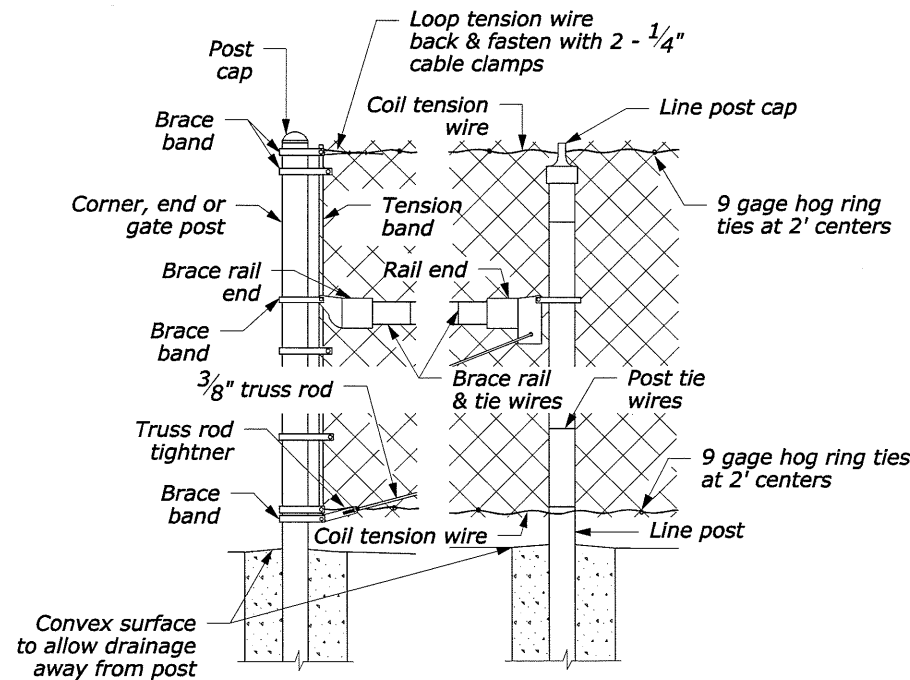


**CHAIN LINK DETAIL**


CHAIN LINK FENCE				
POST SIZE AND WEIGHT TABLE				
DESCRIPTION	ROUND PIPE			
	Steel		Aluminum	
	Min. yield strength (psi)			
	25,000		25,000	
	Size and mass			
	OD (inches)	mass (lb/ft)	OD (inches)	mass (lb/ft)
Brace rail & top rail	1.660	2.27	1.660	0.79
Line post	2.375	3.65	2.375	1.25
End, corner, & pull post	2.875	5.79	2.875	2.00

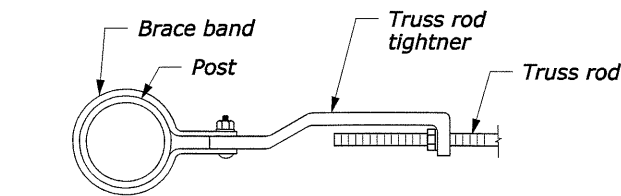

**TRUSS ROD TIGHTENER DETAIL**

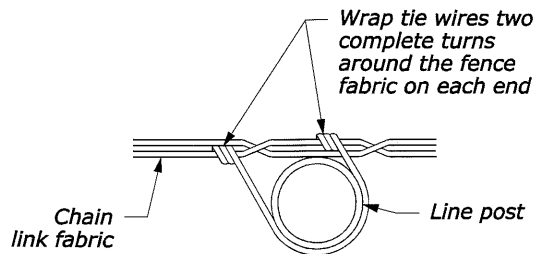

**CHAIN LINK FENCE TIE DETAIL**

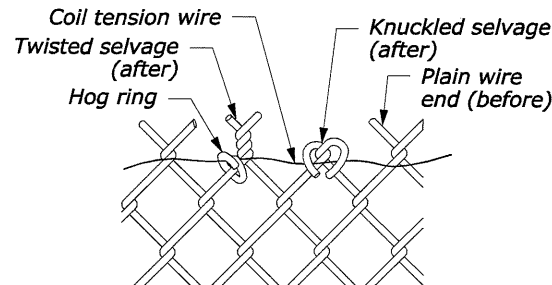

**WIRE SELVAGE DETAIL**








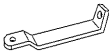
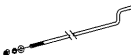
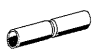




## CHAIN LINK FENCE DETAILS

NO SCALE



7/2012  
B. Wacker  
Checked by:  
7/2012  
N. Bell  
Designed by:  
23-Jul-2012 01:43 PM  
...\\Miscellaneous\\dc0908qe.dgn

STATE	PROJECT	SHEET NUMBER
AK	DEN 2009(8)	H.5

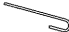HARDWARE ITEM DESCRIPTION		STANDARD REQUIREMENTS
Brace rail and top rail		See table on Sheet H.4
Line post		See table on Sheet H.4
Corner, end and pull posts		See table on Sheet H.4
Post cap		Cast non-ferrous alloy or galvanized pressed steel cap must fit snugly on post and gate top
Line post cap		Galvanized pressed steel minimum 0.09" thickness or galvanized malleable ferrous alloy
Tension band		Minimum 1/8" x 3" galvanized steel
Brace band		Minimum 1/8" x 3" galvanized steel
Band bolt		Minimum 3/8" x 1.75" galvanized carriage bolt, (Lock washer & flat washer for each band)
Rail end		Galvanized pressed steel or galvanized malleable ferrous alloy minimum 3/8" thickness on back bolting appendage
Brace rail end		Galvanized pressed steel or galvanized malleable ferrous alloy minimum 3/8" thickness on back bolting appendage
Truss rod tightener		Minimum 3/8" formed galvanized steel
Truss rod		3/8" galvanized, NC threaded rod, lock washer, & flat washer with two 90° bends opposite of threaded end
Top rail sleeve		Galvanized steel 0.05" minimum thickness by 6" minimum length
Tension bar		Minimum 3/16" x 3" galvanized steel
Fence fabric		2" diamond mesh fabric, See Note 4 on Sheet H.4
Tie wires		Minimum 9 gage aluminum with one hooked end
Coil tension wire		7 gage metallic coated wire

**NOTE:**  
1. The design of the chain link hardware may vary from the details shown, however, all hardware and materials used in a single installation shall be uniform and compatible.

**CHAIN LINK FENCE  
DETAILS**

NO SCALE

F:\highways\FHWA\12500001\_Marokotak\Design\Temporary Traffic Control\cd0908\_Section J 20-Jul-2012 3:04 PM Designed by: N. Bell 7/2012 Checked by: B. Wacker 7/2012

STATE	PROJECT	SHEET NUMBER
AK	DEN 2009(8)	I.1

ITEM 63504-1000 TEMPORARY TRAFFIC CONTROL, CONSTRUCTION SIGN					
Sign Number	MUTCD Number	Description	Sign size (in x in)	Number of signs	Quantity (SQFT)
1	G20-1	ROAD WORK NEXT 4 MILES	36 x 18	2	9
2	G20-2	END ROAD WORK	36 x 18	6	27
3	W20-1	ROAD WORK AHEAD	36 x 36	8	72
4	W20-4	ONE LANE ROAD AHEAD	36 x 36	2	18
5	W20-7a	FLAGGER (SYMBOL)	36 x 36	4	36
6	W3-4	BE PREPARED TO STOP	36 x 36	2	18
Schedules A, B, & C Total					180

SUMMARY OF TEMPORARY TRAFFIC CONTROL DEVICES - SCHEDULES A, B, & C			
Item Number	Description	Unit	Quantity
63502-1000	Temporary traffic control, cone, type 36-inch	EACH	50
63502-1300	Temporary traffic control, drum	EACH	25

SUMMARY OF TEMPORARY TRAFFIC CONTROL FLAGGER HOURS					
Item Number	Description	Unit	Schedule A	Schedule B	Schedule C
63509-1000	Temporary traffic control, flagger	FIX HR RATE	4,000.0	3,200.0	2,000.0

TABULATION OF TEMPORARY TRAFFIC CONTROL QUANTITIES






LENGTH AND SPACING TABLE	
APPROACH SPEED*	BUFFER SPACE LENGTH
MPH	FEET
20	115
25	155
30	200
35	250
40	305
45	360
50	425
55	495
60	570
65	645
70	730

\* Approach speed based on the regulatory posted speed, not the advisory speed.

SIGN SPACING TABLE			
ROAD TYPE	DISTANCE BETWEEN SIGNS IN FEET		
	A	B	C
Urban and Rural 30 MPH and less	100	100	100
Urban and Rural 35 MPH to 50 MPH	350	350	350
Rural greater than 50 MPH	500	500	500
Expressway / Freeway	1000	1500	2640

NOTE:

1. Signs are shown for one direction of travel only. Place devices similar to those depicted for the opposite direction of travel.
2. Final location and spacing of signs and devices may be changed to fit field conditions as approved by the CO.
3. For pilot car operation, mount the "PILOT CAR FOLLOW ME" (G20-4) sign at a conspicuous location on the rear of vehicle. Prominently display the name of the Contractor on the pilot car.
4. If closure is completely within the project limits, eliminate the "ROAD WORK AHEAD" (W20-1) and "END ROAD WORK" (G20-2) signs.
5. For night time flagging operation, provide floodlighting at flagger stations.
6. Do not allow equipment, materials, or vehicles to be parked or stored in the buffer space.

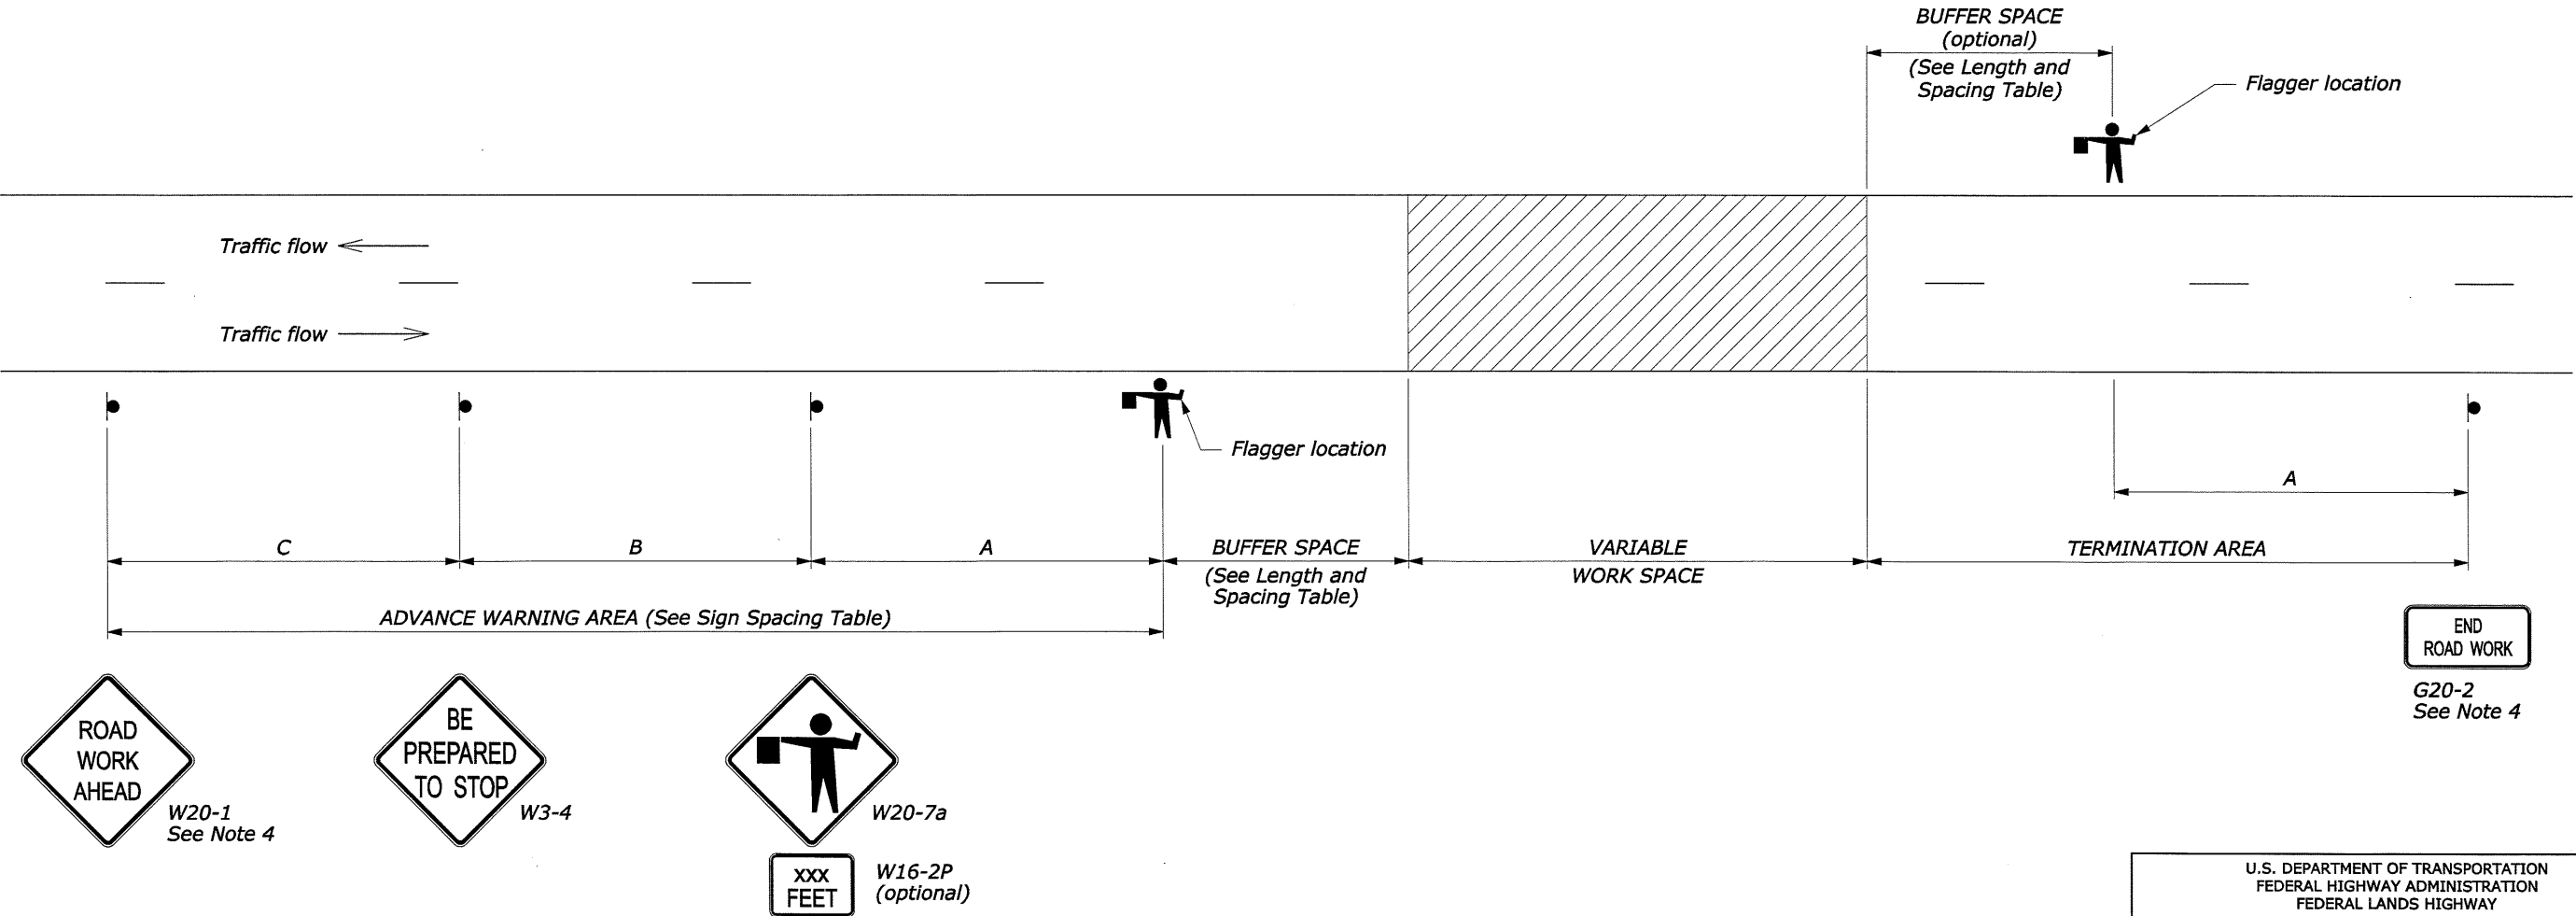




LENGTH AND SPACING TABLE				
APPROACH SPEED*	BUFFER SPACE LENGTH	CHANNELIZING DEVICE		
		TAPER AREA	BUFFER SPACE	WORK SPACE
MPH	FEET	SPACING IN FEET		
20	115	20	40	40
25	155	20	50	50
30	200	20	60	60
35	250	20	70	70
40	305	20	80	80
45	360	20	90	90
50	425	20	100	100
55	495	20	110	110
60	570	20	120	120
65	645	20	130	130
70	730	20	140	140


\* Approach speed based on the regulatory posted speed, not the advisory speed.

SIGN SPACING TABLE			
ROAD TYPE	DISTANCE BETWEEN SIGNS IN FEET		
	A	B	C
Urban and Rural 30 MPH and less	100	100	100
Urban and Rural 35 MPH to 50 MPH	350	350	350
Rural greater than 50 MPH	500	500	500
Expressway / Freeway	1000	1500	2640


NOTE:

1. Signs are shown for one direction of travel only. Place devices similar to those depicted for the opposite direction of travel.
2. Final location and spacing of signs and devices may be changed to fit field conditions as approved by the CO.
3. For pilot car operation, mount the PILOT CAR FOLLOW ME (G20-4) sign at a conspicuous location on the rear of vehicle. Prominently display the name of the contractor on the pilot car.
4. If closure is completely within the project limits, eliminate the "ROAD WORK AHEAD" (W20-1) and "END ROAD WORK" (G20-2) signs.
5. For night time flagging operation, provide floodlighting at flagger stations.
6. For project specific minimum width, refer to the Special Contract Requirements, Section 156.
7. Do not allow equipment, materials, or vehicles to be parked or stored in the buffer space.

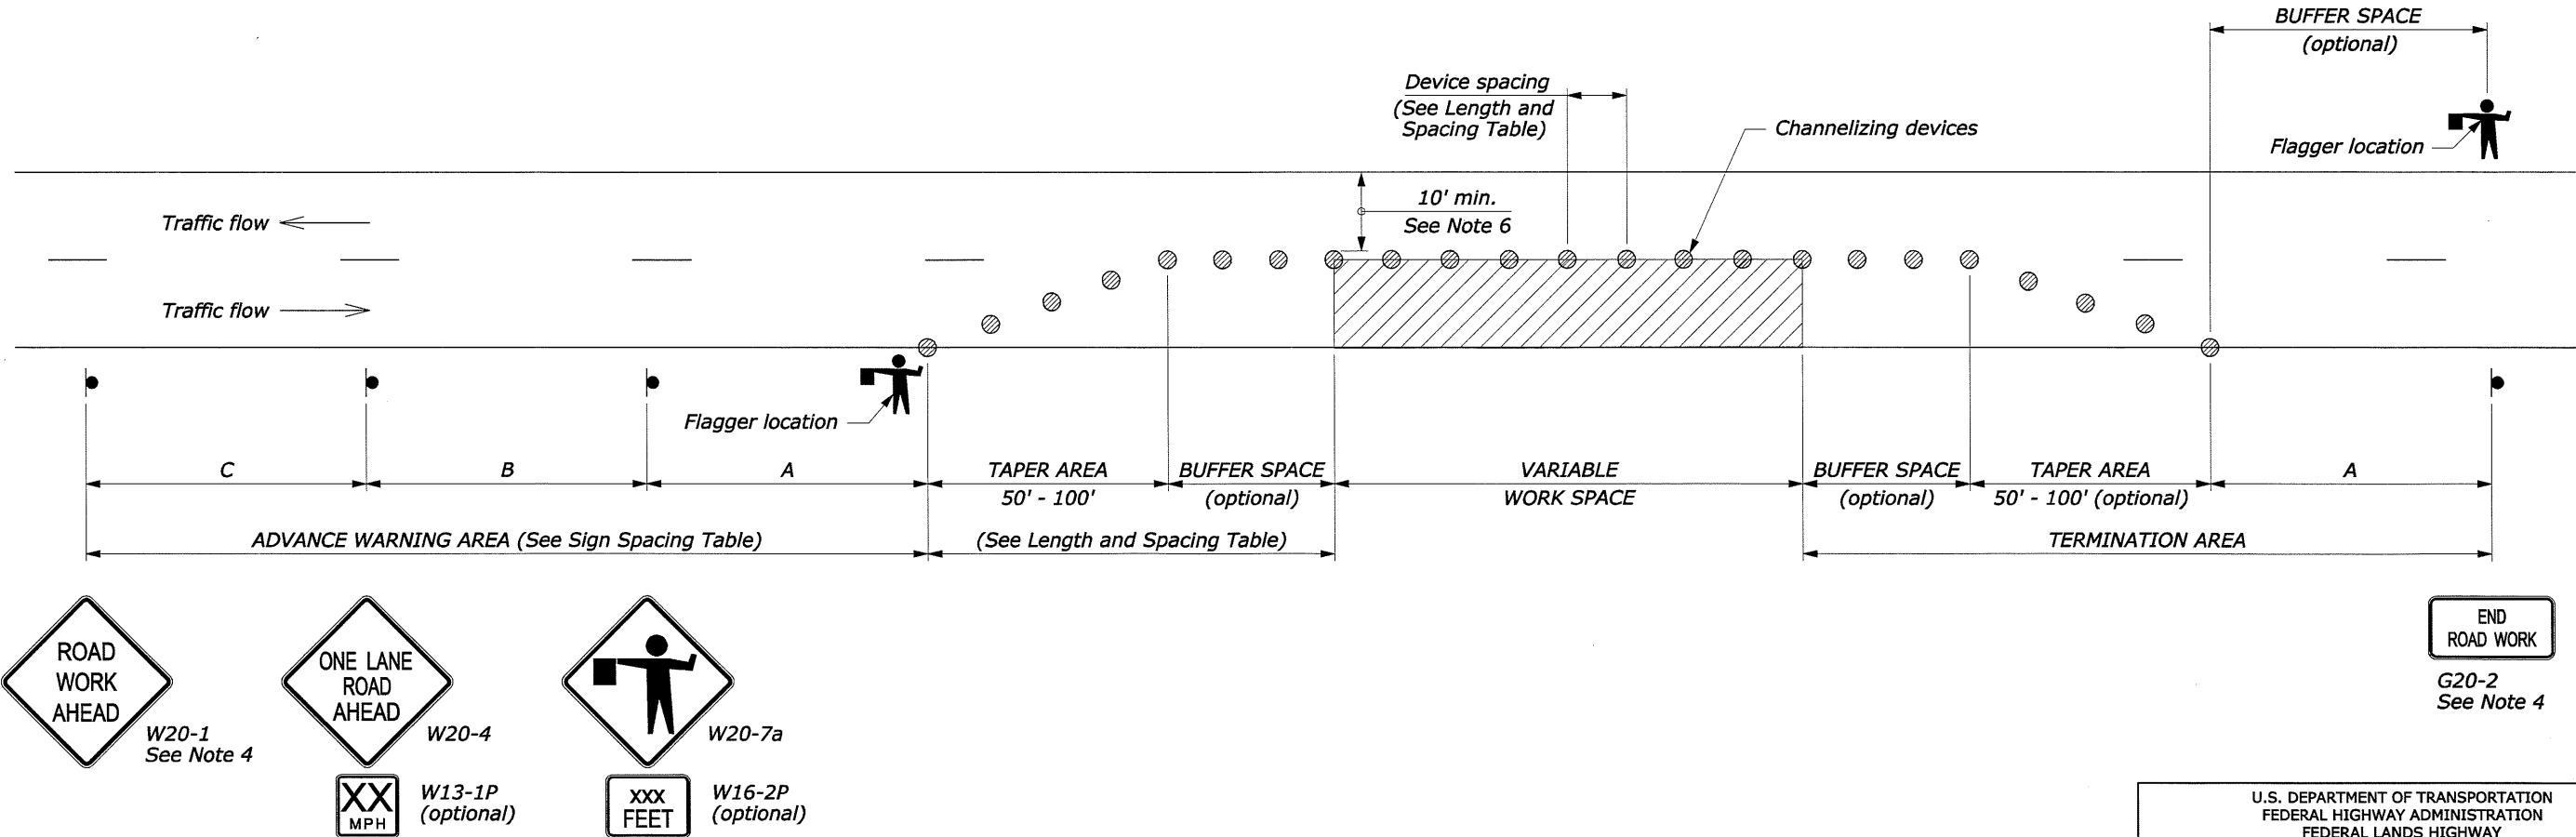


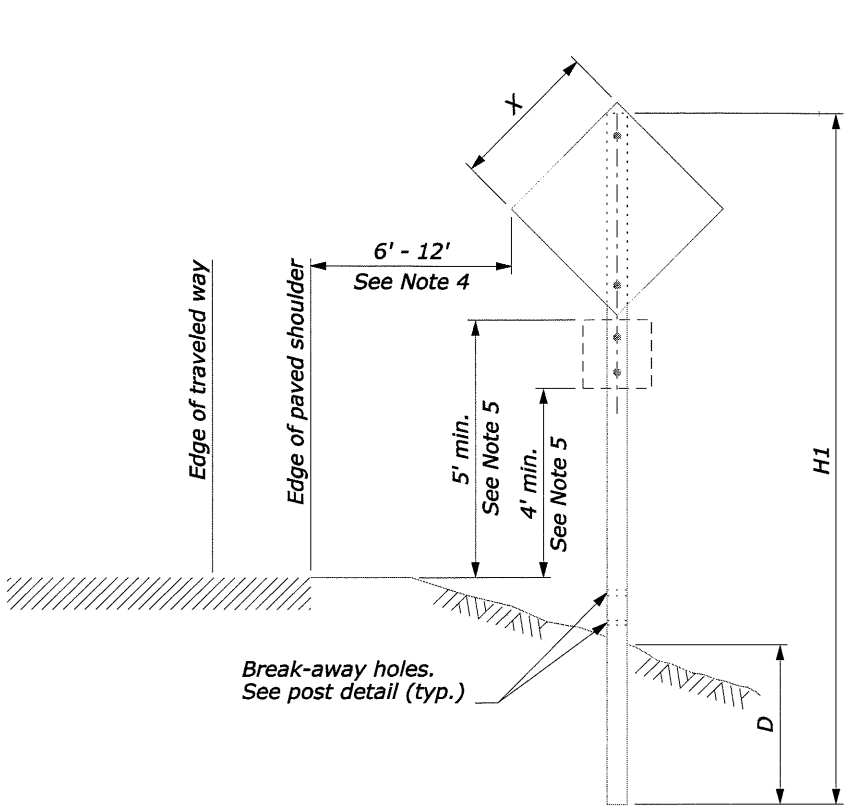

**SINGLE POST SIGN**

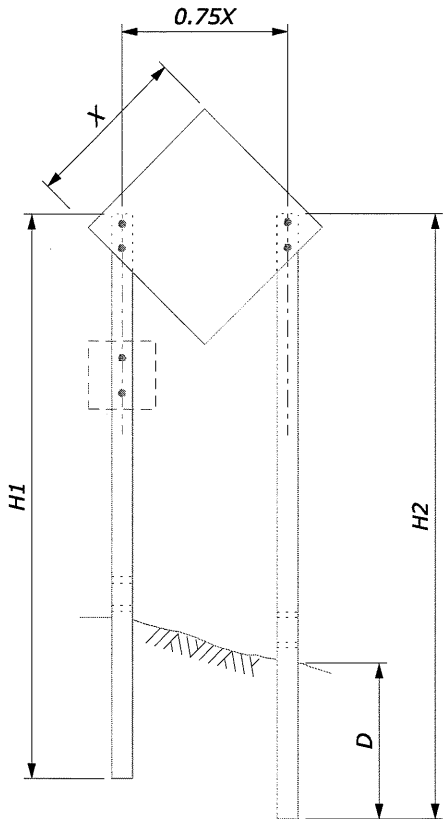


**TWO POST SIGN**

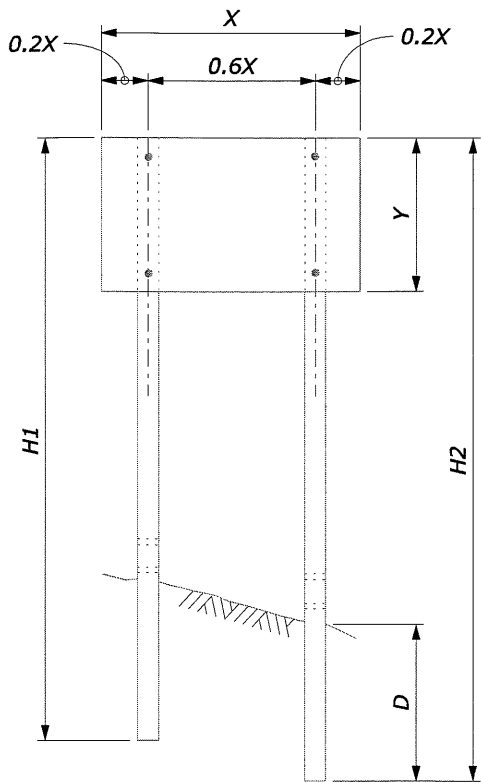


**NOTE:**

1. Attach sign panels with a minimum of 2 - 1/4" dia. bolts per post.
2. H1 and H2 = Overall post length. Select post lengths to fit field conditions.
3. D = Post embedment depth for average soil conditions.
4. In rural areas where lateral distance is limited, a minimum lateral offset of 2' may be used. In urban areas, a minimum lateral offset of 1' behind the face of the curb may be used.
5. In pedestrian locations, or in areas where the view is obstructed, use 7' minimum mounting height for main sign and 6' minimum mounting height for secondary sign.
6. Use 7' minimum spacing between posts for sign posts 6" x 6" or larger.
7. State standards may be used as an alternative if approved by the CO.

WOOD POST SELECTION TABLE					
WIDTH "X"	AREA (SQFT)	NUMBER OF POSTS	POST SIZE (INCH)	D (INCH)	HOLE SIZE (INCH)
Diamond ≤ 36" Other Shapes ≤ 48"	< 10	1	4 x 4	36	0
		1	4 x 6	48	1.5
Diamond ≤ 48" Other Shapes ≤ 12'	10 - 20	1	6 x 6	48	2
		2	4 x 4	36	0
> 13'	20 - 50	2	4 x 6	48	1.5
		2	6 x 6	48	2
12' - 16'	50 - 65	3	4 x 6	48	1.5
> 17'	65 - 95	4	4 x 6	48	2
> 30'	65 - 95	3	6 x 6	48	2

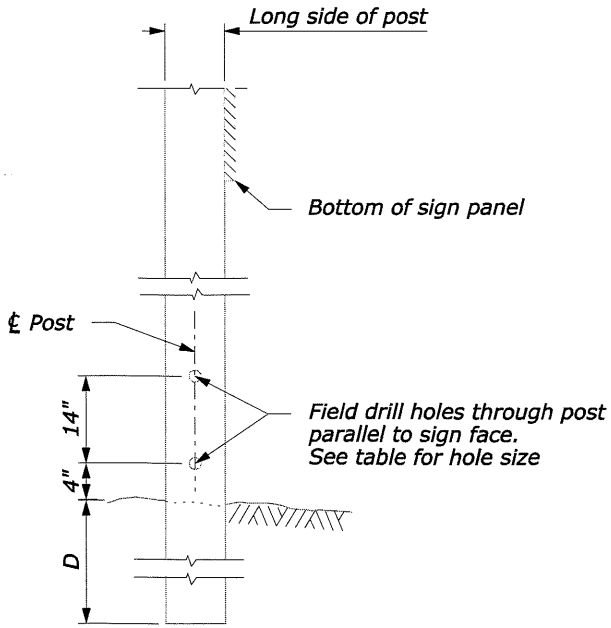

**POST DETAIL**

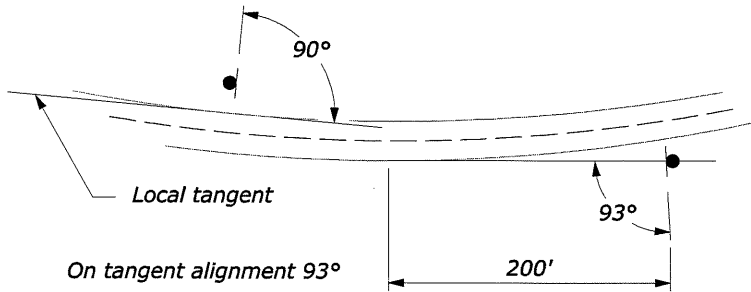

**SIGN INSTALLATION ANGLE**

U.S. DEPARTMENT OF TRANSPORTATION FEDERAL HIGHWAY ADMINISTRATION FEDERAL LANDS HIGHWAY	
U.S. CUSTOMARY STANDARD <b>TEMPORARY TRAFFIC CONTROL SIGN INSTALLATION WOOD POSTS</b>	
STANDARD APPROVED FOR USE 6/2005	STANDARD
REVISED: DRAFT: 9/2011	635-14

NO SCALE



Schedule A &  
Schedule B

Schedule C

ITEM 63302-0000 SIGN SYSTEM							
Sign Number	MUTCD Number	Location		Description	Sign size (in x in)	Number of signs	Quantity (SQFT)
		Station	Side				
1	R2-1	9+96	LT	Speed Limit 20	24 x 30	1	5.00
2	R2-1	9+96	RT	Speed Limit 35	24 x 30	1	5.00
3	R1-1	80+40	LT	Stop	30 x 30	1	6.25
4	R1-1	118+87	LT	Stop	30 x 30	1	6.25
5	R2-1	206+50	LT	Speed Limit 35	24 x 30	1	5.00
6	R2-1	206+50	RT	Speed Limit 20	24 x 30	1	5.00
7	S1-1	207+50	RT	School	36 x 36	1	6.75
8	R1-1	209+36	LT	Stop	30 x 30	1	6.25
9	S1-1	220+00	LT	School	36 x 36	1	6.75
10	S1-1	220+75	LT	Speed Limit 20	24 x 30	1	5.00
11	R1-1	221+58	LT	Stop	30 x 30	1	6.25
	D3-1			Weary River Rd	42 x 8	2	4.67
Schedule A Total							68.17
Schedule B Total							68.17
Schedule C Total							51.92

Schedule A &  
Schedule B

Schedule C

ITEM 20301-2400 REMOVAL OF SIGNS			
Location		Sign Legend	Quantity (EACH)
Station	Side		
7+40	LT	Speed Limit 20	1
17+80	RT	Watch for Children	1
77+80	RT	Y Intersection	1
80+88	LT	Stop	1
119+32	LT	Stop	1
123+13	LT	Intersection RT	1
216+55	LT	Speed Limit 35	1
Schedule A Total			7
Schedule B Total			7
Schedule C Total			3

Did not exist.

TABULATION OF PERMANENT TRAFFIC CONTROL QUANTITIES

7/2012 7/2012 7/2012 06-Sep-2012 03:04 PM ...\\dc008pa.dgn

B. Wacker


N. Bell

Checked by:

Designed by:

STATE	PROJECT	SHEET NUMBER
AK	DEN 2009(8)	J.2

**BEGIN PROJECT AK DEN 2009(8)  
MANOKOTAK HEIGHTS  
ROAD RECONSTRUCTION  
BEGIN SCHEDULES A & B  
1+50.00**

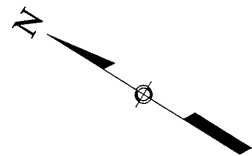

Remove sign  
7+40 LT



9+96 LT ①  
R2-1



Replace ②  
9+96 RT  
R2-1

Remove sign  
17+80 RT



**SIGNING PLANS  
1+50 TO 55+00**

7/2012 7/2012 7/2012 06-Sep-2012 03:05 PM ...\\dc0906ph.dgn


B. Wacker

Checked by:

N. Bell

Designed by:

STATE	PROJECT	SHEET NUMBER
AK	DEN 2009(8)	J.3

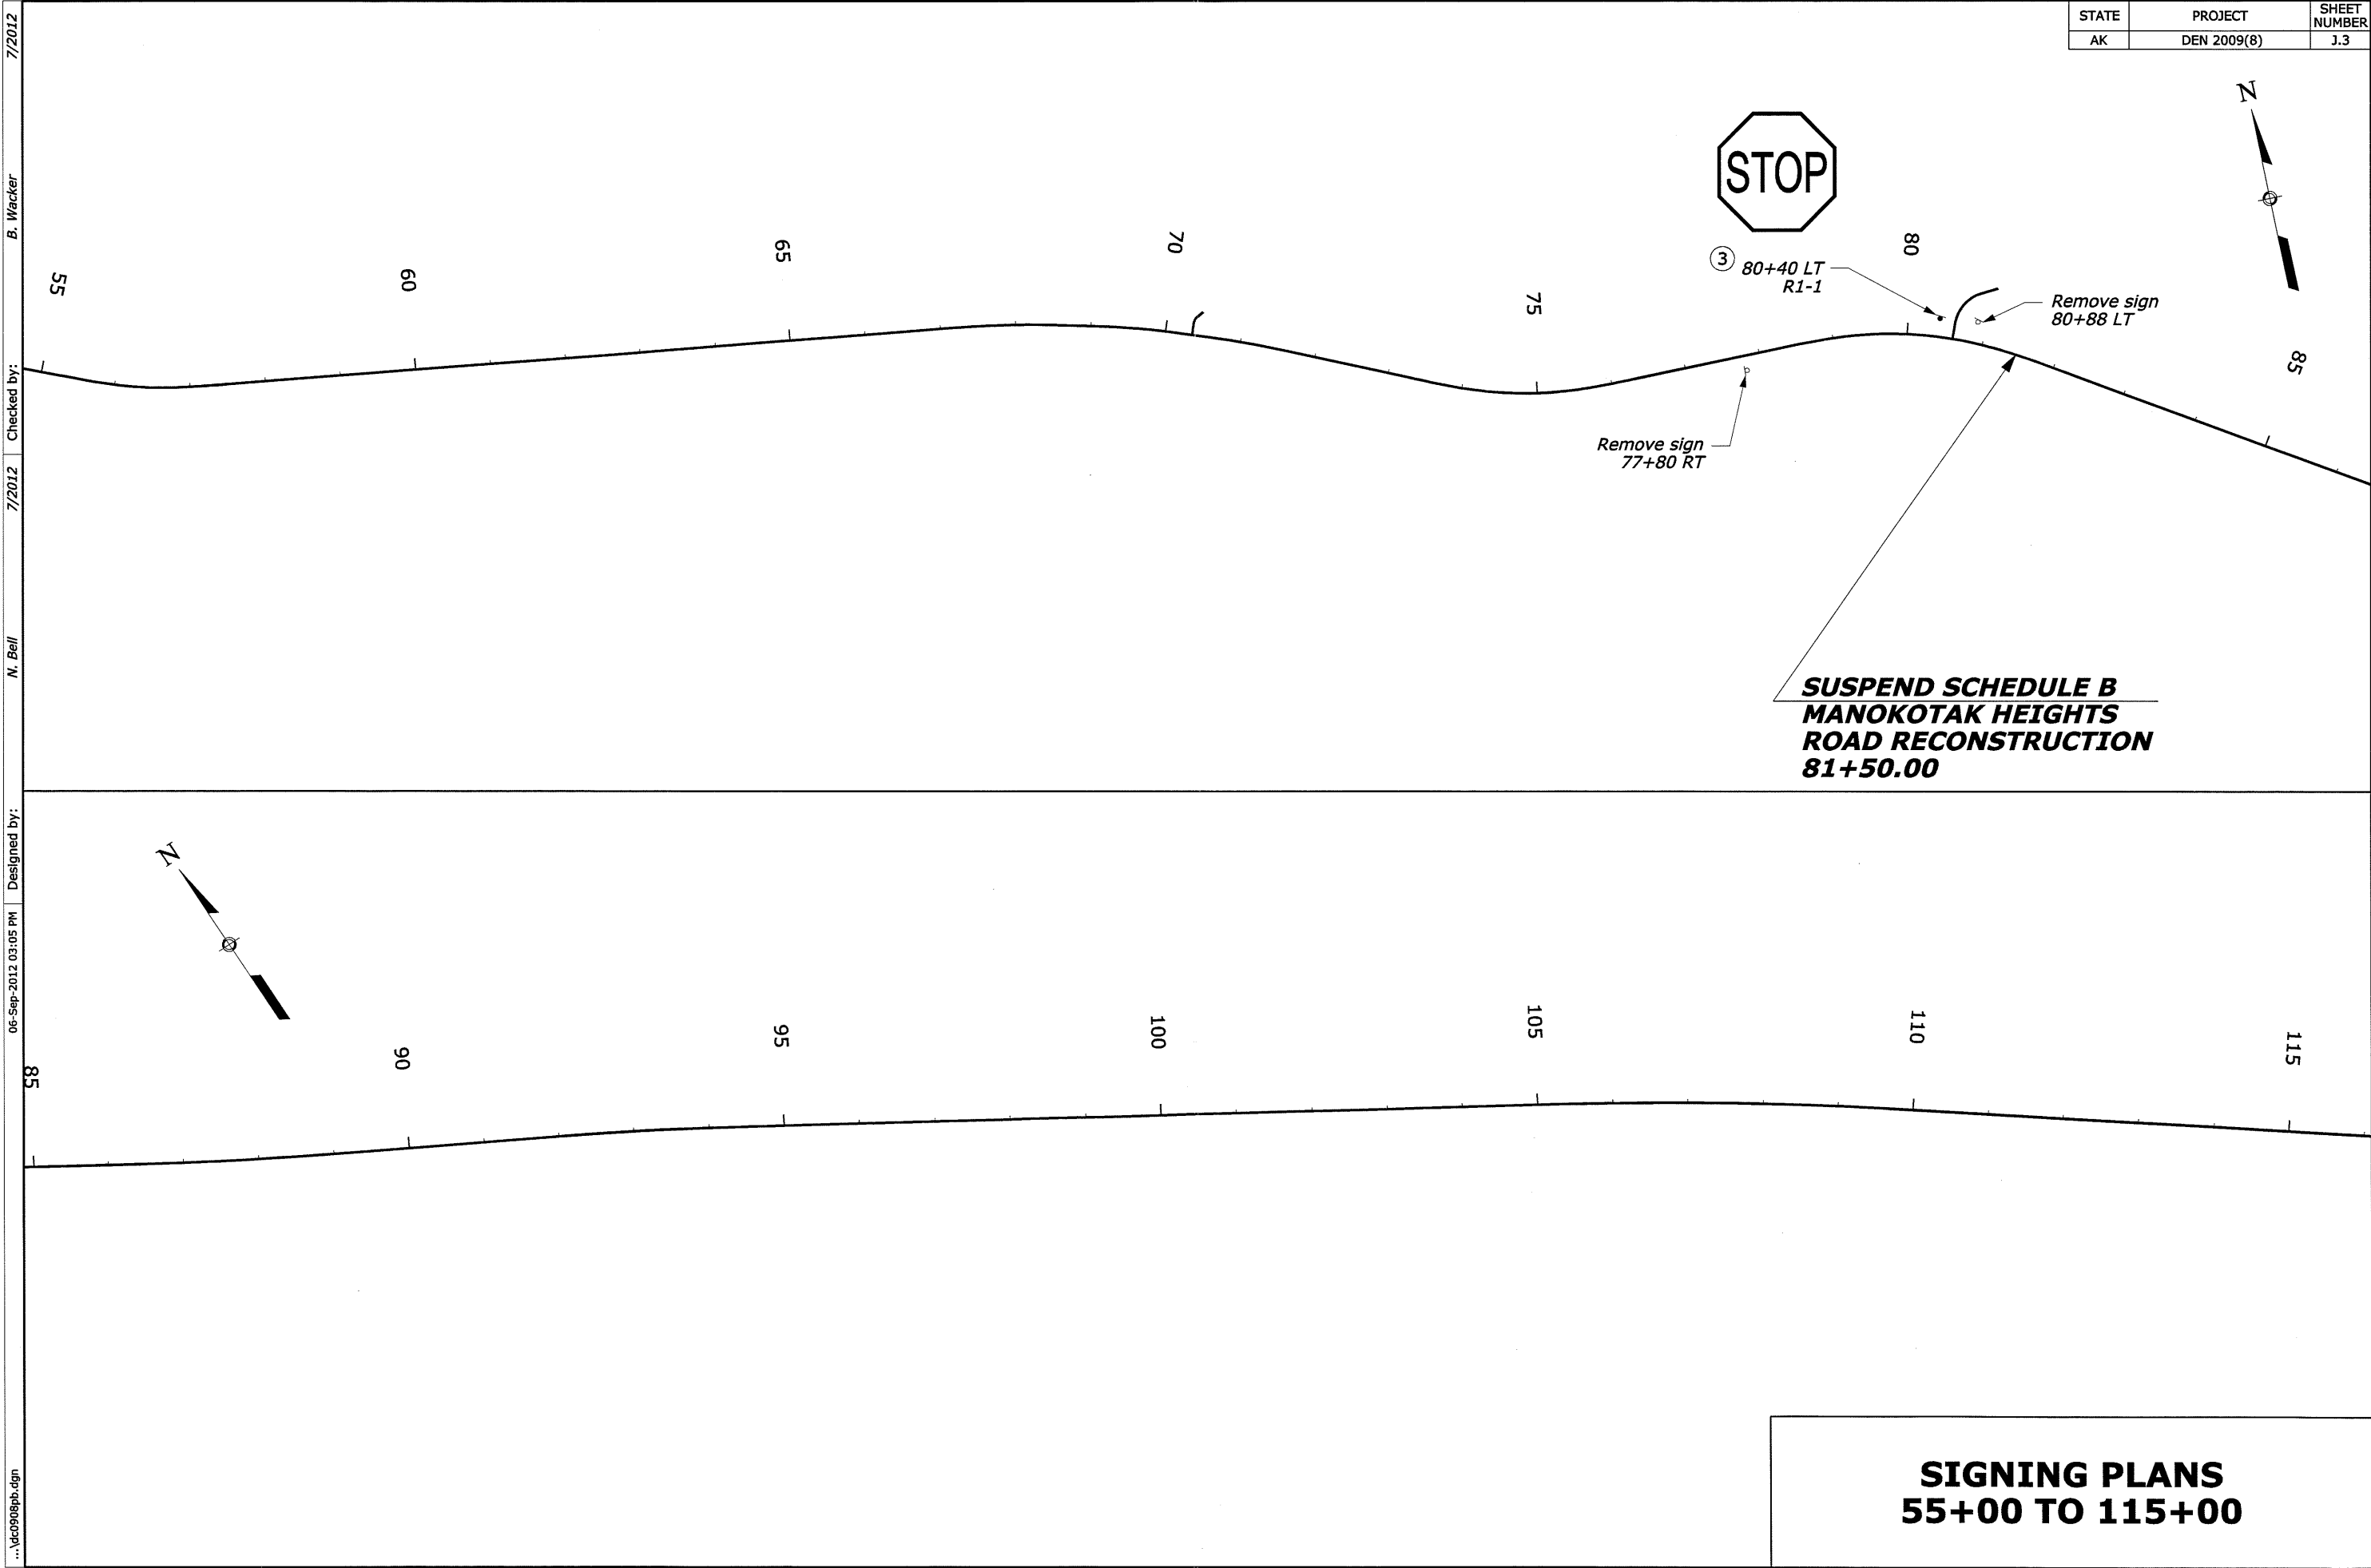


**SIGNING PLANS  
55+00 TO 115+00**






STATE	PROJECT	SHEET NUMBER
AK	DEN 2009(8)	J.5

7/2012  
B. Wacker  
7/2012  
N. Bell  
06-Sep-2012 03:08 PM  
Designed by:  
...\\dc0909end.dgn

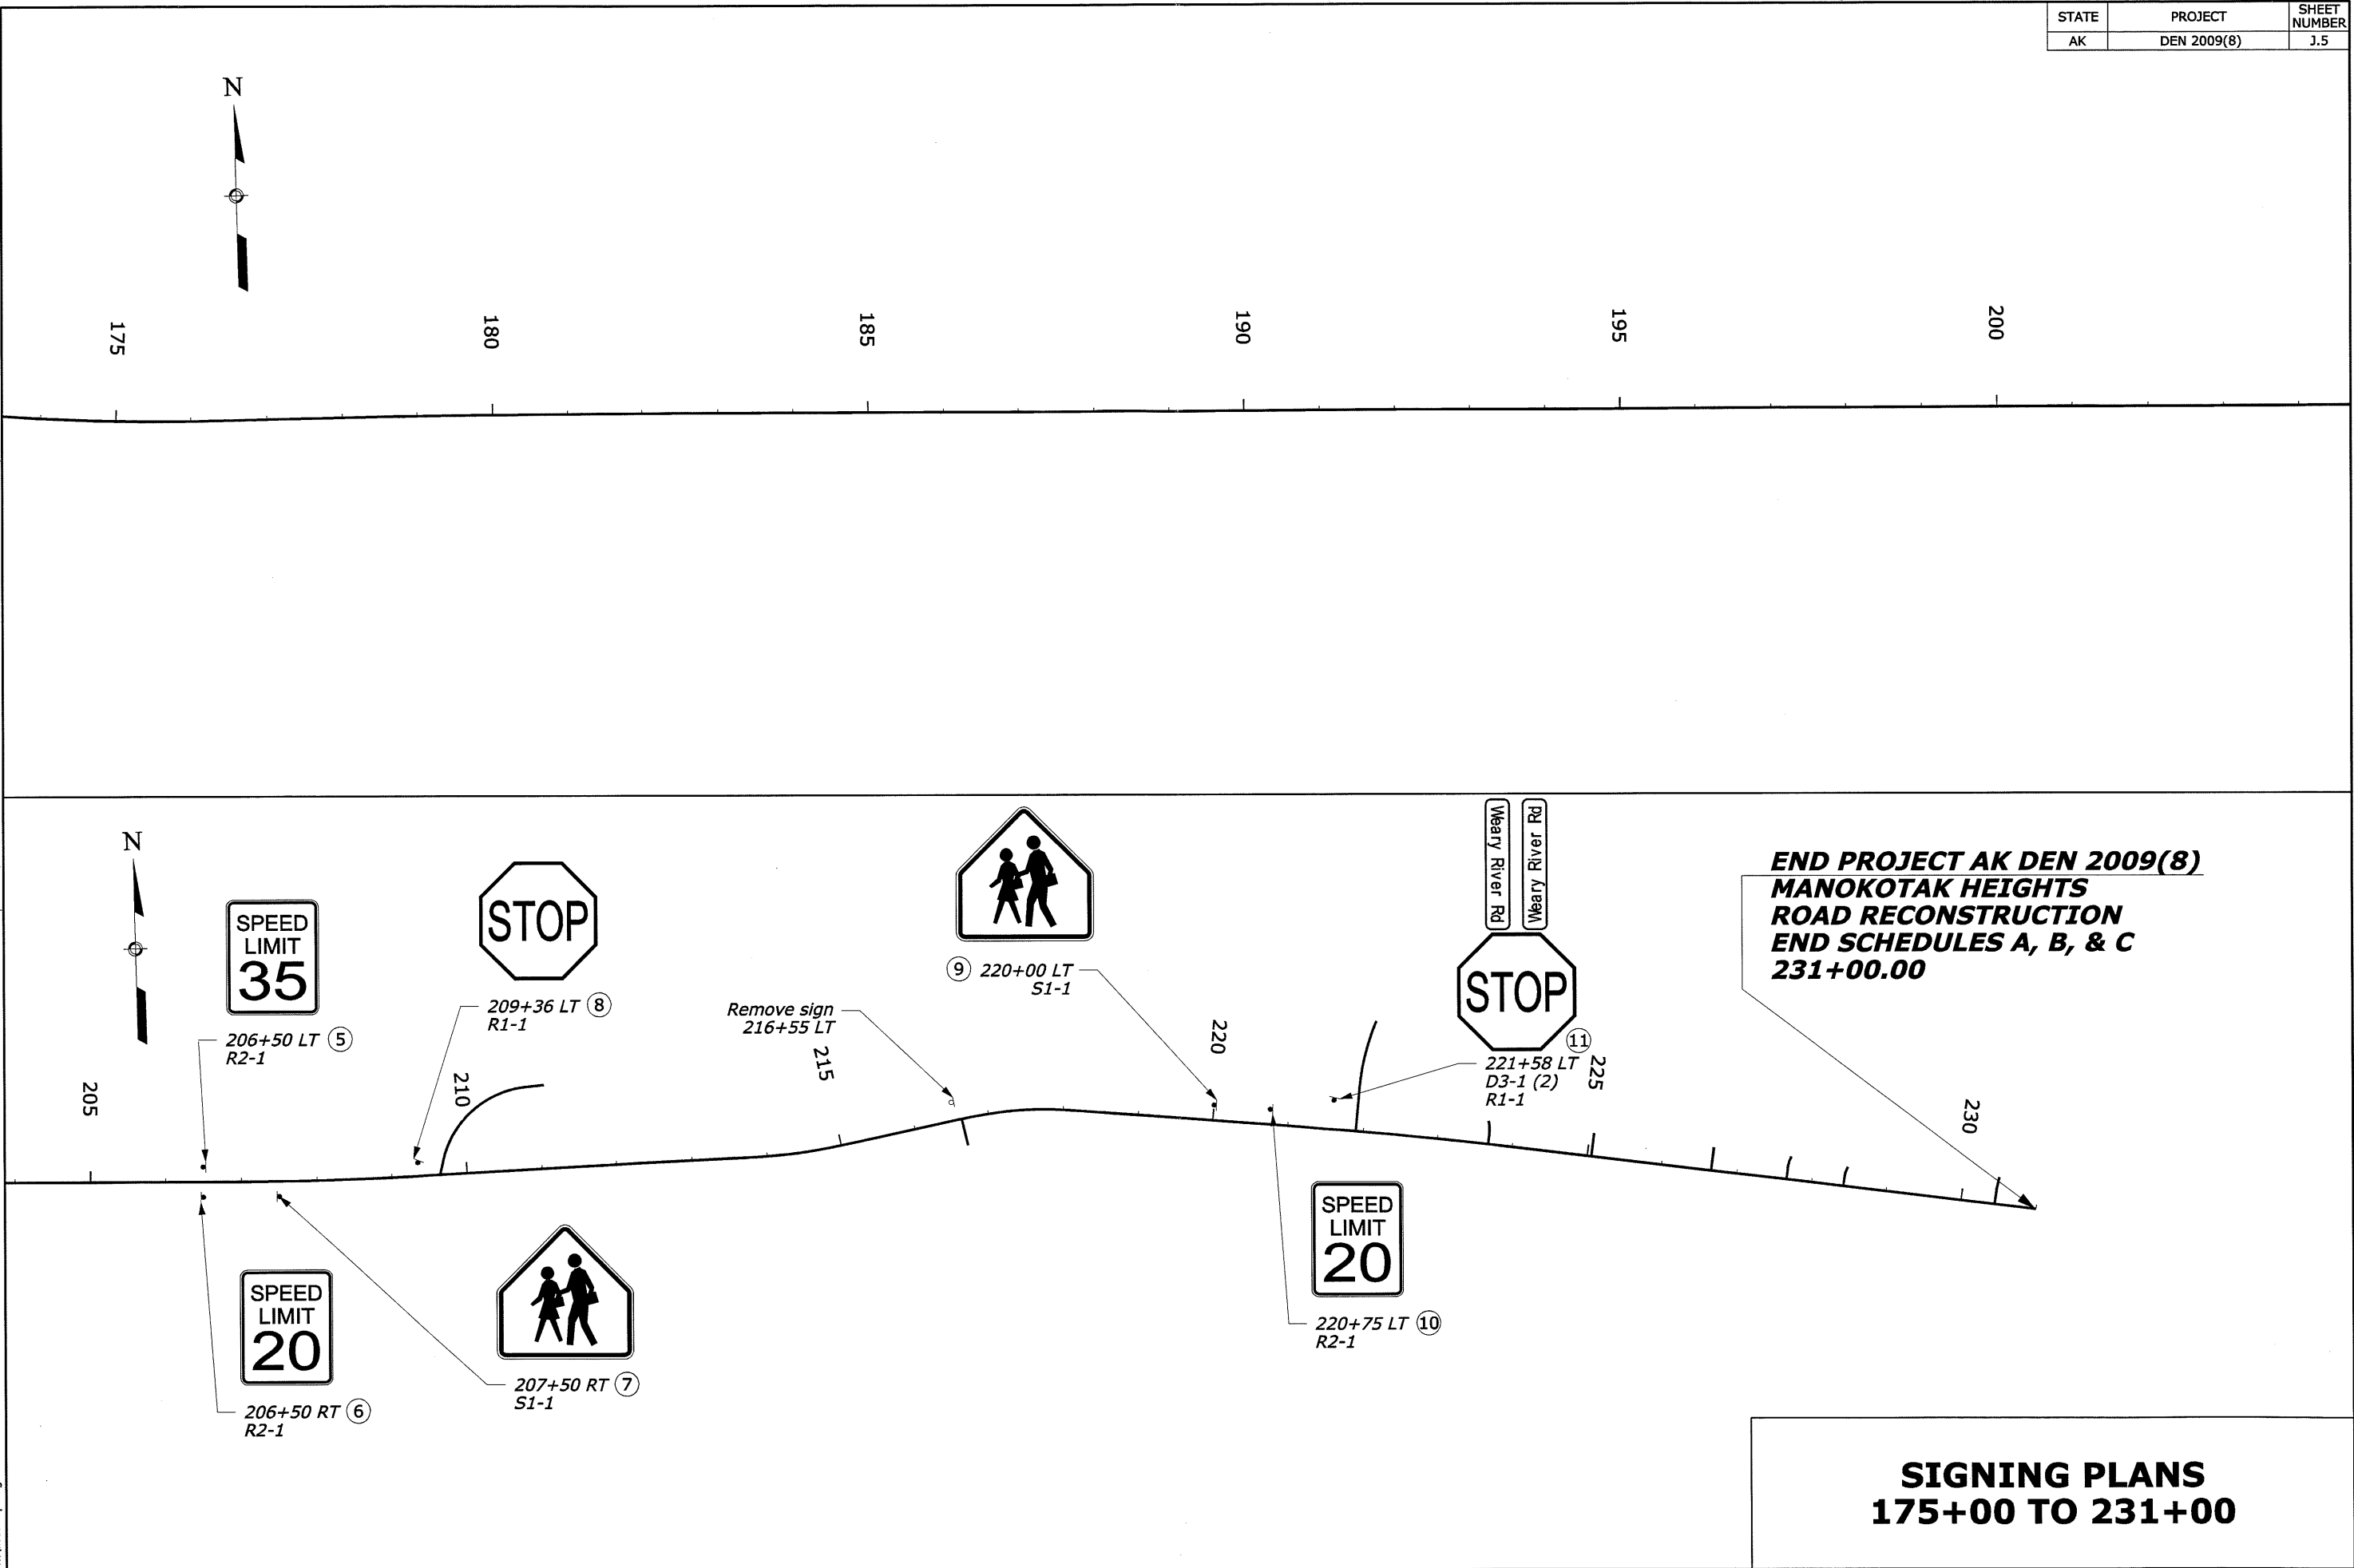

STATE	PROJECT	SHEET NUMBER
AK	DEN 2009(8)	J.6

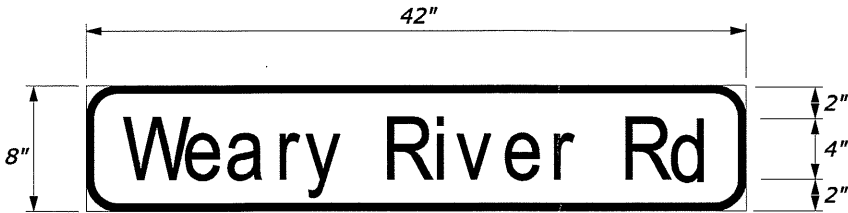


11 221+58 LT  
D3-1


- NOTE:
1. Sign has a white reflectorized legend and green reflectorized background.
  2. Use letter series C font and standard letter spacing for legend.

PERMANENT SIGN  
DETAILS




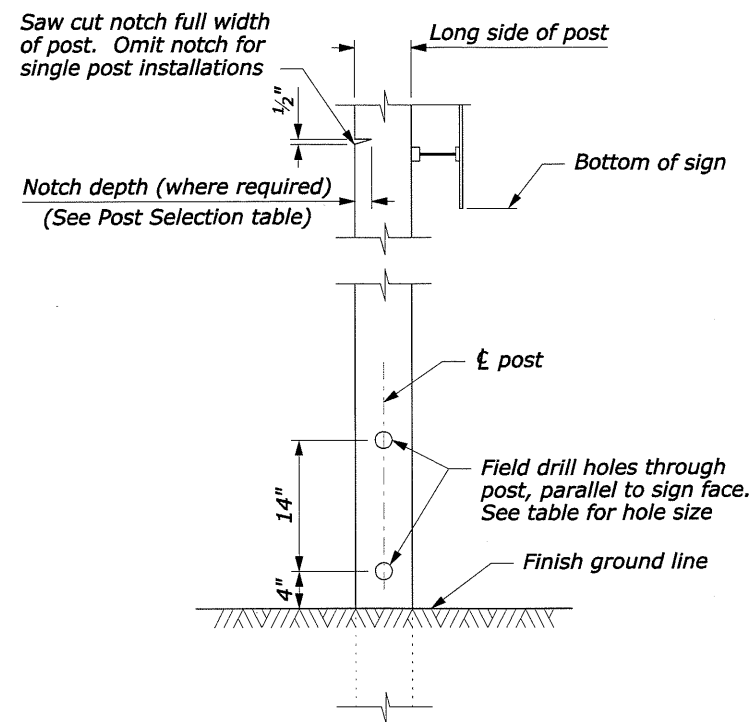


POST DETAIL

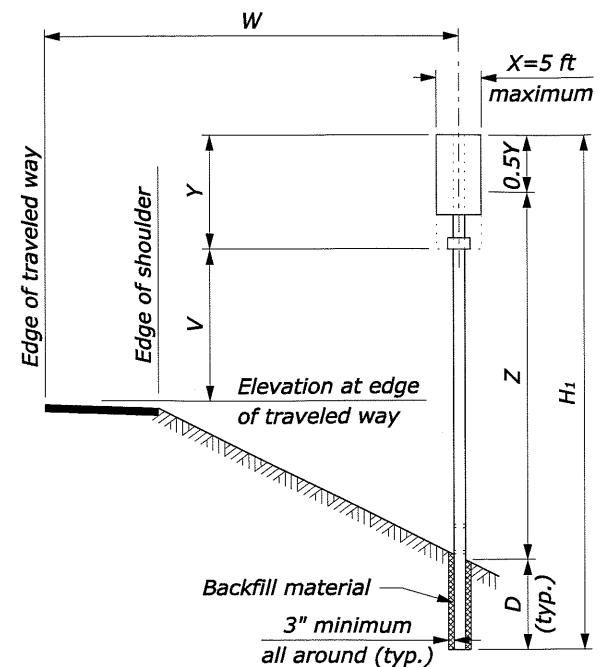

SINGLE POST SIGNS

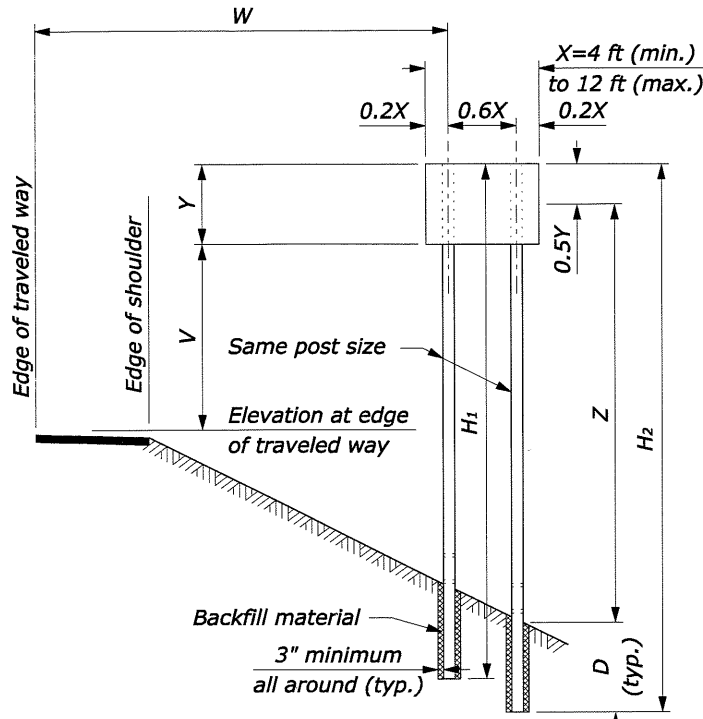


TWO POST SIGNS

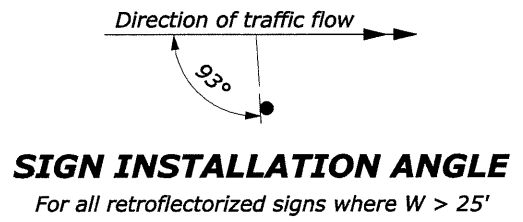


MINIMUM DISTANCE TO SIGN		
Location	Lateral Offset (W)	Mounting Height (V)
Rural Districts	6 ft	5 ft
Business or Residence Districts	2 ft from curb	7 ft

V may be reduced by 1 foot in rural districts for a secondary sign mounted below another sign.

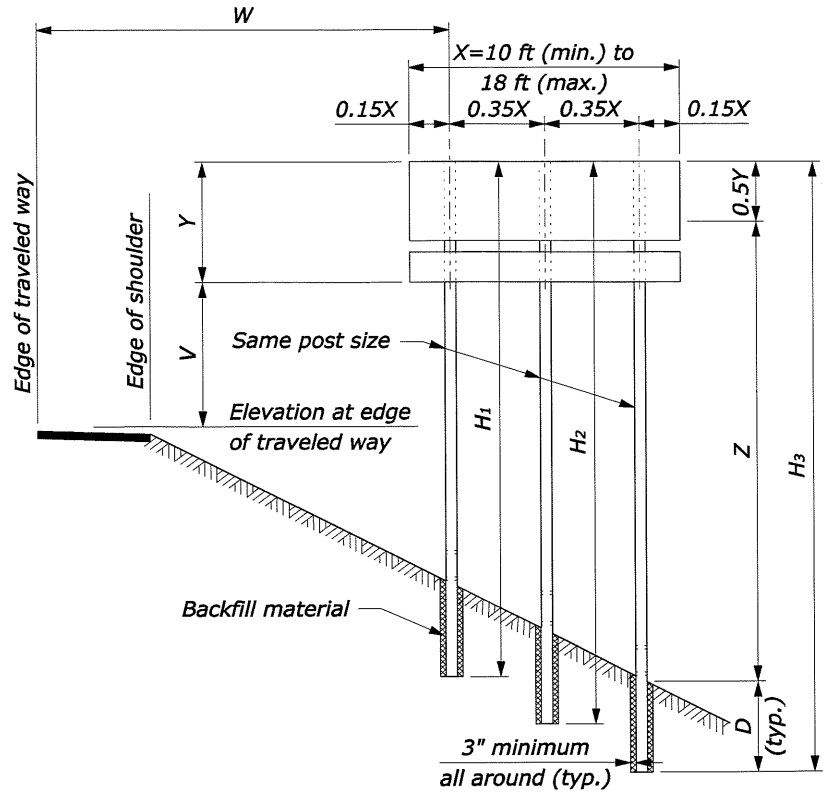


THREE POST SIGNS

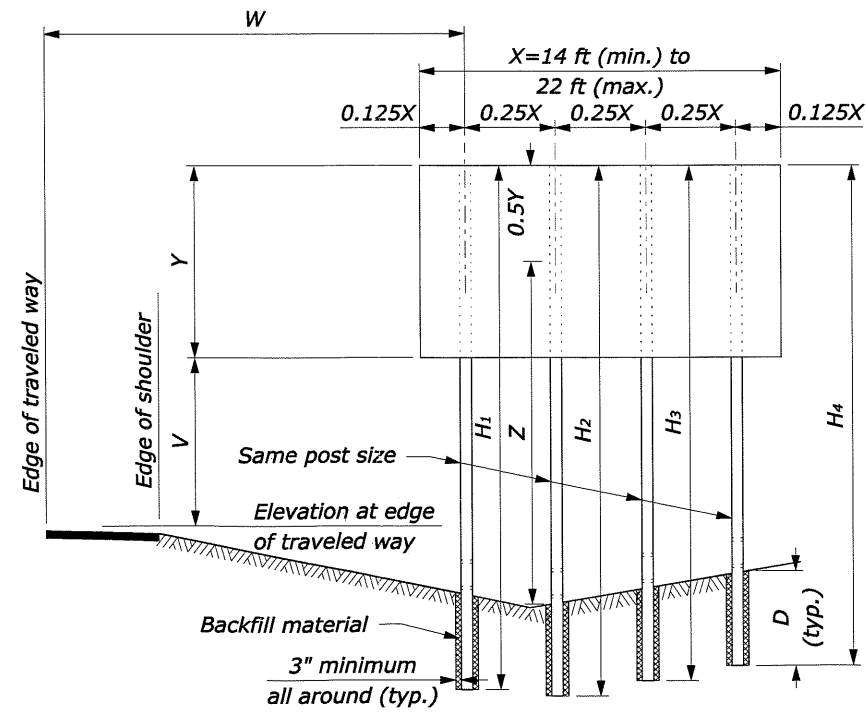

FOUR POST SIGNS

NOTE:

1. Traffic barrier protection is required for all posts larger than 6" x 8" when located within the clear zone or if the post is vulnerable to being struck when placed outside the clear zone.
2. H<sub>1</sub> thru H<sub>4</sub> indicate overall post length. Select post lengths to fit field conditions.
3. D is the minimum post embedment depth for average soil conditions. See Wood Post Selection Table below.
4. Z is the height from ground line to mid-height of sign at the longest post.
5. For the purpose of post selection X and Y are as follows:
  - Single sign, or back to back signs: X and Y are the overall dimensions of the signs.
  - Multiple sign installations: X and Y are the dimensions of a rectangle enclosing all the signs.

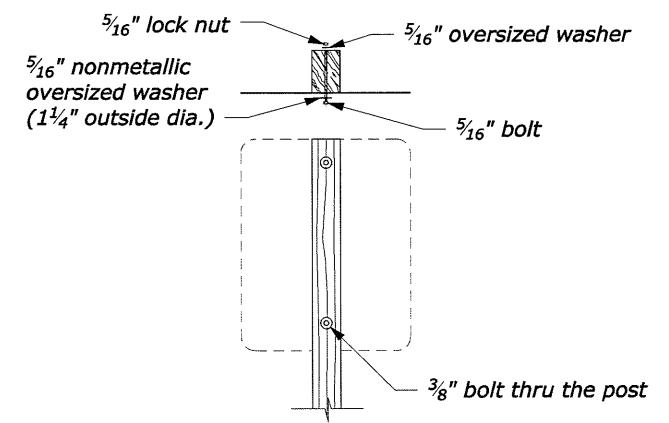

TYPICAL MOUNTING FOR SIGNS WITHOUT ANGLES

WOOD POST SELECTION TABLE						
POST SIZE (inch)	NUMBER OF POSTS				D	Notch depth and hole diameter
	1	2	3	4		
	Product of X-Y-Z in CUFT					
4 x 4	80	155	235	310	3'-0"	-
4 x 6	180	385	545	725	4'-0"	1¾"
6 x 6	235	475	710	950	4'-0"	1¾"
6 x 8	300	850	1280	1700	4'-0"	2½"
6 x 10	385	1180	1170	2360	5'-0"	-
8 x 10	575	1610	2410	3215	5'-0"	-
8 x 12	775	2310	3465	4620	6'-0"	-


Values shown are the maximum permitted. If the product of XYZ exceeds the limit for the largest post, use steel post installation.

U.S. DEPARTMENT OF TRANSPORTATION FEDERAL HIGHWAY ADMINISTRATION WESTERN FEDERAL LANDS HIGHWAY DIVISION	
U.S. CUSTOMARY DETAIL <b>PERMANENT SIGN INSTALLATION WOOD POSTS</b>	
DETAIL APPROVED FOR USE --/----	DETAIL W633-7
REVISED: 2/1998 DRAFT: 10/2009	


NO SCALE

7/2012 B. Wacker 7/2012 Checked by: 7/2012 N. Bell 13-Sep-2012 08:15 AM Designed by: ...Typical Sections\dc908cb.dgn


STATE	PROJECT	SHEET NUMBER
AK	DEN 2009(8)	C.3

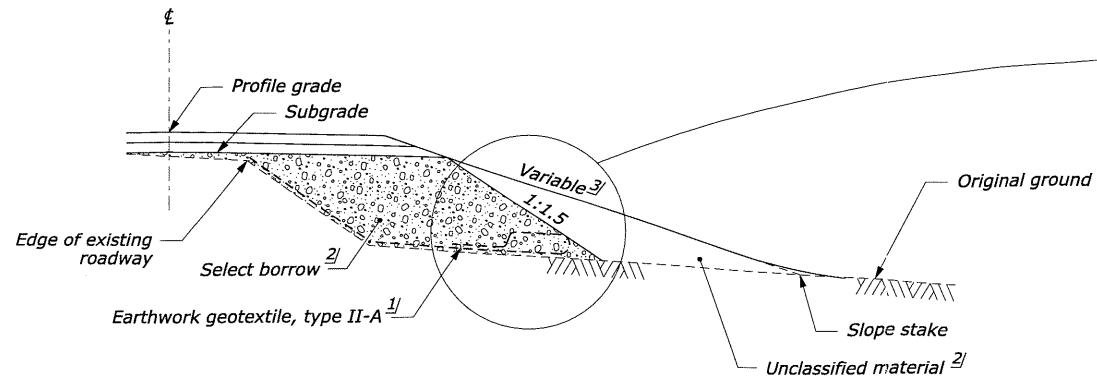


EMBANKMENT CONSTRUCTION DETAIL

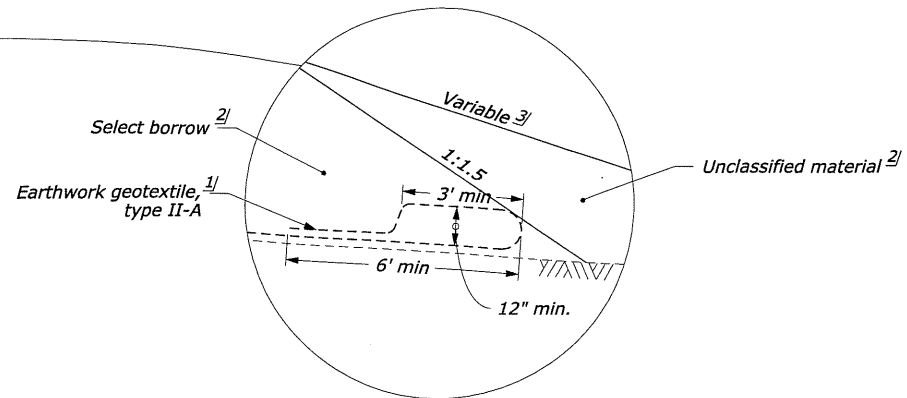

EARTHWORK GEOTEXTILE END WRAP DETAIL

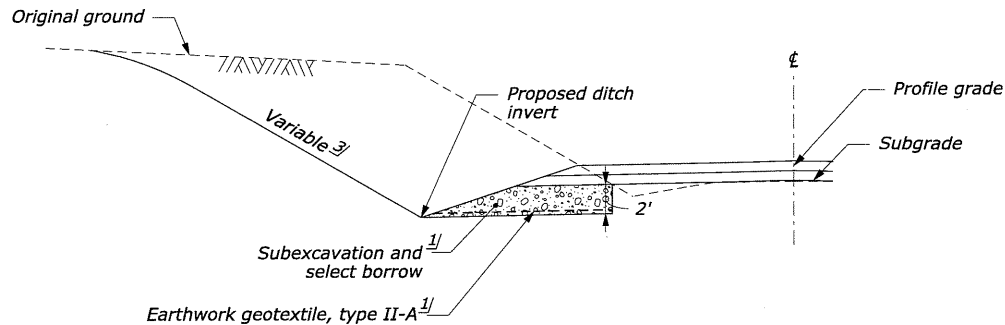

SUBEXCAVATION, TYPE 1 DETAIL

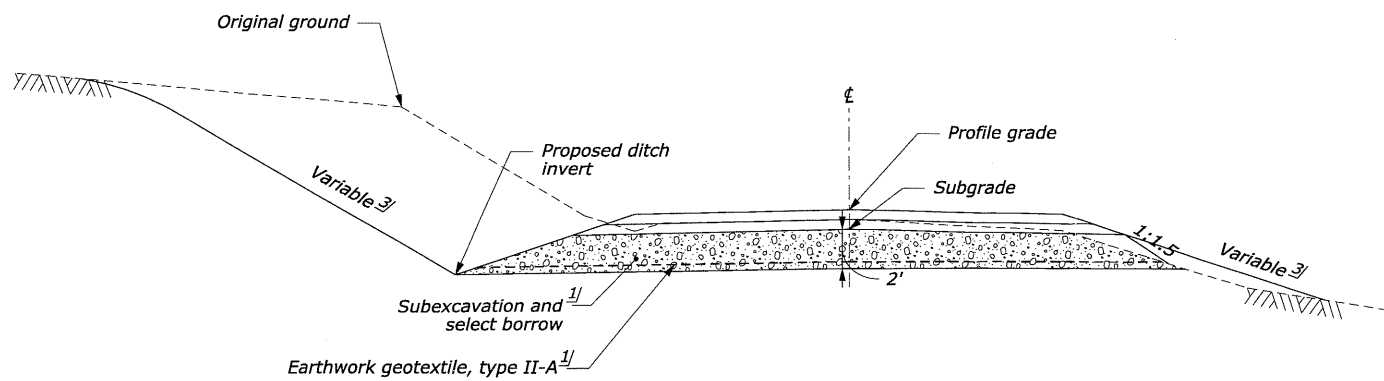

SUBEXCAVATION, TYPE 2 DETAIL

NOTE:

1. See mainline typical section for proposed surfacing structure.
2. Mirror details as appropriate.

FOOTNOTE:

- 1/ See Sheet C.1 for locations and quantities.
- 2/ See Sheet D.1 for quantities.
- 3/ Construct slopes as shown in the Staking Report.

Sheet added by Amendment A001

NO SCALE

SUBEXCAVATION AND EMBANKMENT CONSTRUCTION DETAILS